


No. 819

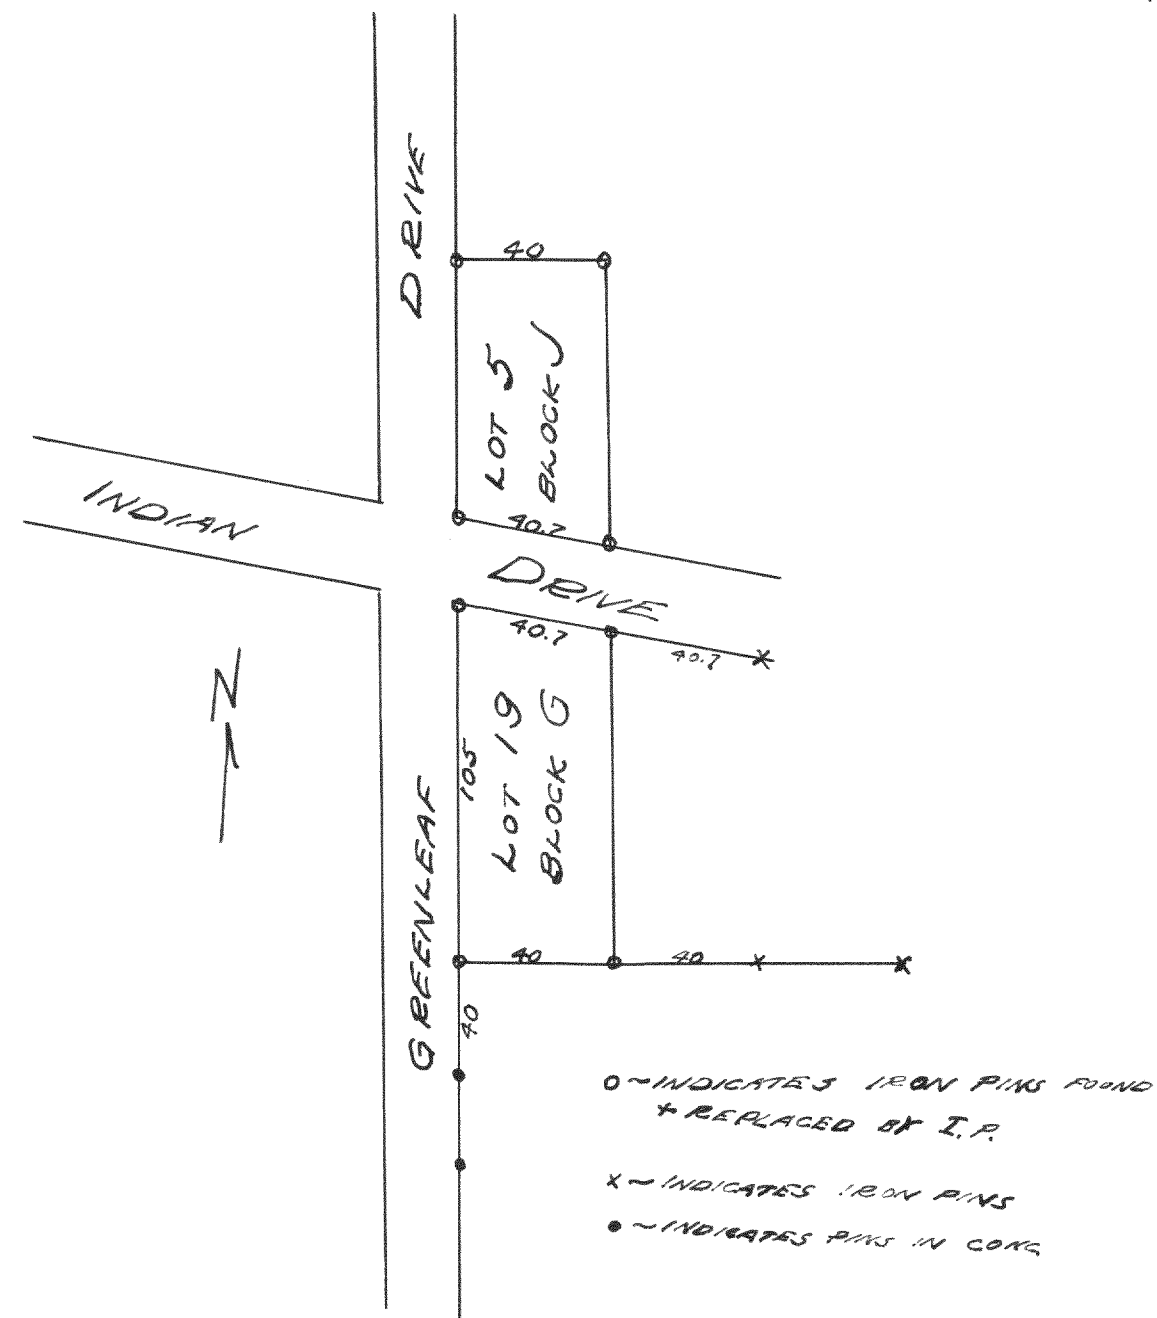


Survey of lot 19 block G and lot 5, block J.  
of Cisco Beach Subdivision.

Aug. 1937

Lloyd L. Jensen  
by H. E. J.

No. 820

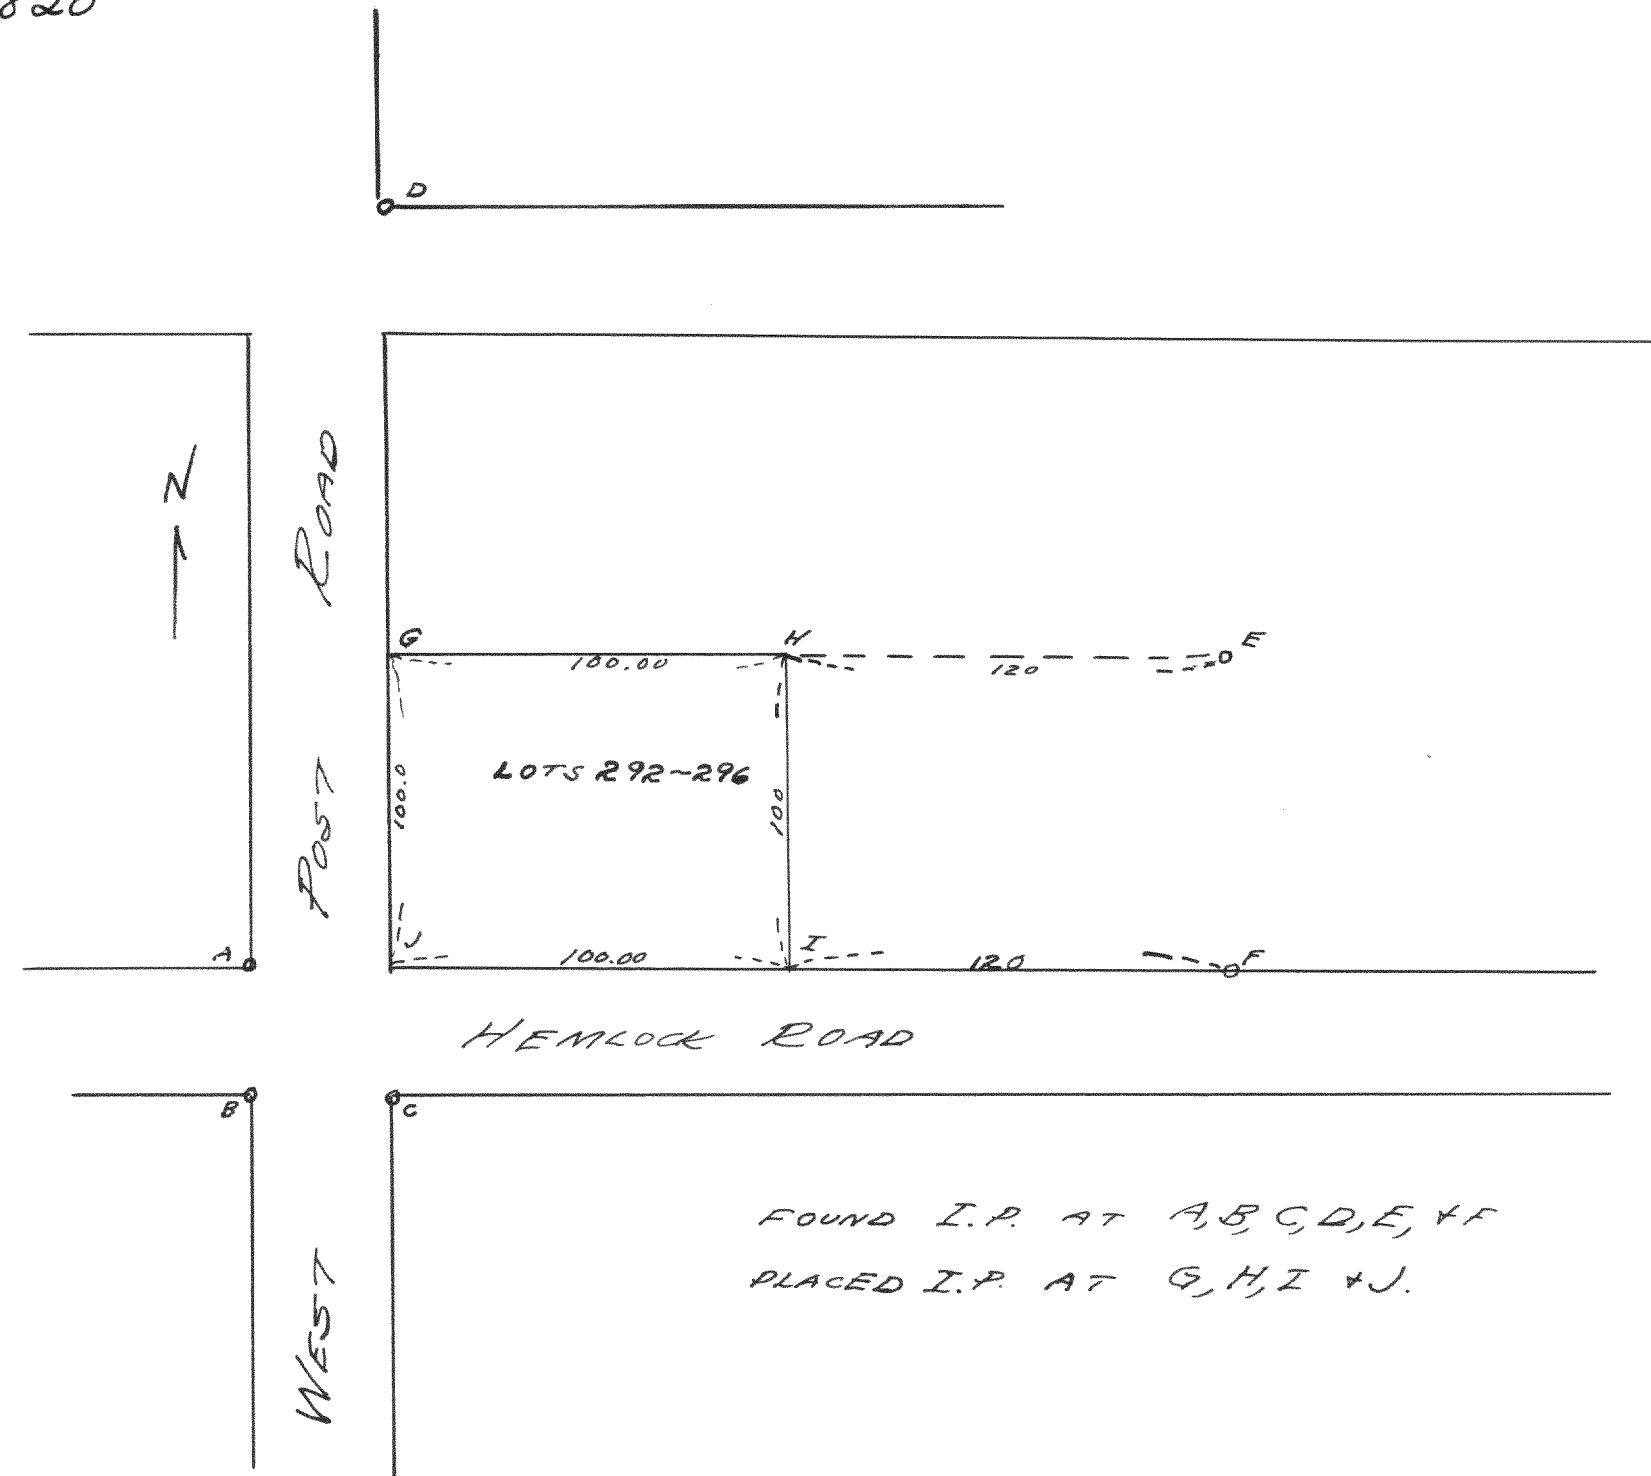

Survey of lots 292-296, inclusive, of Pell Lake  
Subdivision

Aug. 1937

Lloyd L. Jensen  
by H. E. J.