



No. 865

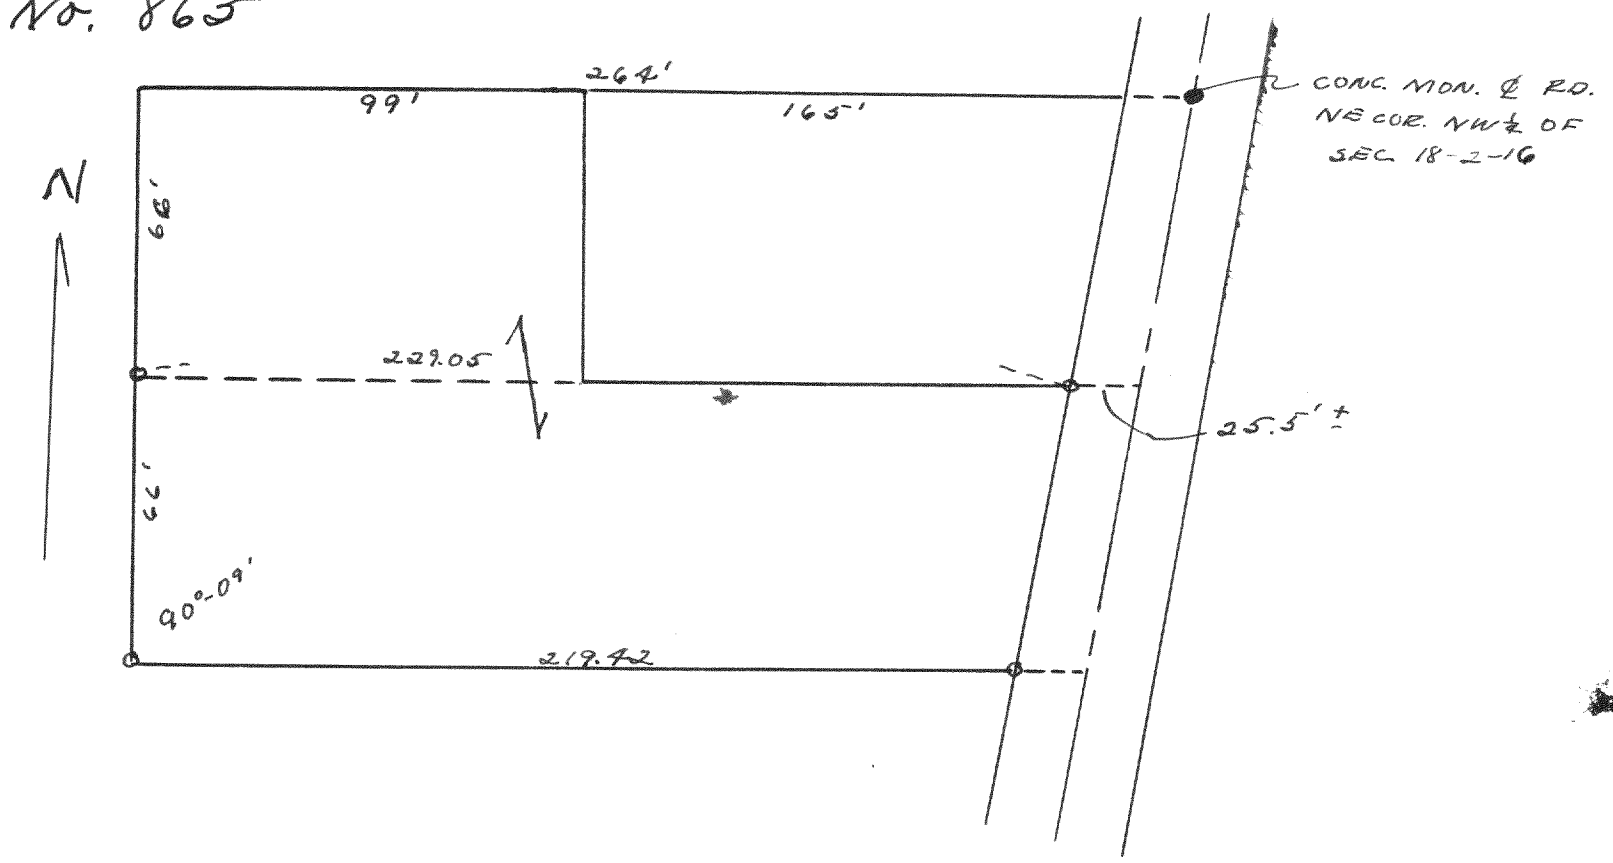

Survey of part of NW 1/4 18-2-16


June 6, 1937
No. 866

Lloyd L. Jensen
by K.E.J.

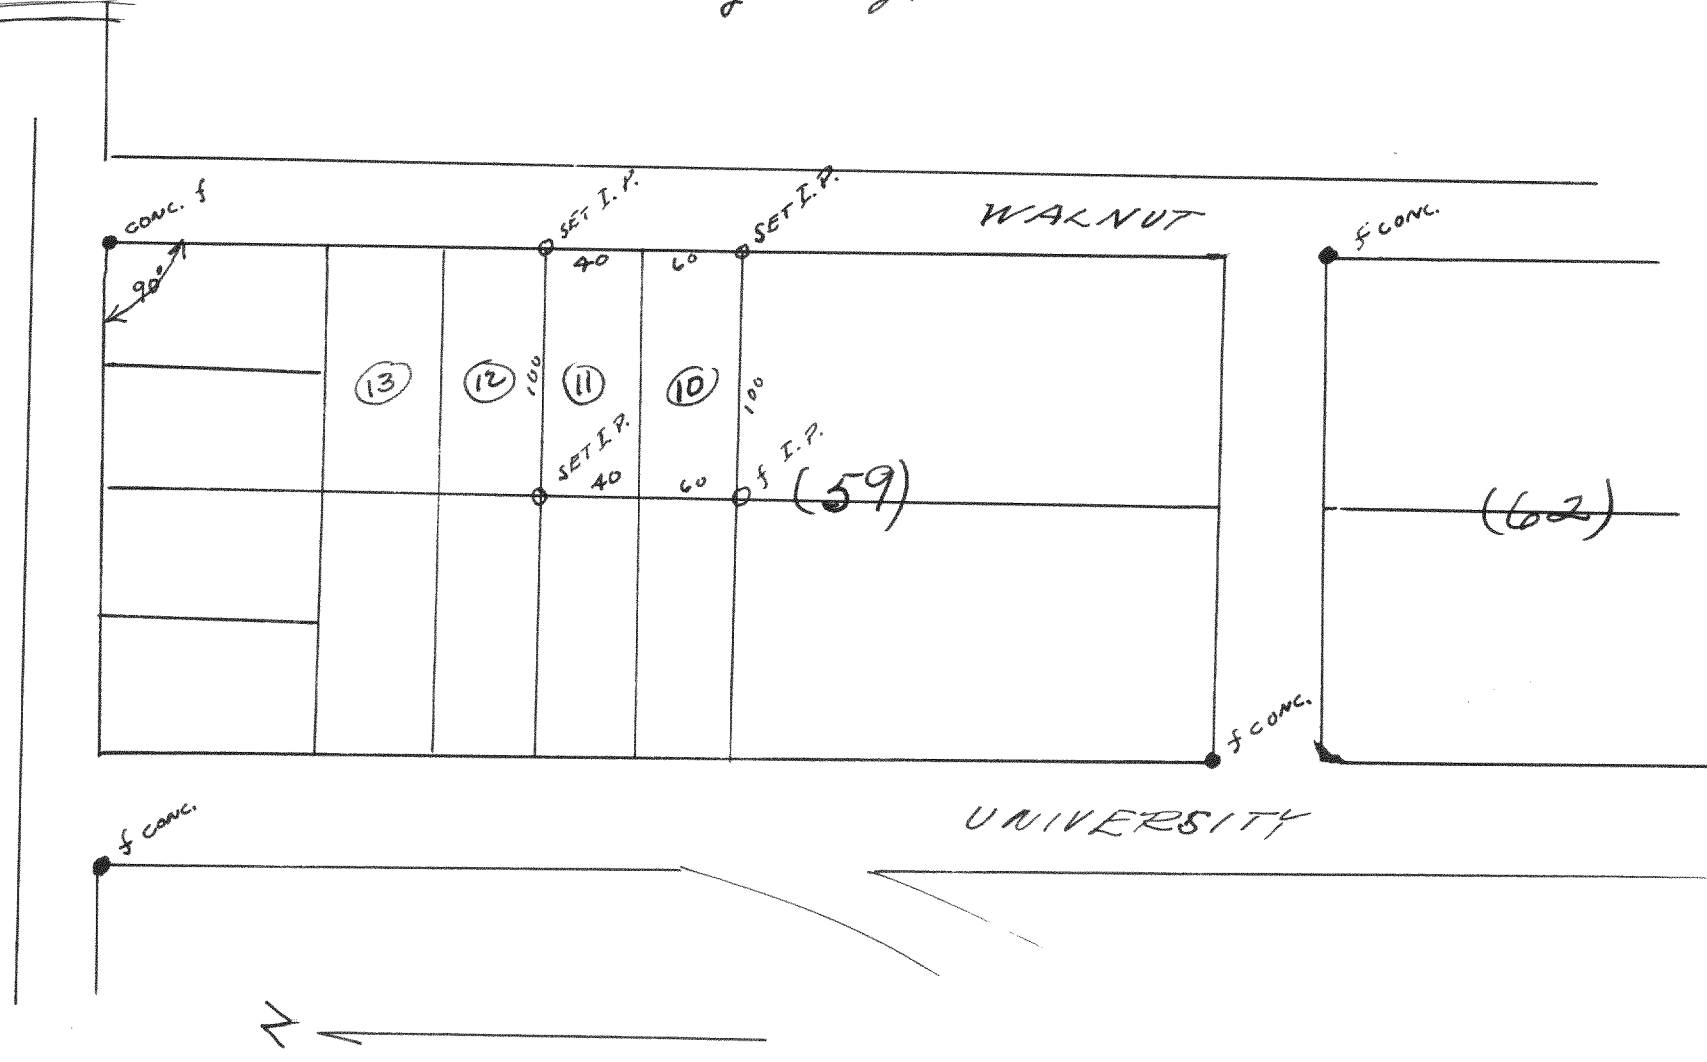


Survey of lots 10 & 11 of Rb. 59 of 4th map of Interlaken
April 12, 1937
Lloyd L. Jensen
by K.E.J.

No. 867

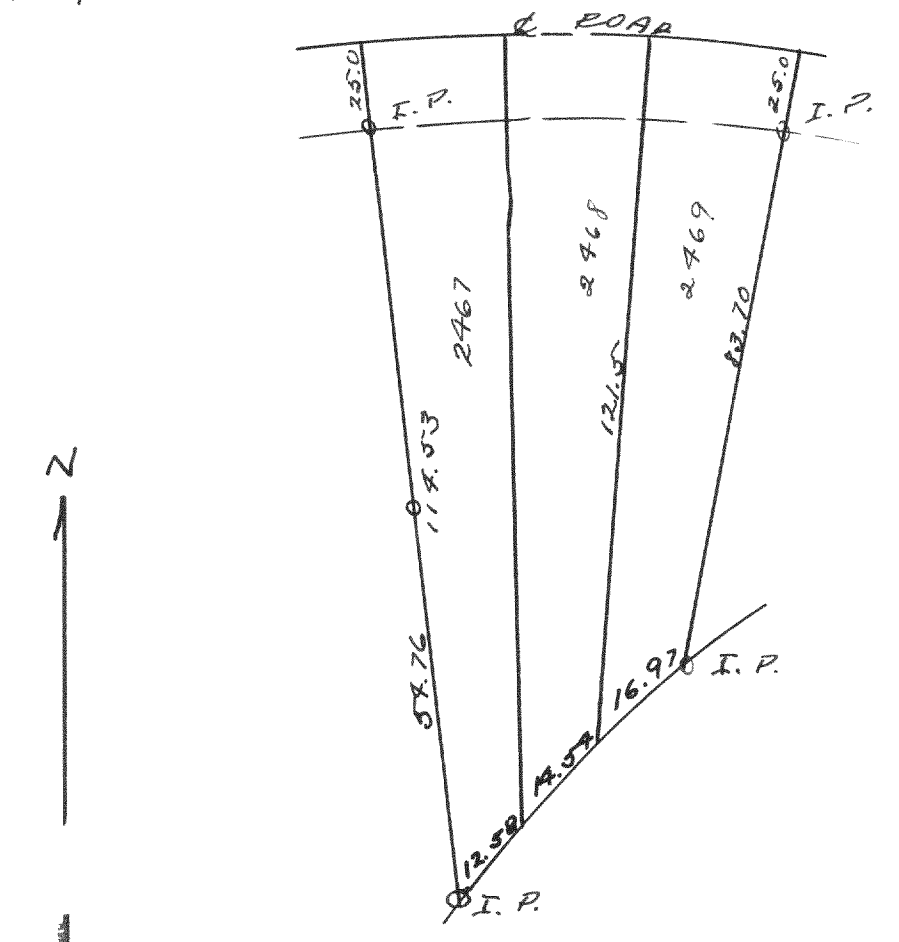

Plat of survey of lots 2467, 2468 and 2469 of the unrecorded plat of Interlaken subd. now being known as lot 32 of the recorded plat of the 4th map of Interlaken.
Lloyd L. Jensen
by K.E.J.
November 1937

No. 868

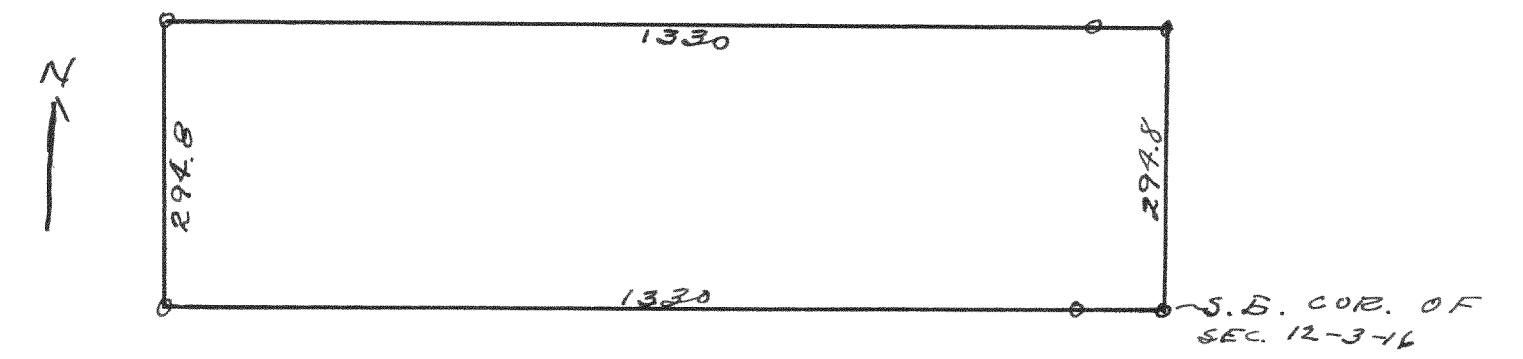

Survey to locate the bounds of 9 acres in the south end of the E 1/2 of the SE 1/4 of section 12-3-16 - no section corners were found, hence lines were used for the work.

March 1937
Lloyd L. Jensen
by K.E.J.