


No. 872

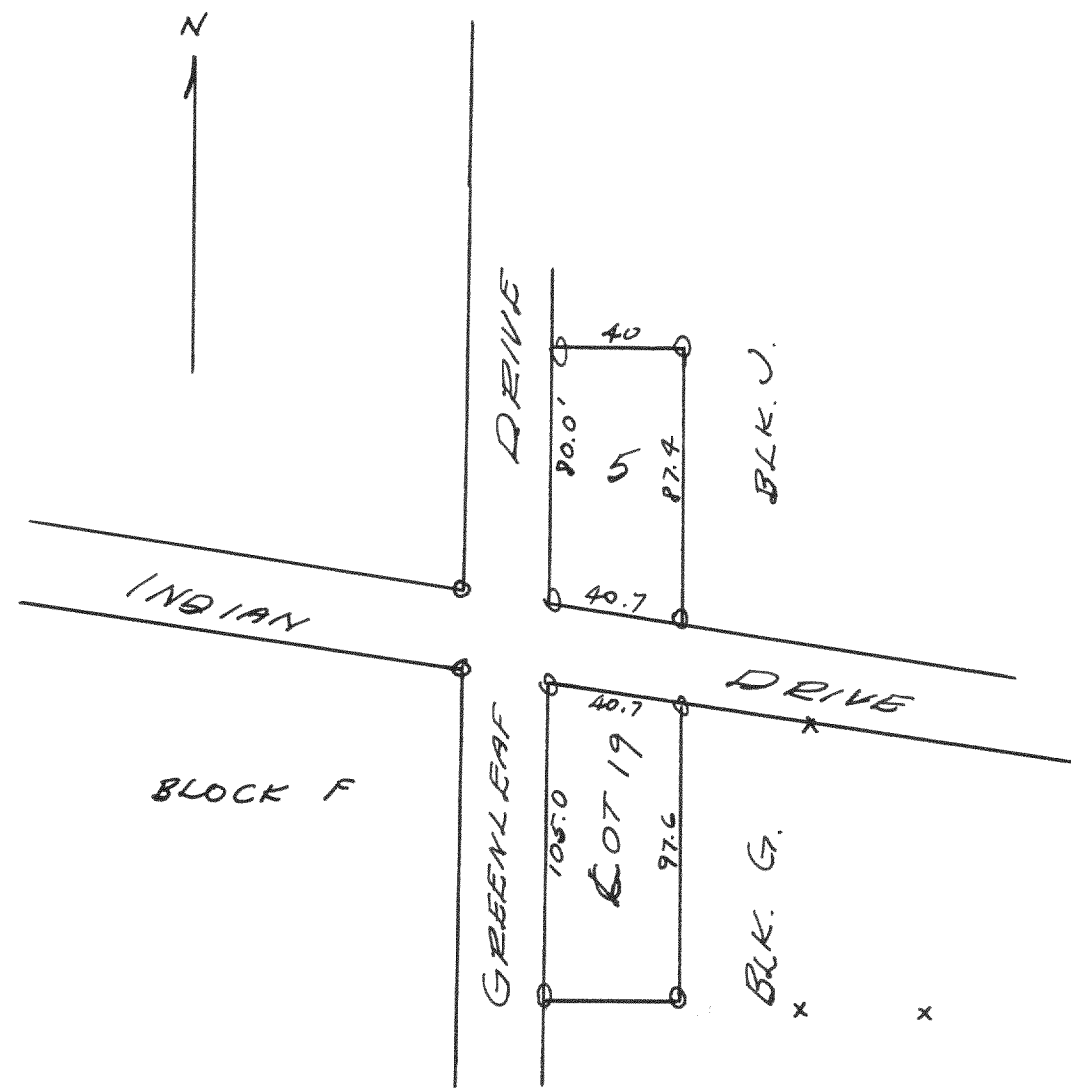


Survey of lot 19 blk. G and
lot 5 blk. J. of Cisco Beach
Subd. sec. 5-1-17

Aug. 27, 1938

Lloyd Jensen
by H.E.G.

No. 873

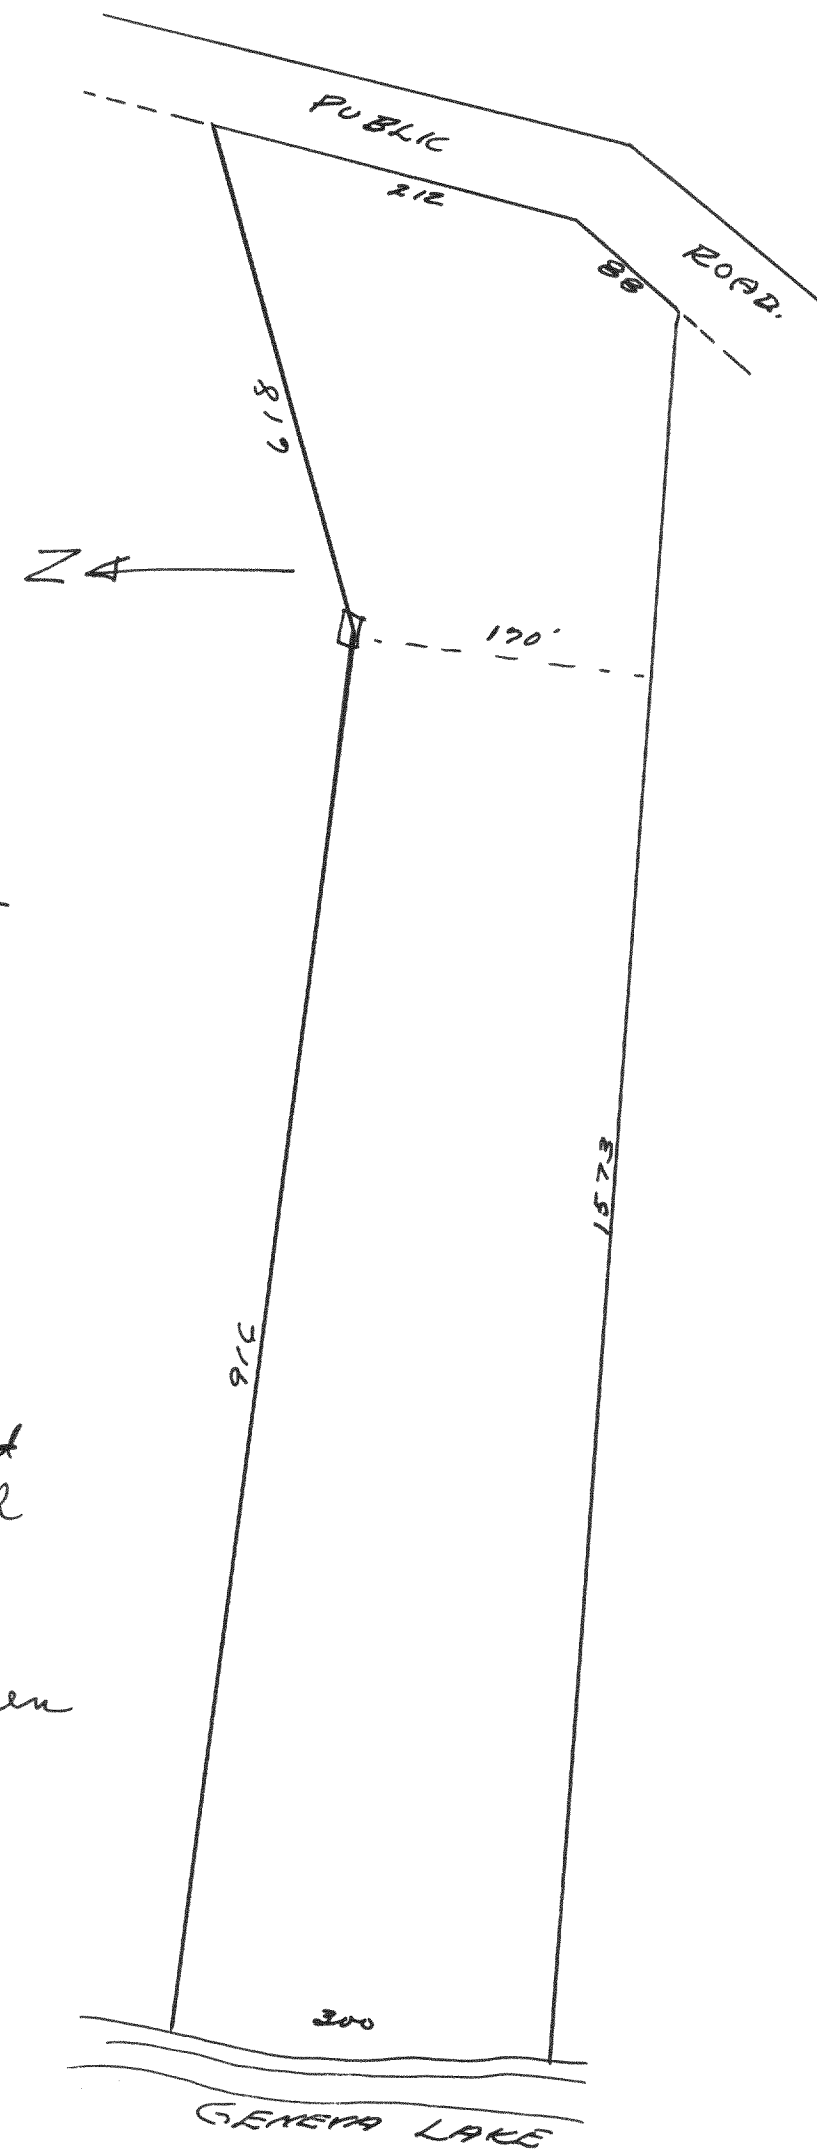

Survey of land in sec 1-1-17

March 16, 1938

Lloyd L. Jensen
by H.E.G.

No. 874



Survey of lot 8 Elgin Club -
formerly lot 8 of Lakeside Park sec 4-1-17

May 1937

Lloyd L. Jensen
by H.E.G.