


NO. 896

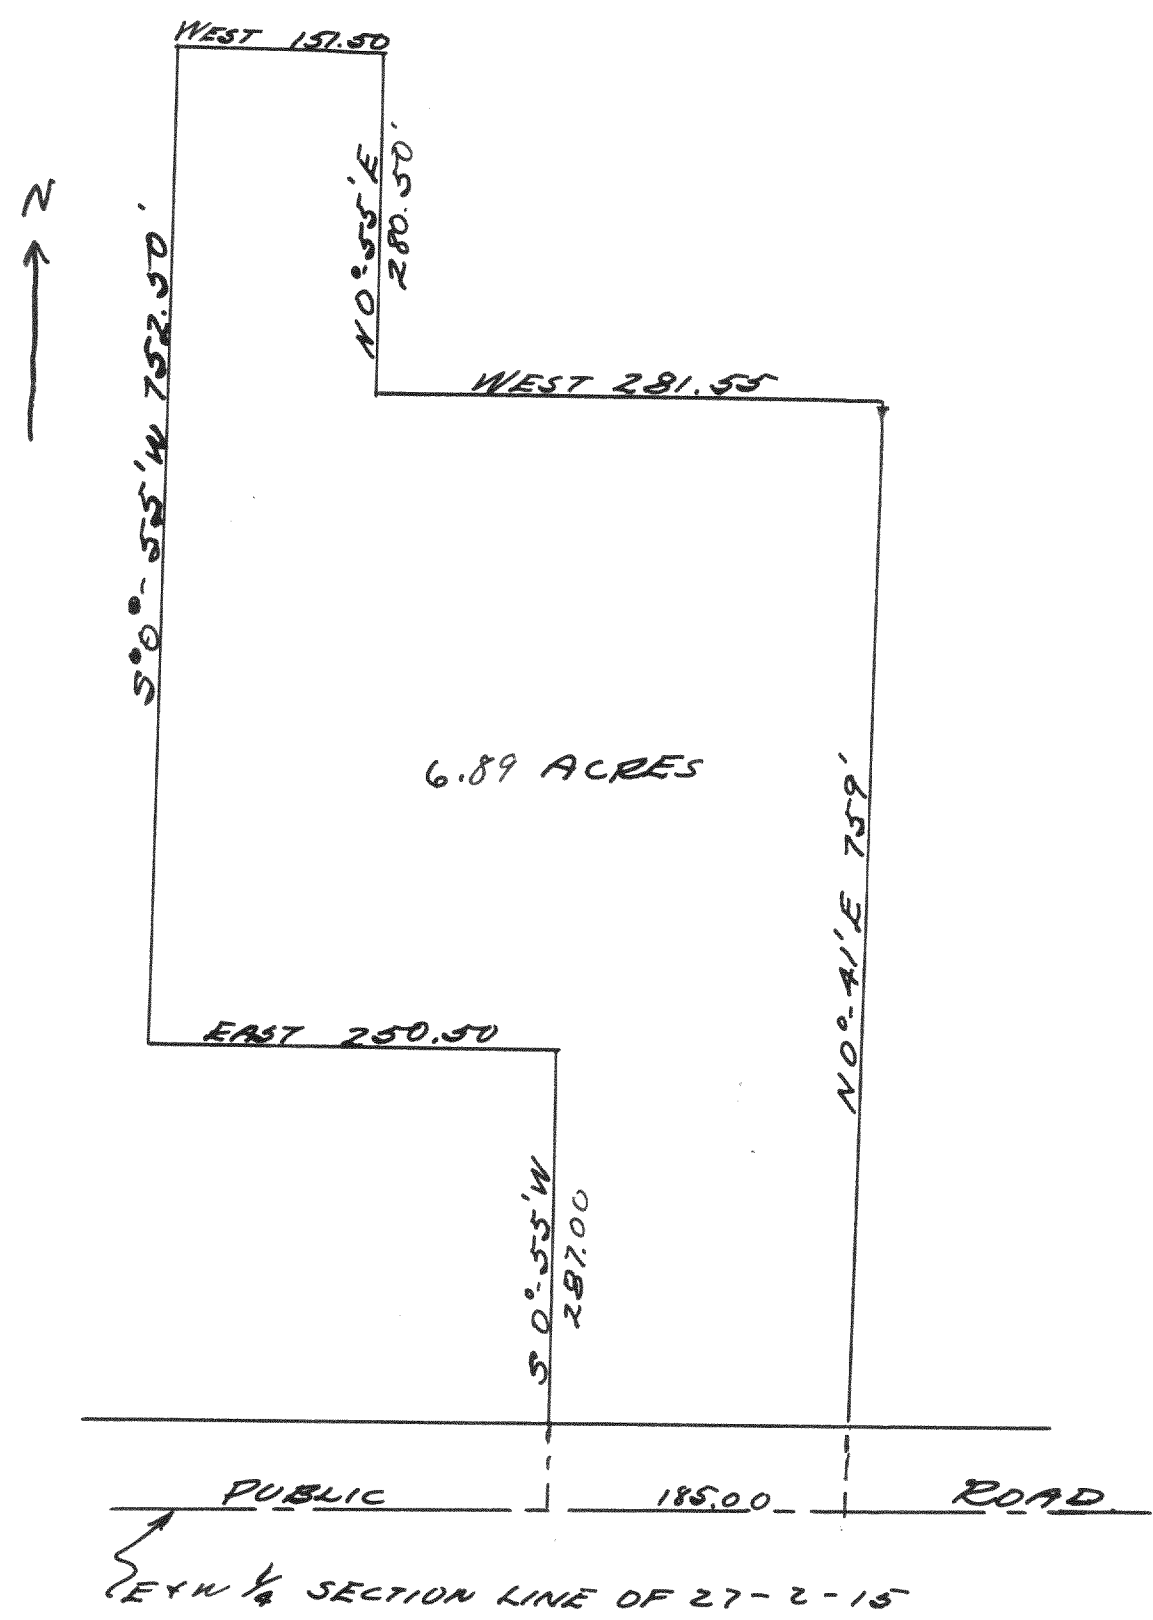


Survey of part of NW 1/4 of section 27-2-15

4-21-38

Lloyd Jensen
by H. E. J.

No. 897

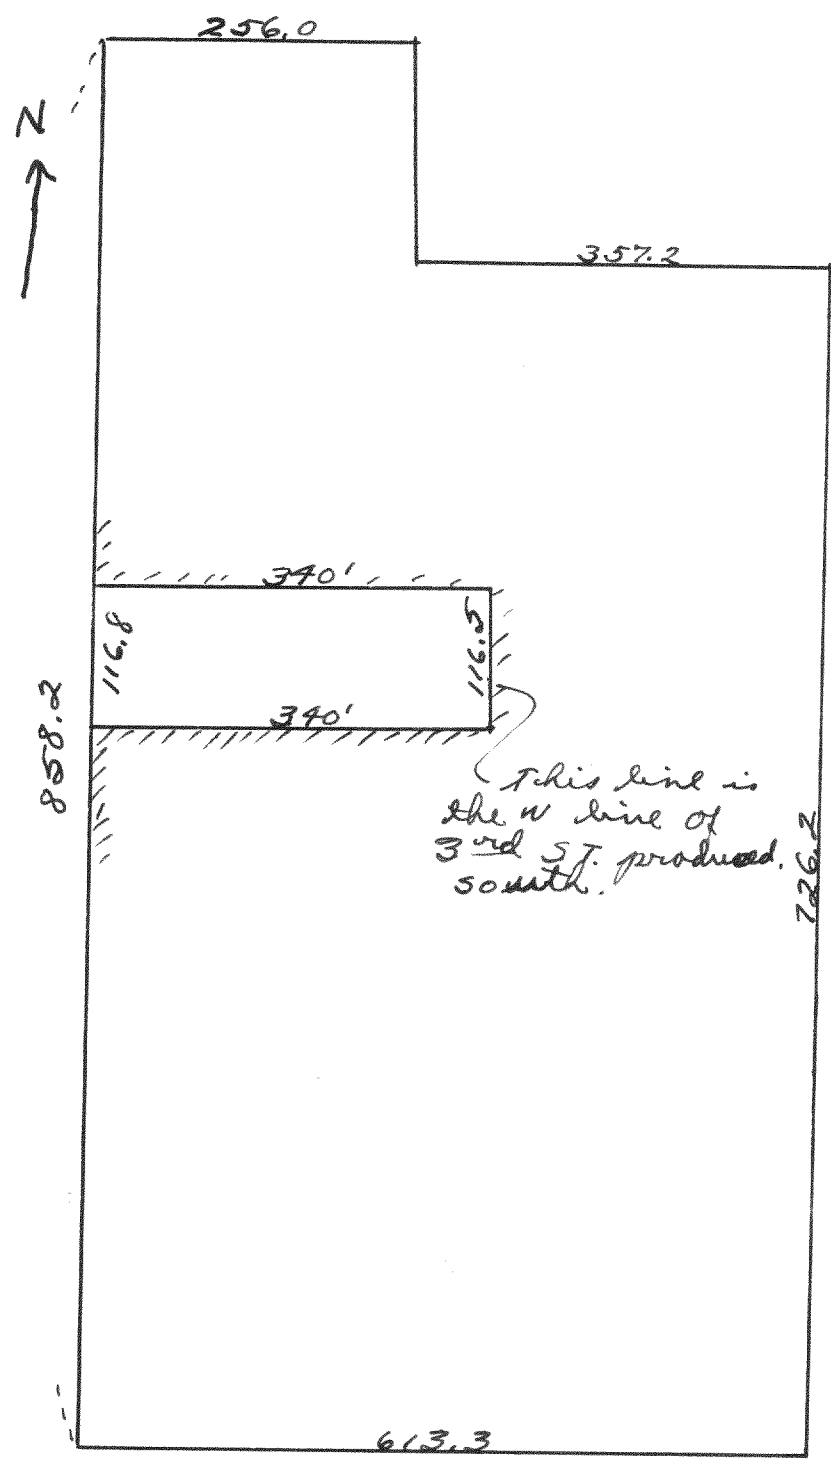


Survey of part of section 19 of the city of Delavan

July-1937

Lloyd L. Jensen
by H. E. J.

NO. 898

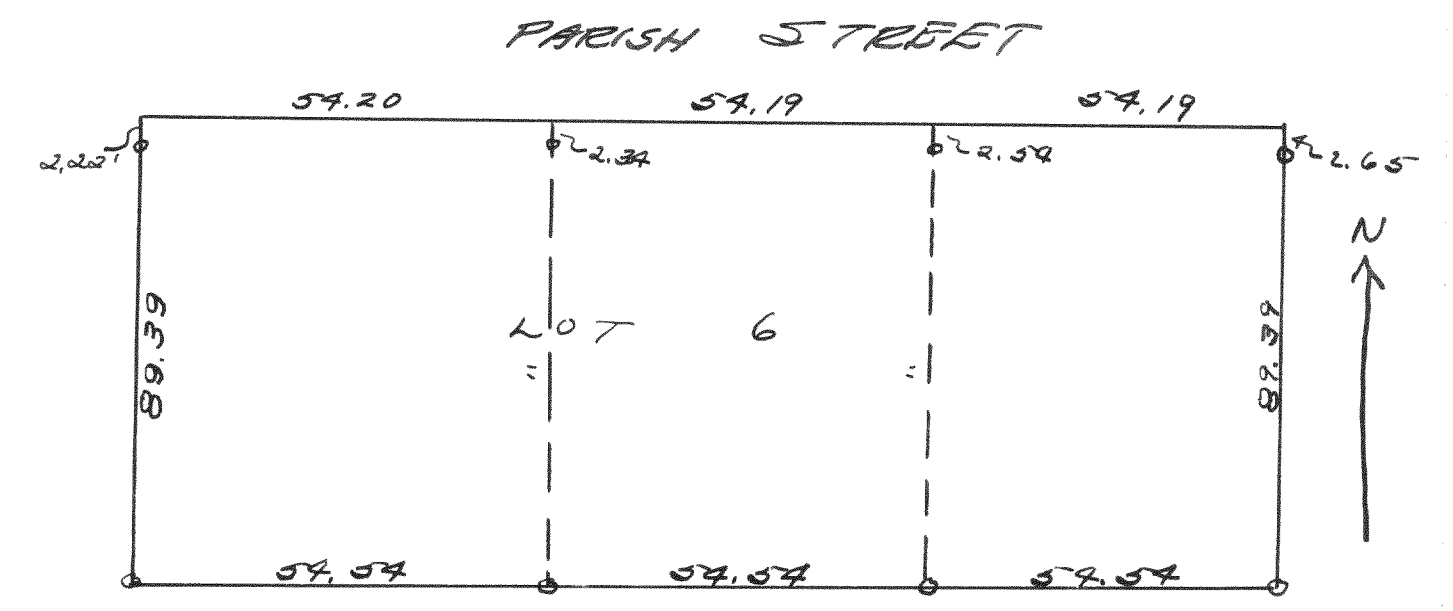

Survey of lot 6 and the south 23 feet of J. & DeWendoff's Add. to the city of Delavan

May 1937

Lloyd L. Jensen
by H. E. J.