



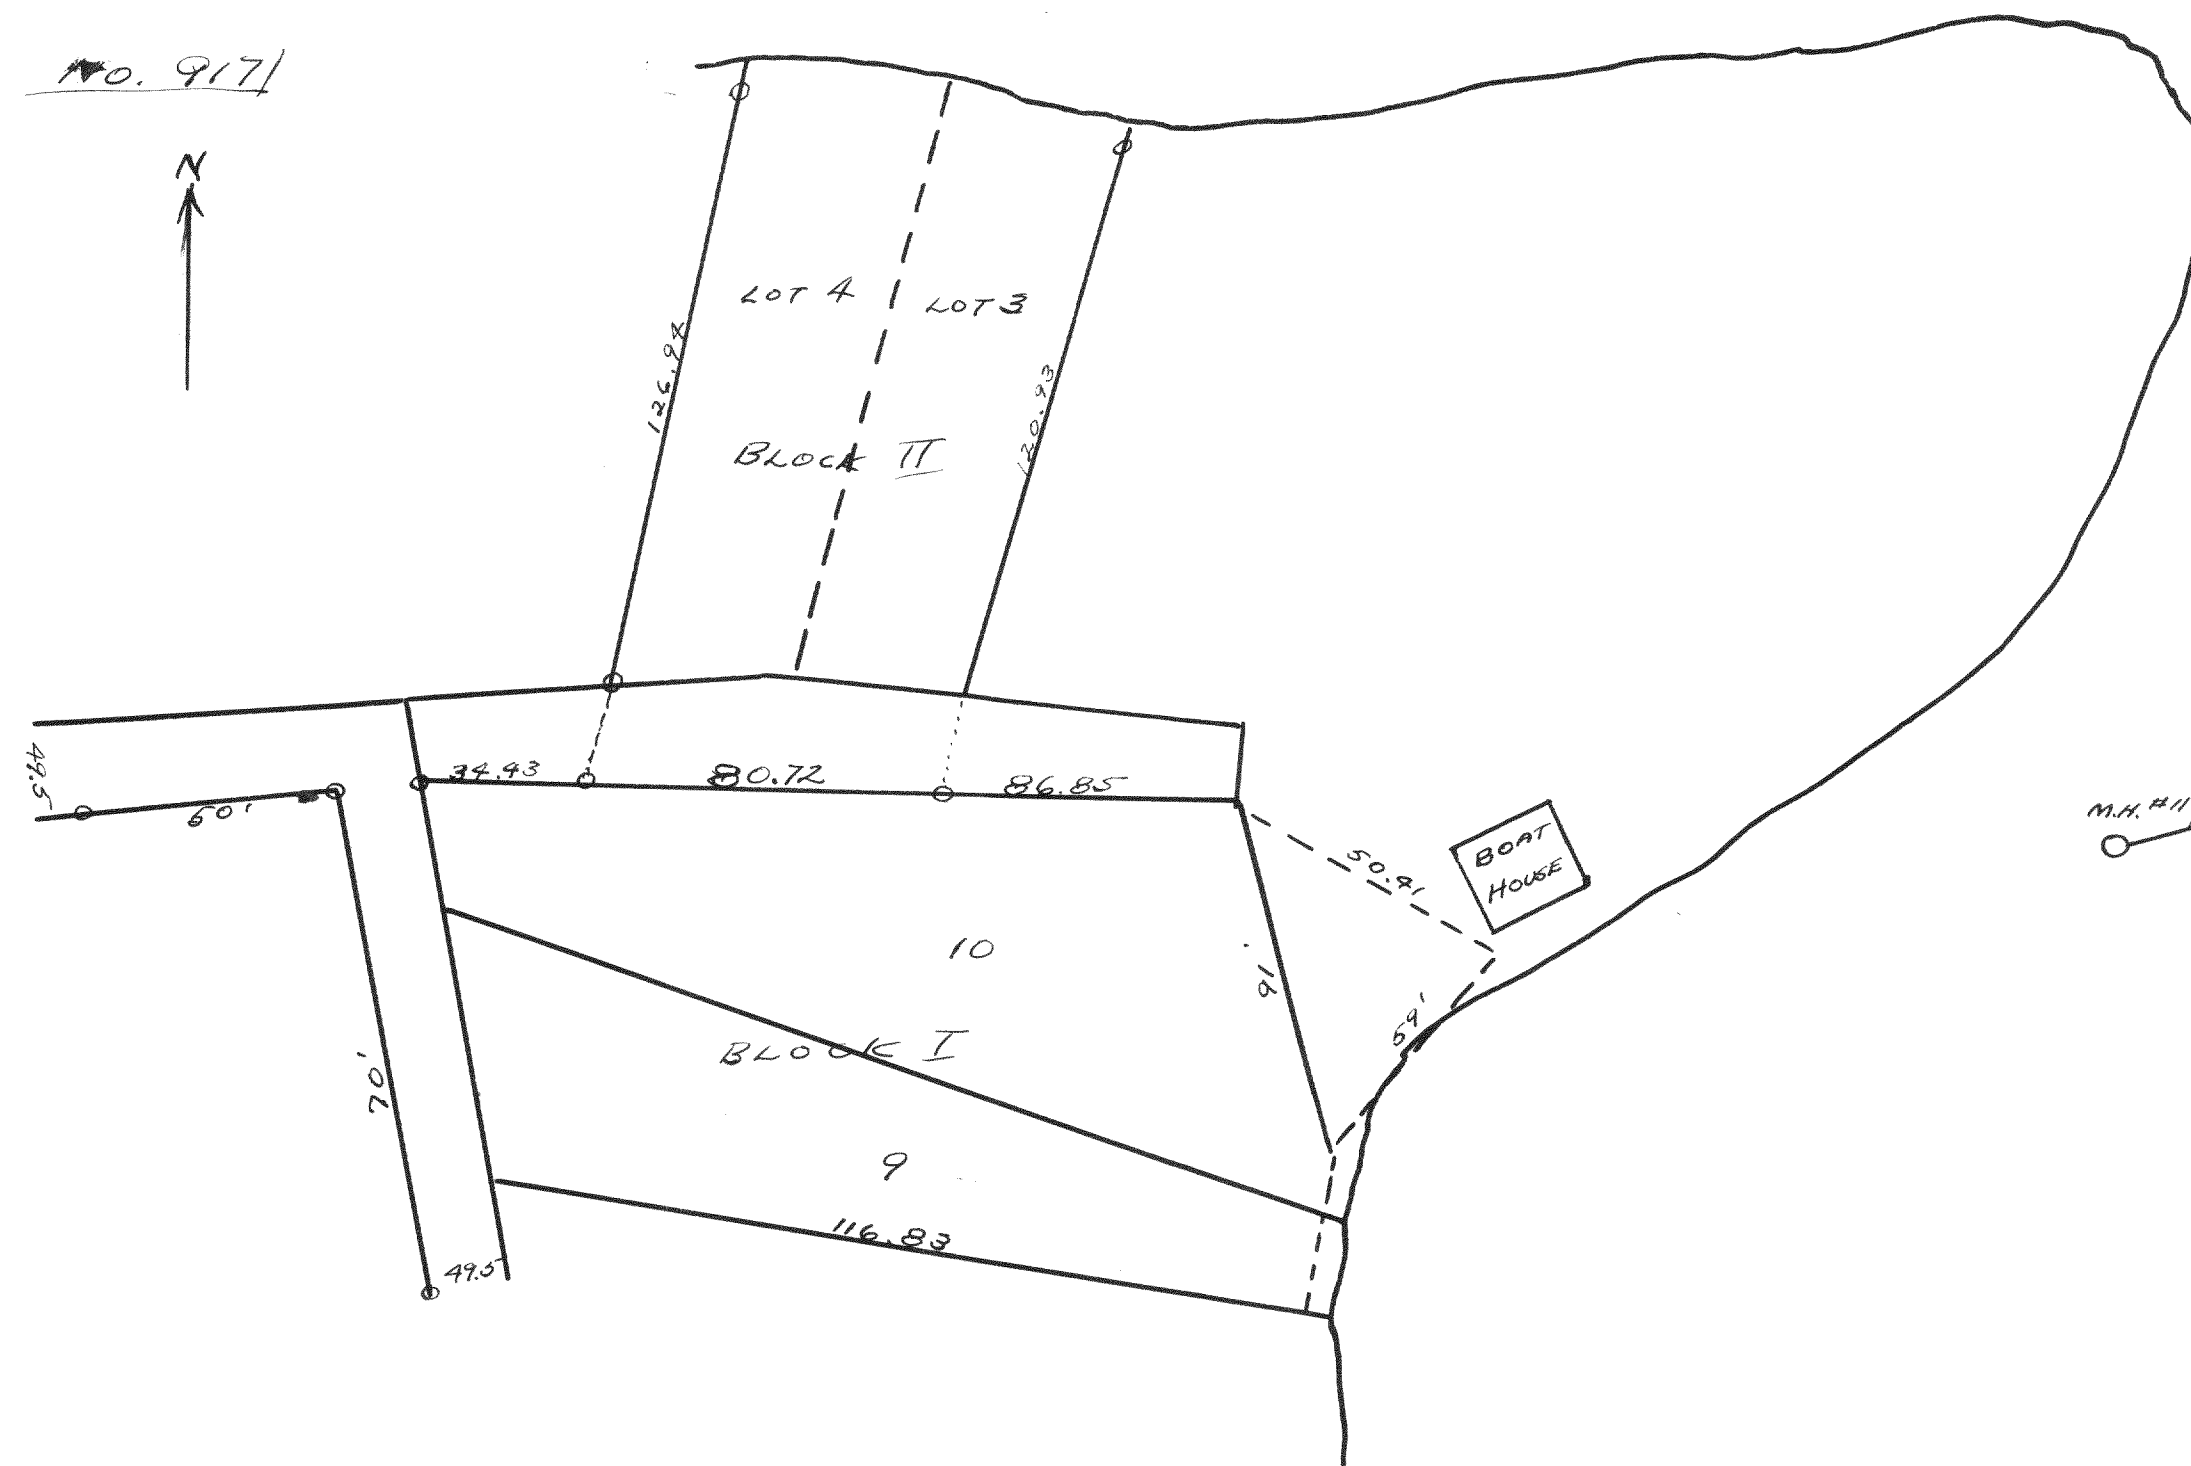

Survey of Lots 9 & 10 Blk. I and Lots 3 & 4
Block II of Green Lake Park in
Twp 4-26-4-16

7-26-38

Lloyd L. Jensen
by H.E.J.

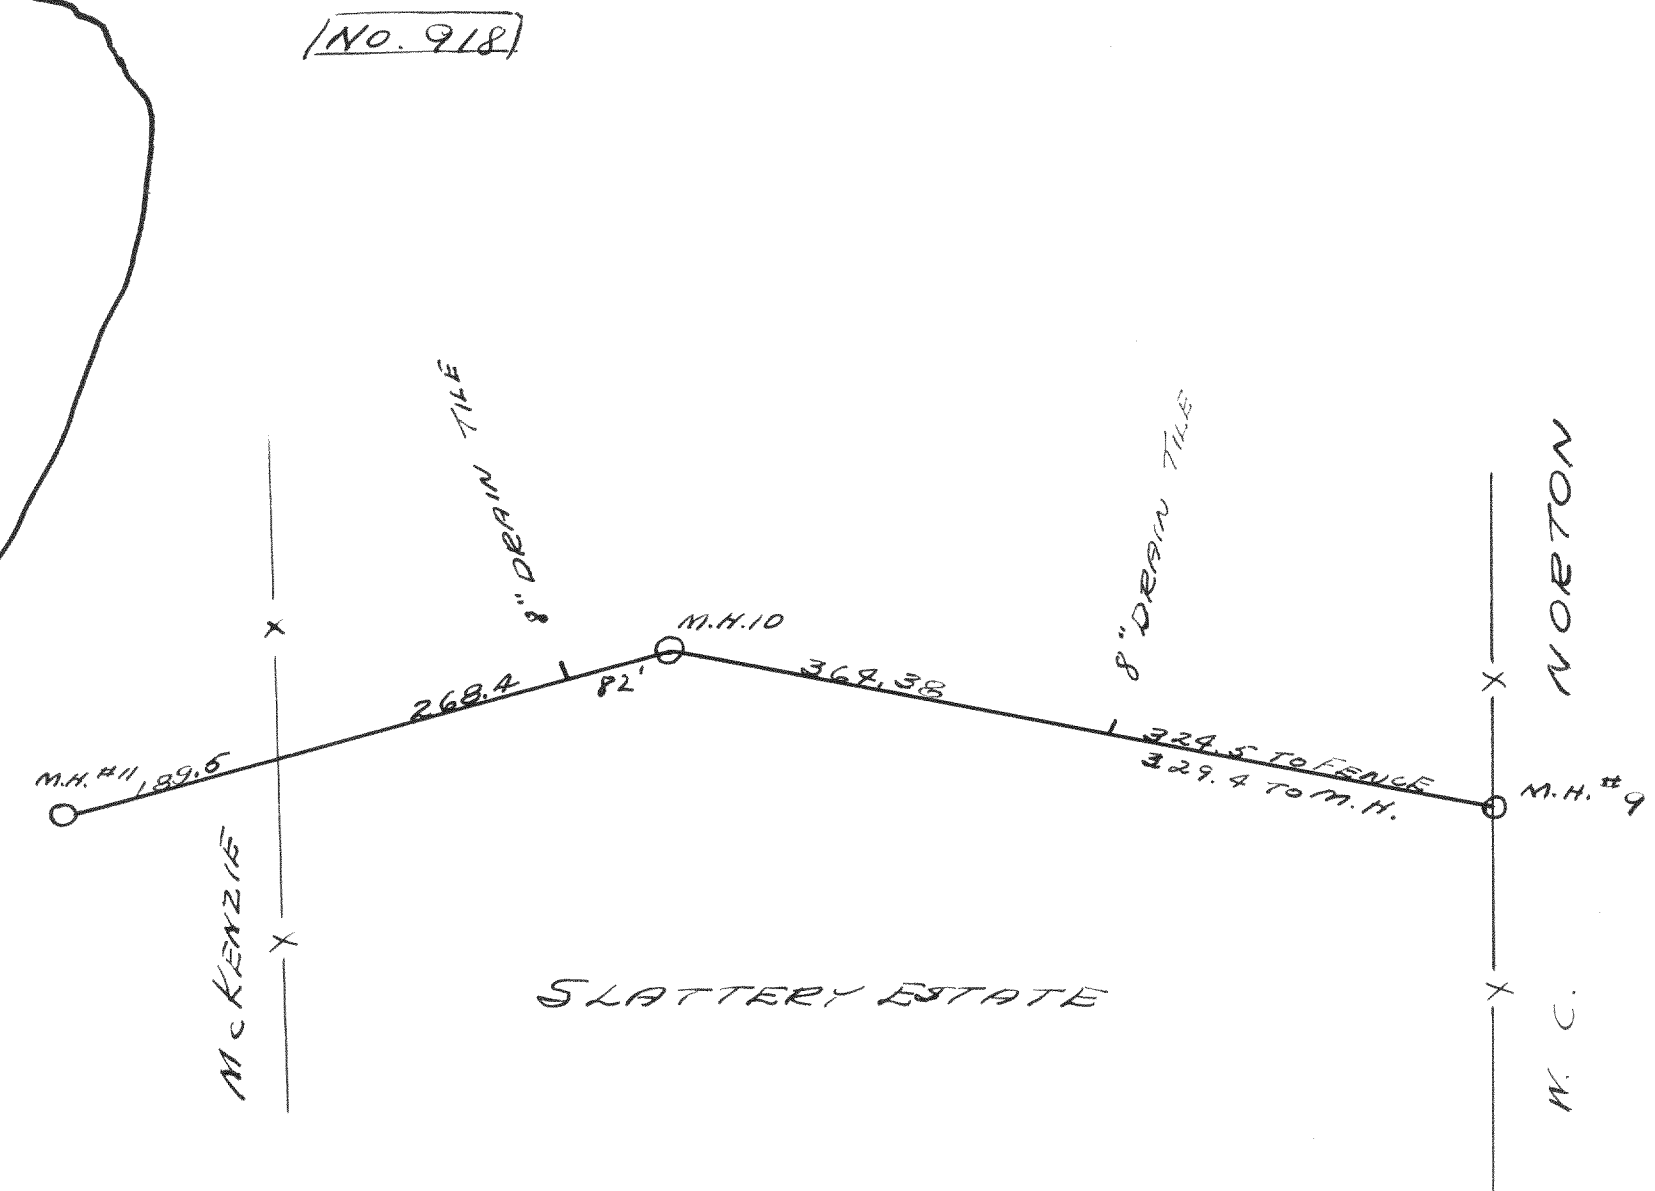

Connections to County Drain
Drainage Tile for Slattery Est.
in sec 8-2-17

Feb 5, 1935

Lloyd L. Jensen
by H.E.J.