


NO. 924

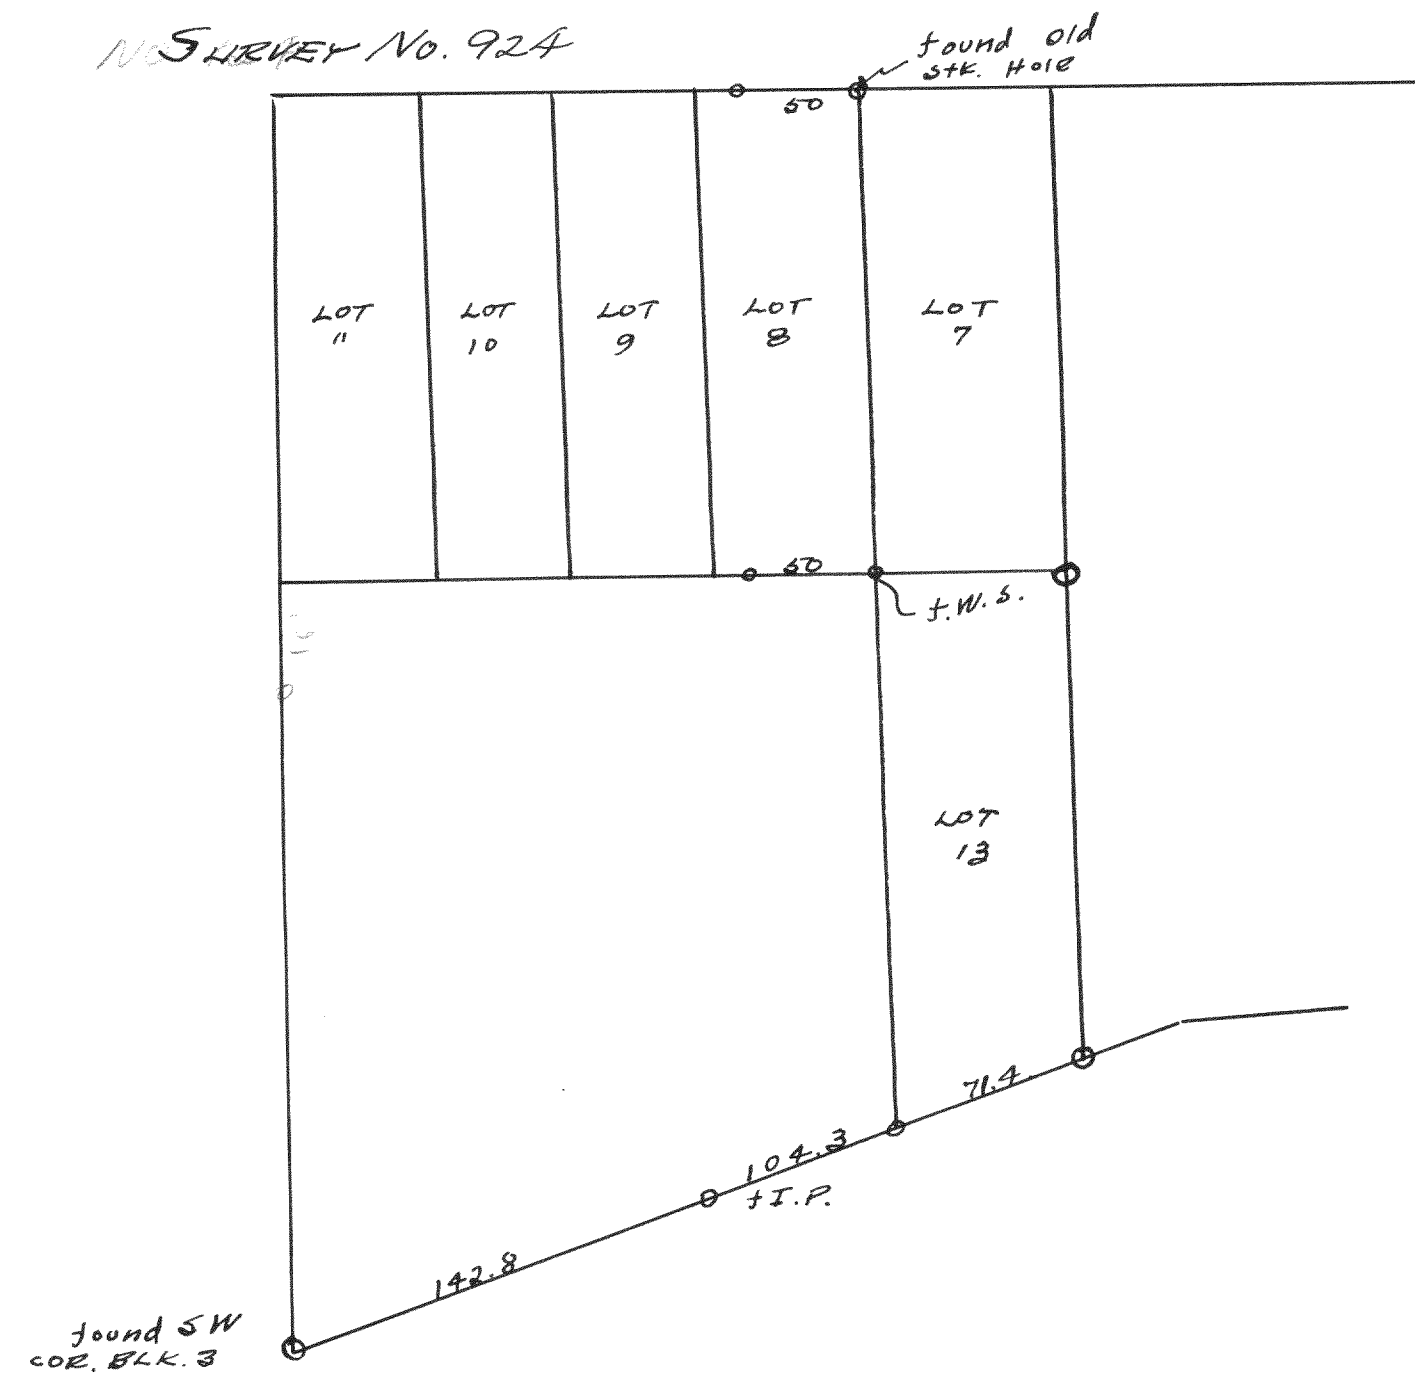


Survey of lot 8, 13 and 12 of
Block 3 on the original
plat of the Village of Thms. Bay

6-14-16-37

Lloyd L. Jensen
by H. C. J.

NO. 925

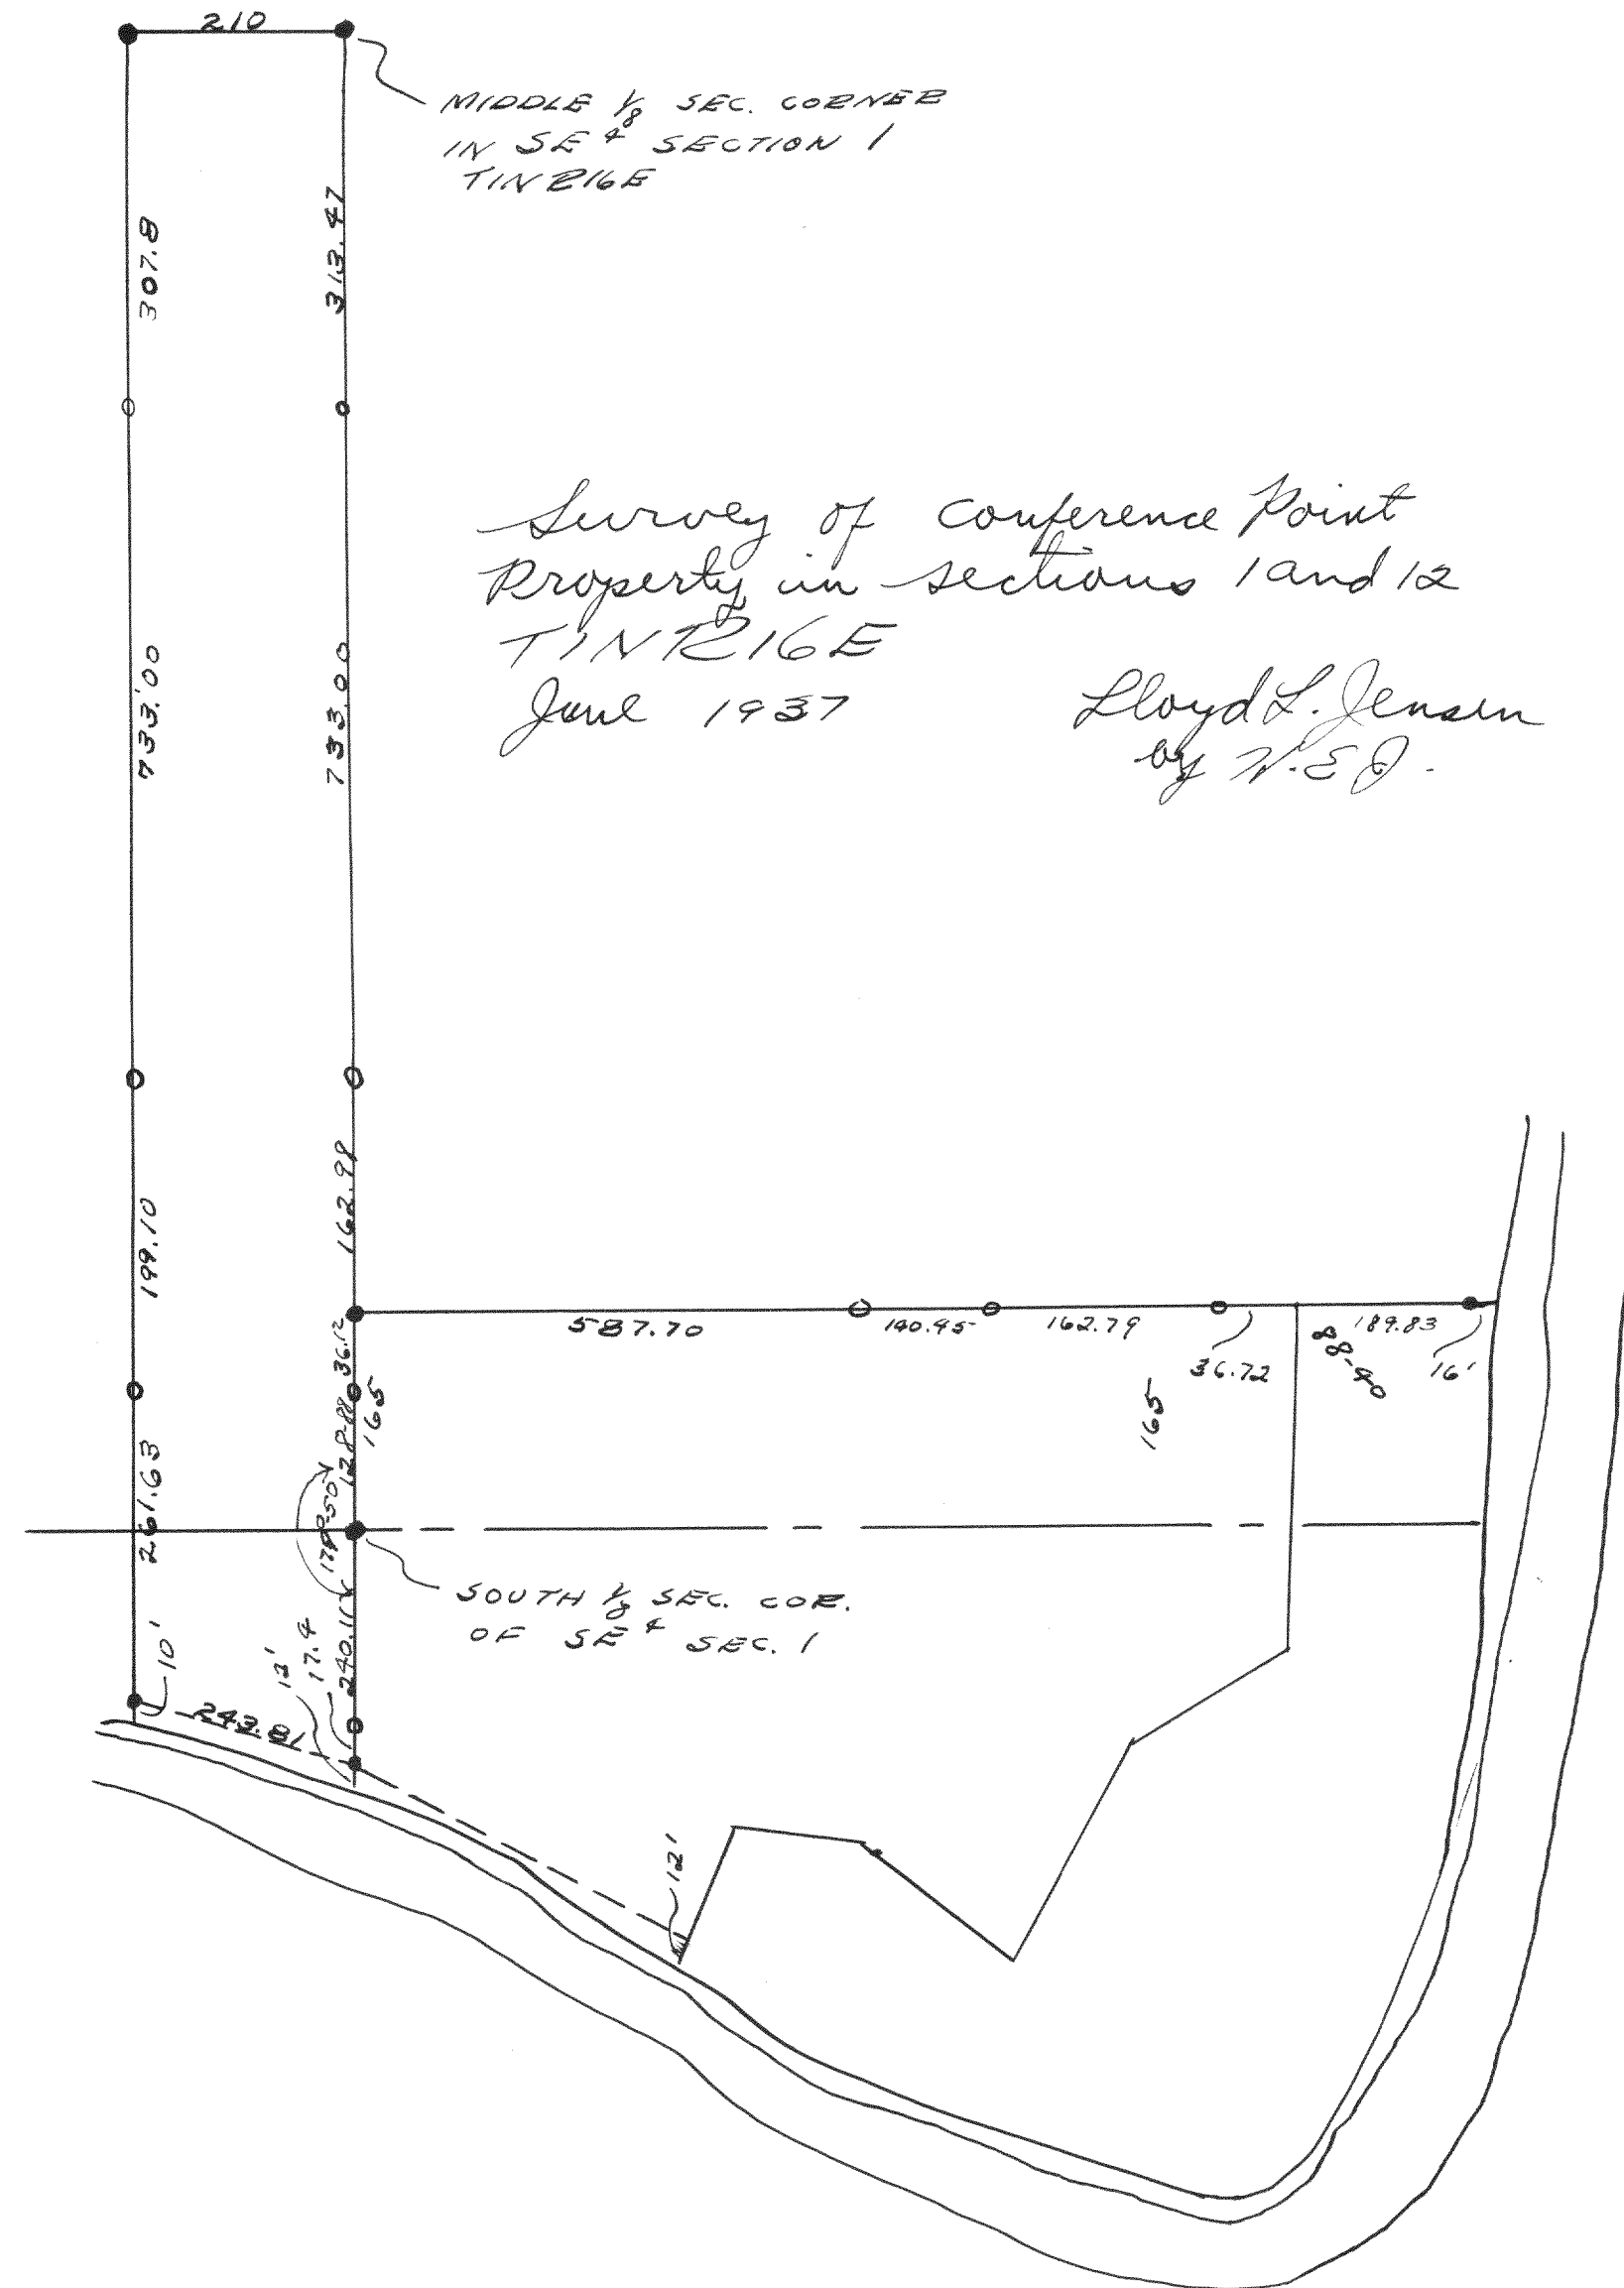

Survey of Conference Point
Property in sections 1 and 12
T1N216E

June 1937

Lloyd L. Jensen
by H. C. J.