


SURVEY NO. 941

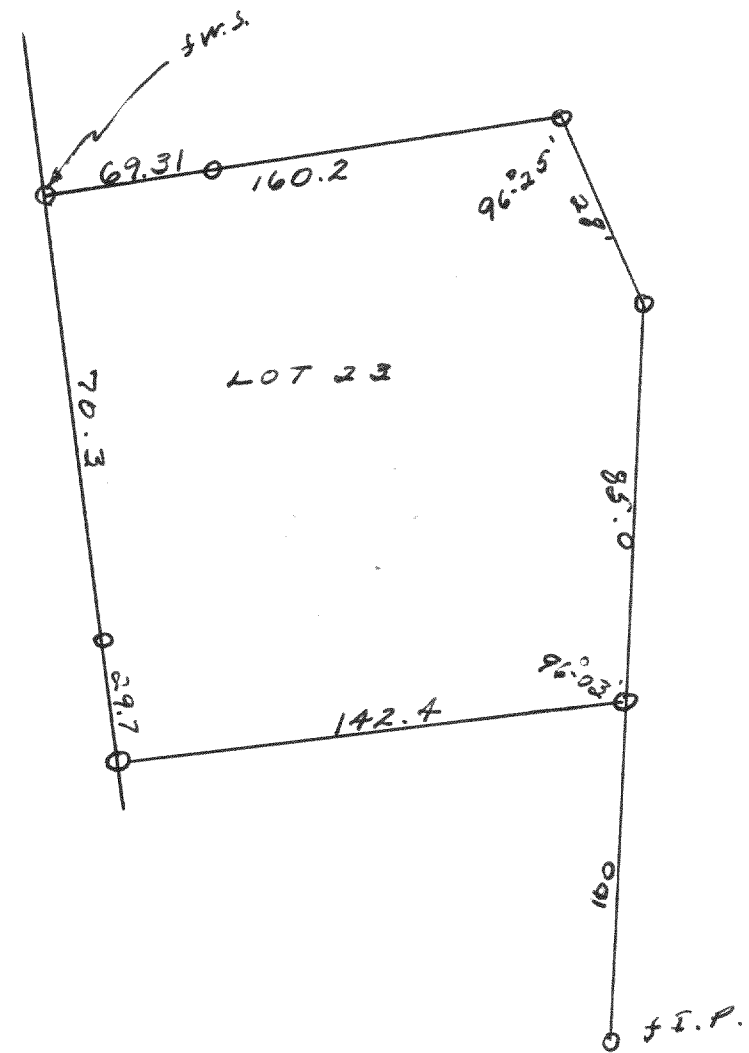


Survey of lot 23 block D Unit 3
of Co. Club Estates

8-28-37

Lloyd L. Jensen
by H. E. J.

SURVEY NO. 942

10-19-37

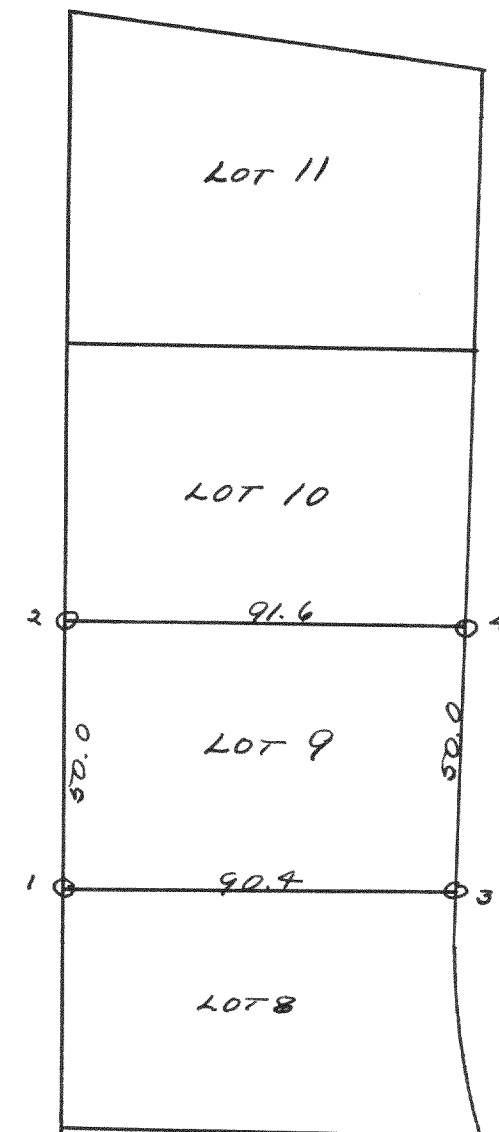


Survey of lot 9 Blk. 1
of Indian Hills in Village
of Troutand

10-22-37

Lloyd L. Jensen
by H. E. J.

SURVEY NO. 943

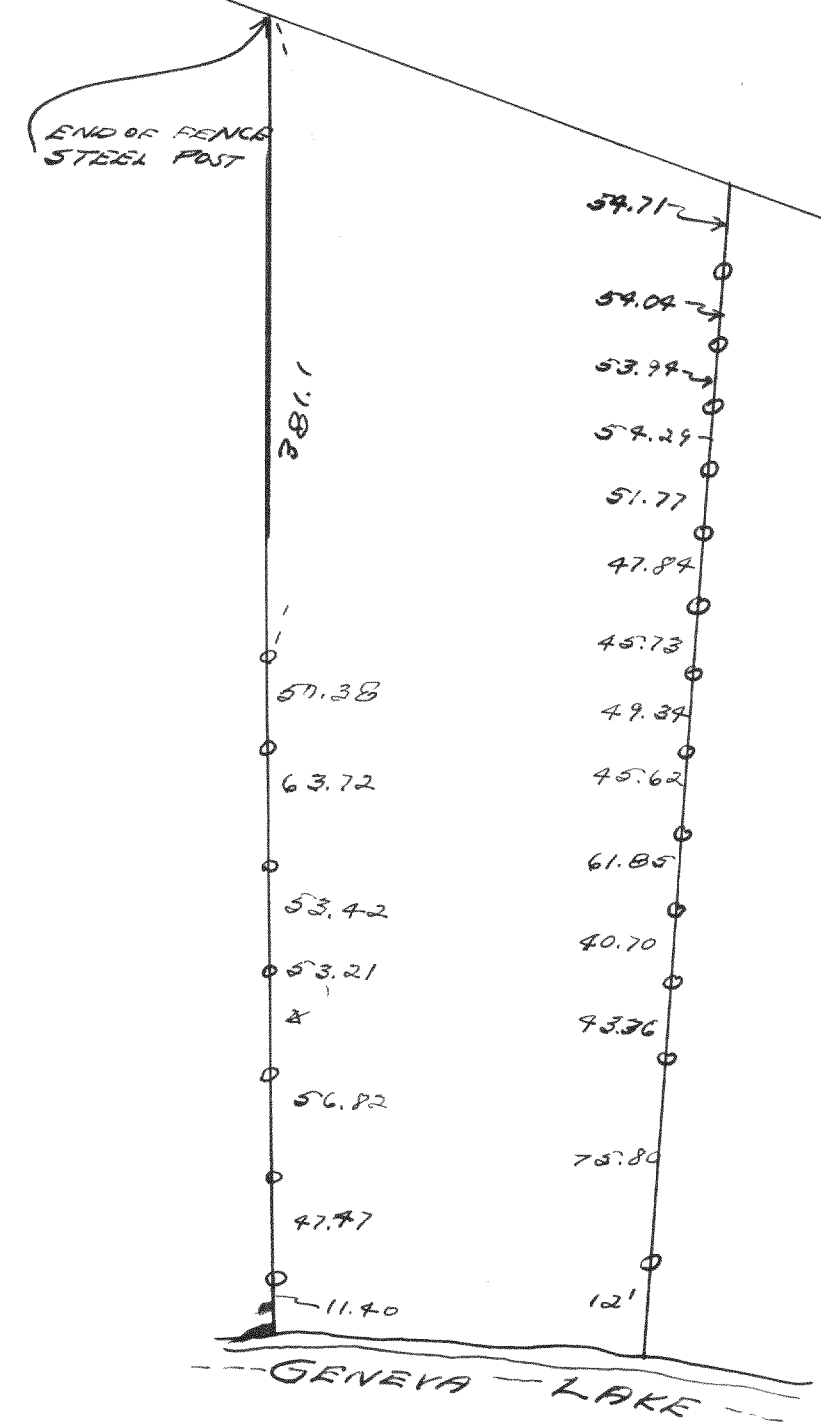

Survey of lot 5 of Stearn
and Girould Subdivision
in the Village of Troutand

10-4-37

Lloyd L. Jensen
by H. E. J.