


SURVEY No. 954

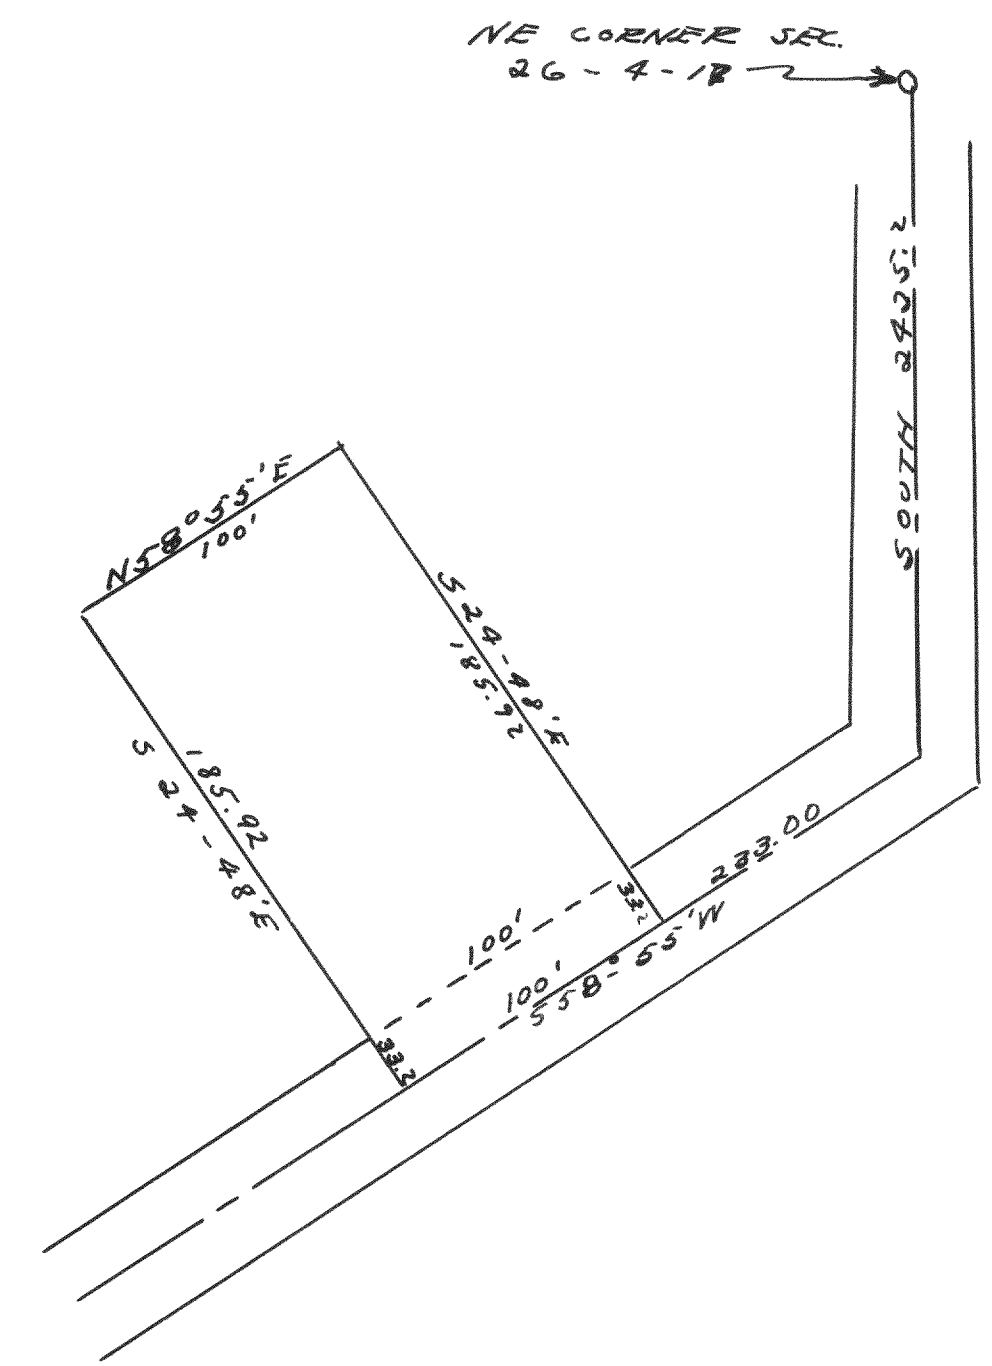


Survey of a parcel of land
in the E 1/2 26-4-16

12-15-38


Lloyd L. Jensen
by H.E.Q.

SURVEY No. 955

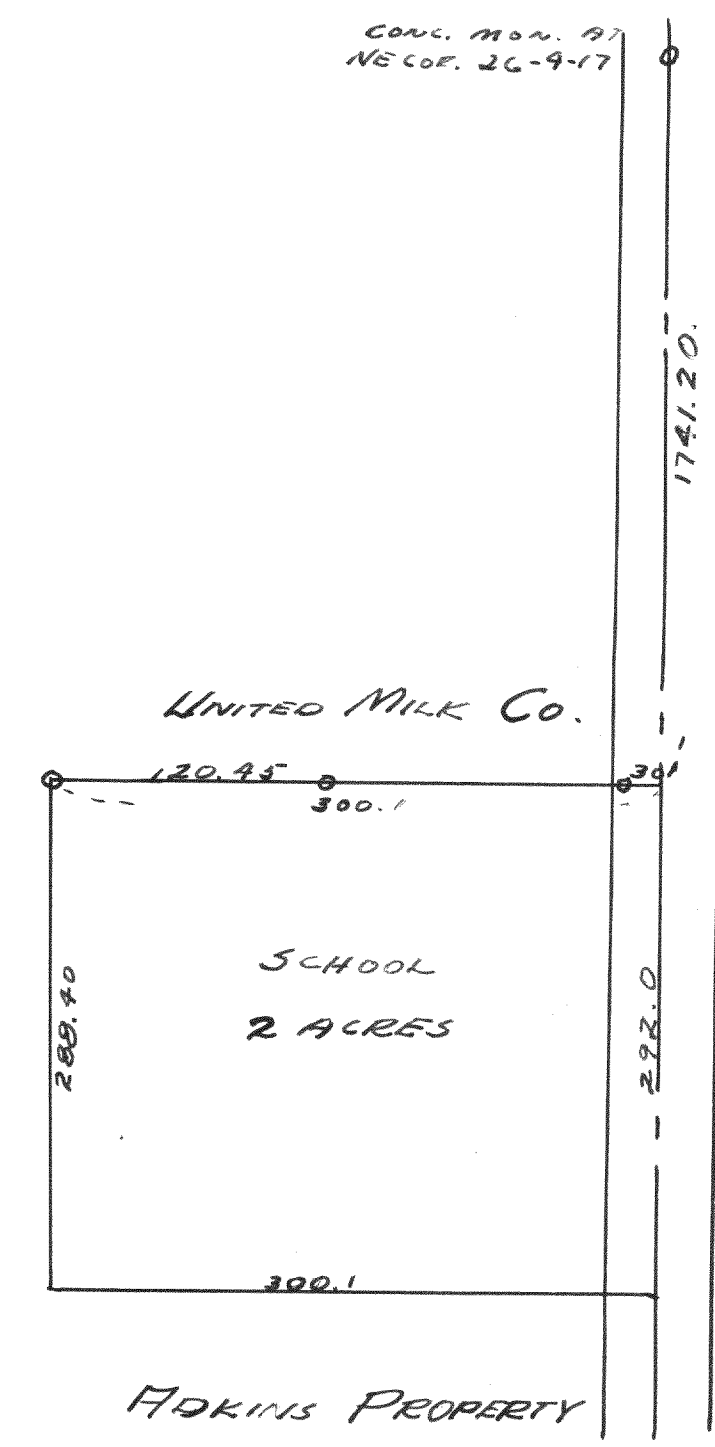

Survey of a parcel of land
in the East half of 26-4-17

SURVEY No. 956

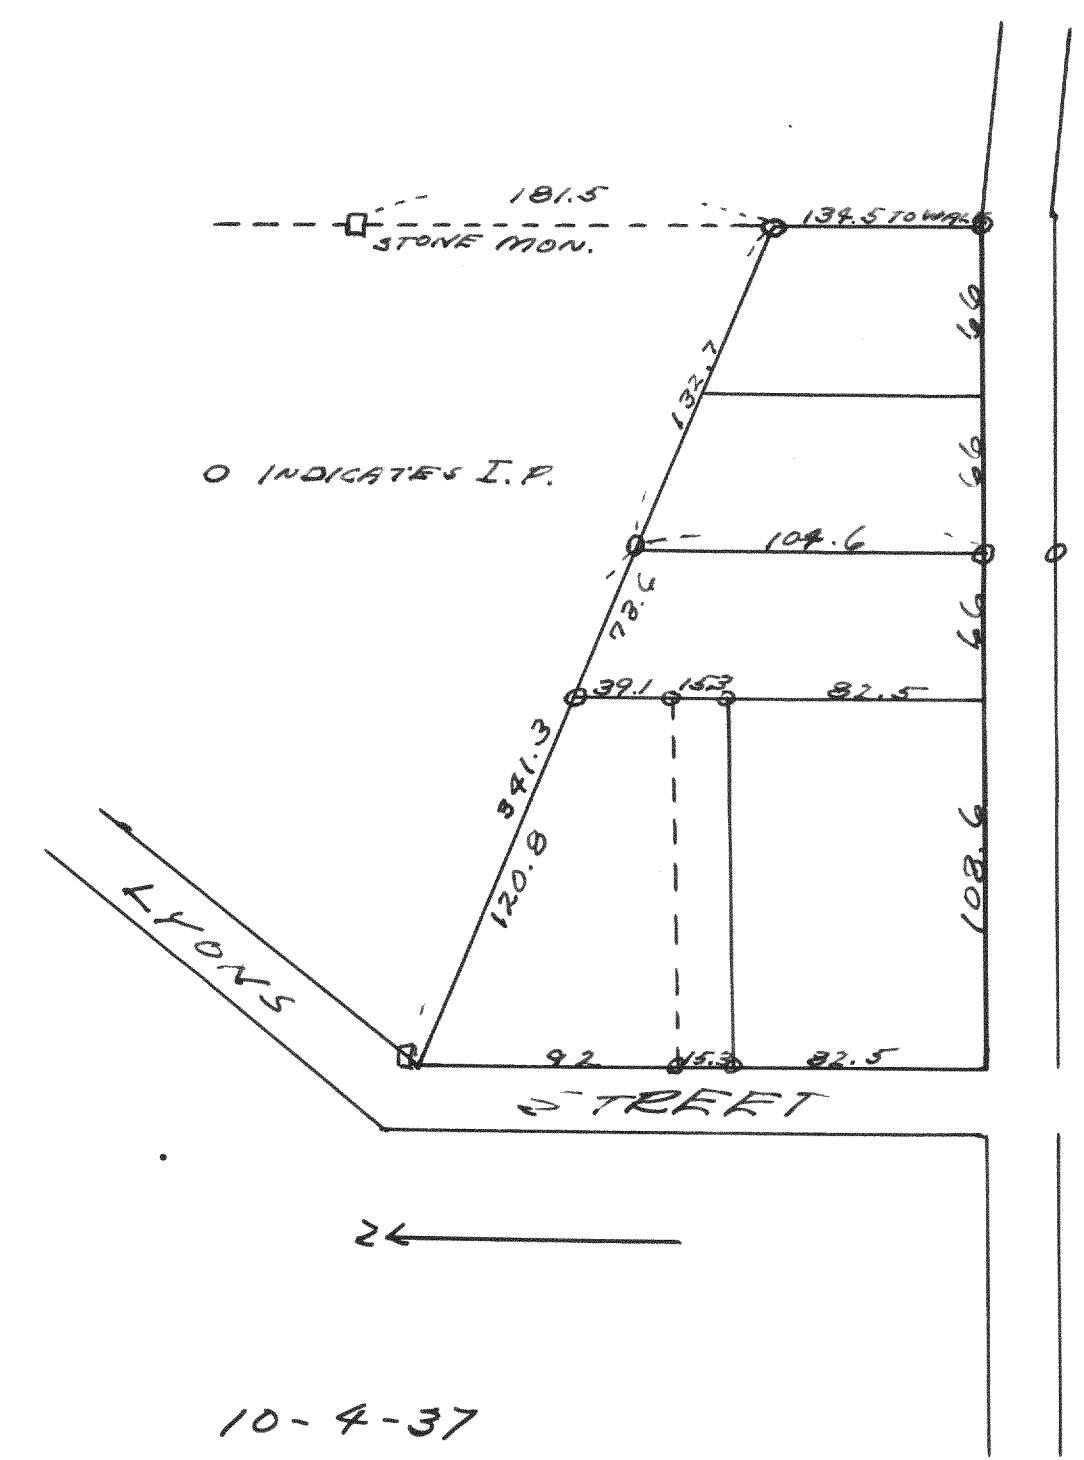

10-4-37

Survey of Lots 1, 2, 3, 4 & 5 Blk. 5
of Burke's Add to the
Village of Lyons.

Lloyd L. Jensen
by H.E.Q.