


Record of Survey

DESCRIPTION

OF SECTION, QUARTER SECTION AND QUARTER QUARTER SECTION CORNERS


no. 83

Township..... North of Range..... of 4 Principal Meridian
as presented by the courses and distances on the following plat, and annexed field-notes of survey:
Established the center of the section at the point of intersection of STRAIGHT quarter lines.
Established all quarter-quarter corners upon the section boundary at proportional distances between known section and quarter section corners, according to the original field-notes of the Government survey.
Established all lost corners at proportionate distances between known corners, according to the original field notes of the Government survey.

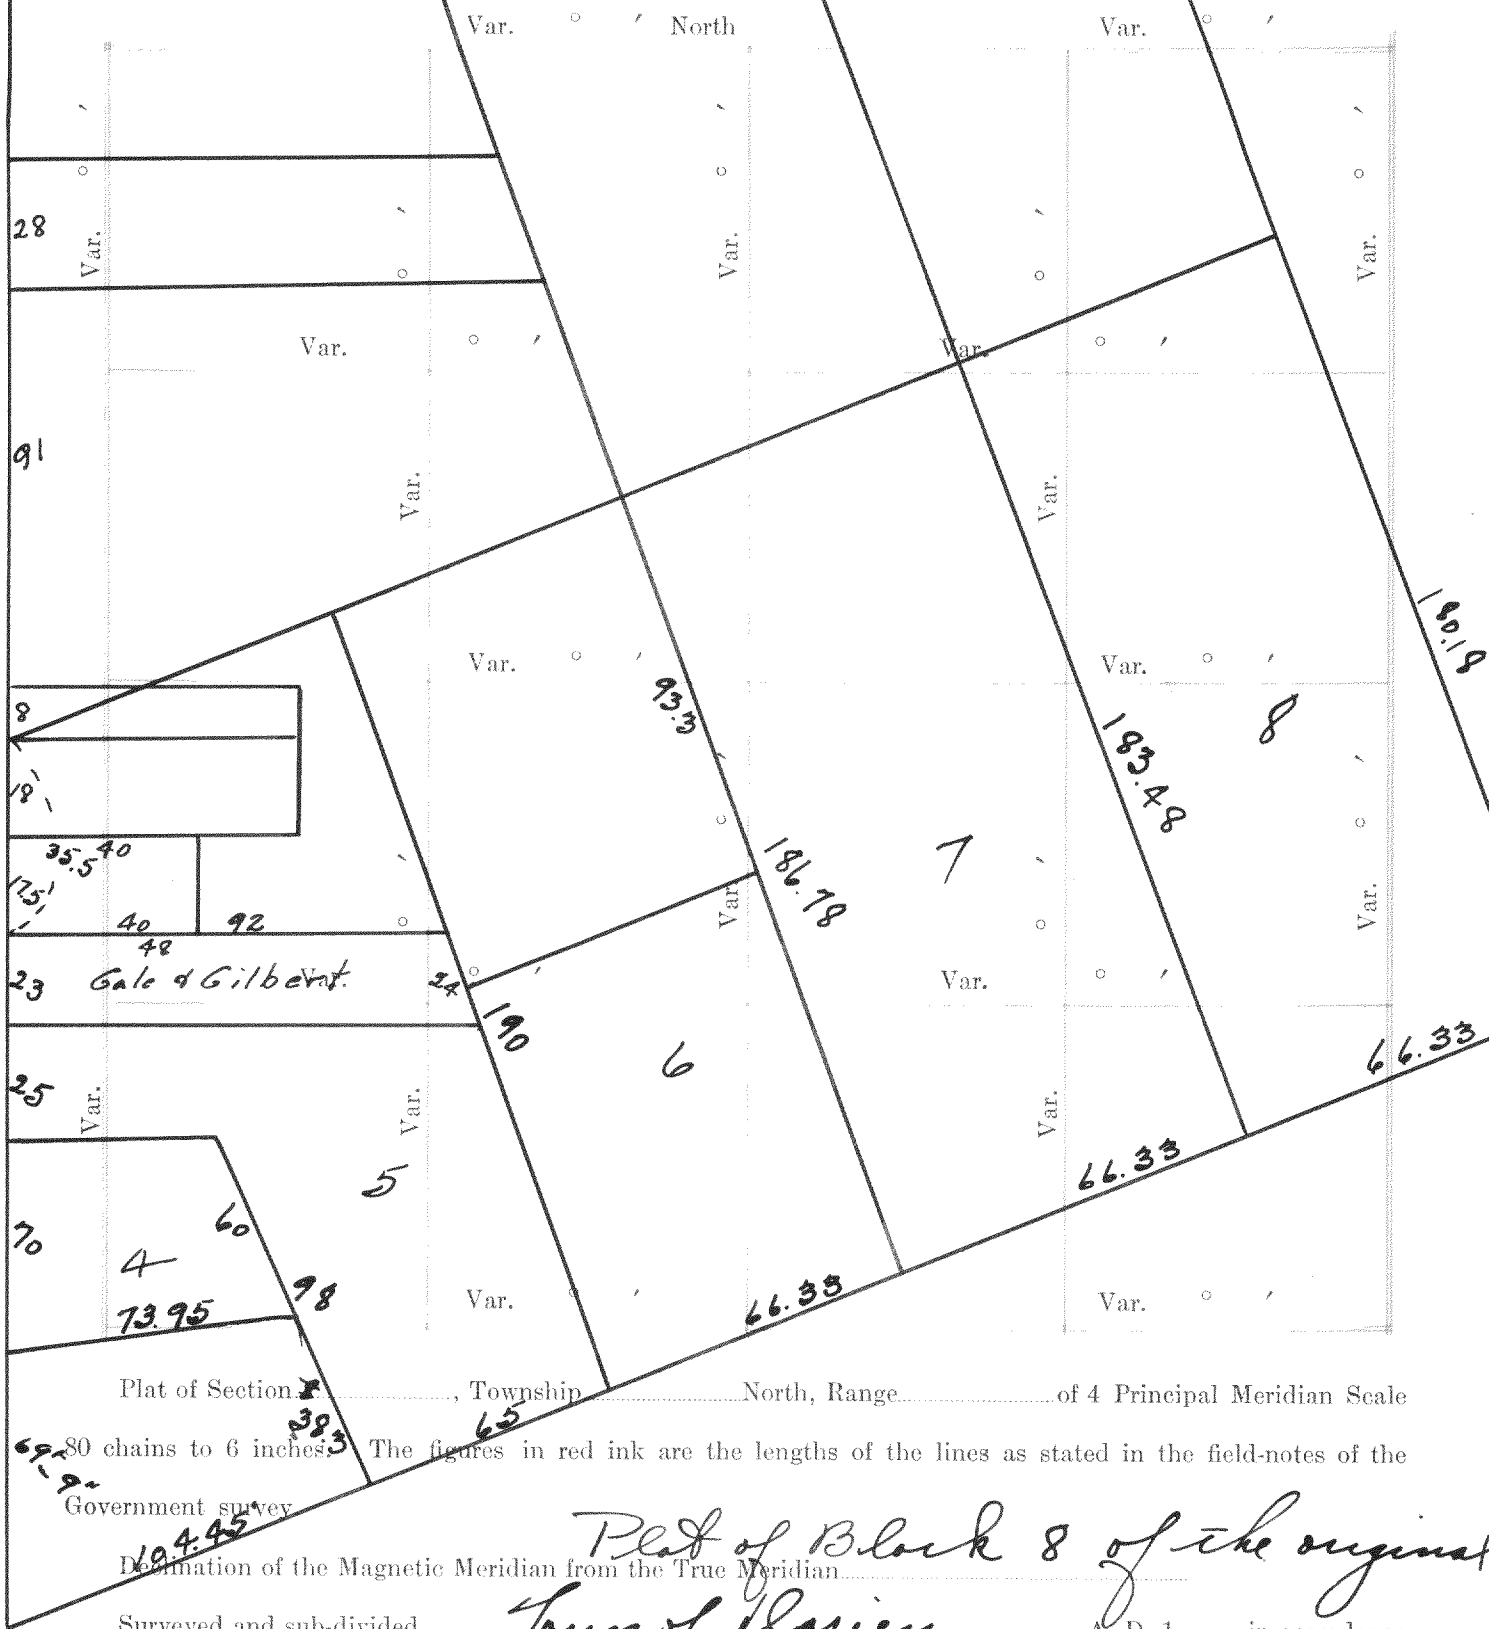

- GOVERNMENT CORNERS
- No.
1. N. W. Sec. Cor. identified, no. 84
 2. N. E. Sec. Cor. identified,
 3. S. E. Sec. Cor. identified,
 4. S. W. Sec. Cor. identified,
 5. N. ¼ Sec. Cor. identified,
 6. E. ¼ Sec. Cor. identified,
 7. S. ¼ Sec. Cor. identified,
 8. W. ¼ Sec. Cor. identified,

- Subdivision Corners
- No.
1. Center ¼ Sec. Cor.
 2. North ¼-¼s N. W. qr.,
 3. East ¼-¼s N. W. qr.,
 4. South ¼-¼s N. W. qr.,
 5. West ¼-¼s N. W. qr.,
 6. Center ¼-¼s N. W. qr.,
 7. North ¼-¼s N. E. qr.,
 8. East ¼-¼s N. E. qr.,
 9. South ¼-¼s N. E. qr.,
 10. Center ¼-¼s N. E. qr.,
 11. East ¼-¼s S. E. qr.,
 12. South ¼-¼s S. E. qr.,
 13. West ¼-¼s S. E. qr.,
 14. Center ¼-¼s S. E. qr.,
 15. South ¼-¼s S. W. qr.,
 16. West ¼-¼s S. W. qr.,
 17. Center ¼-¼s S. W. qr.

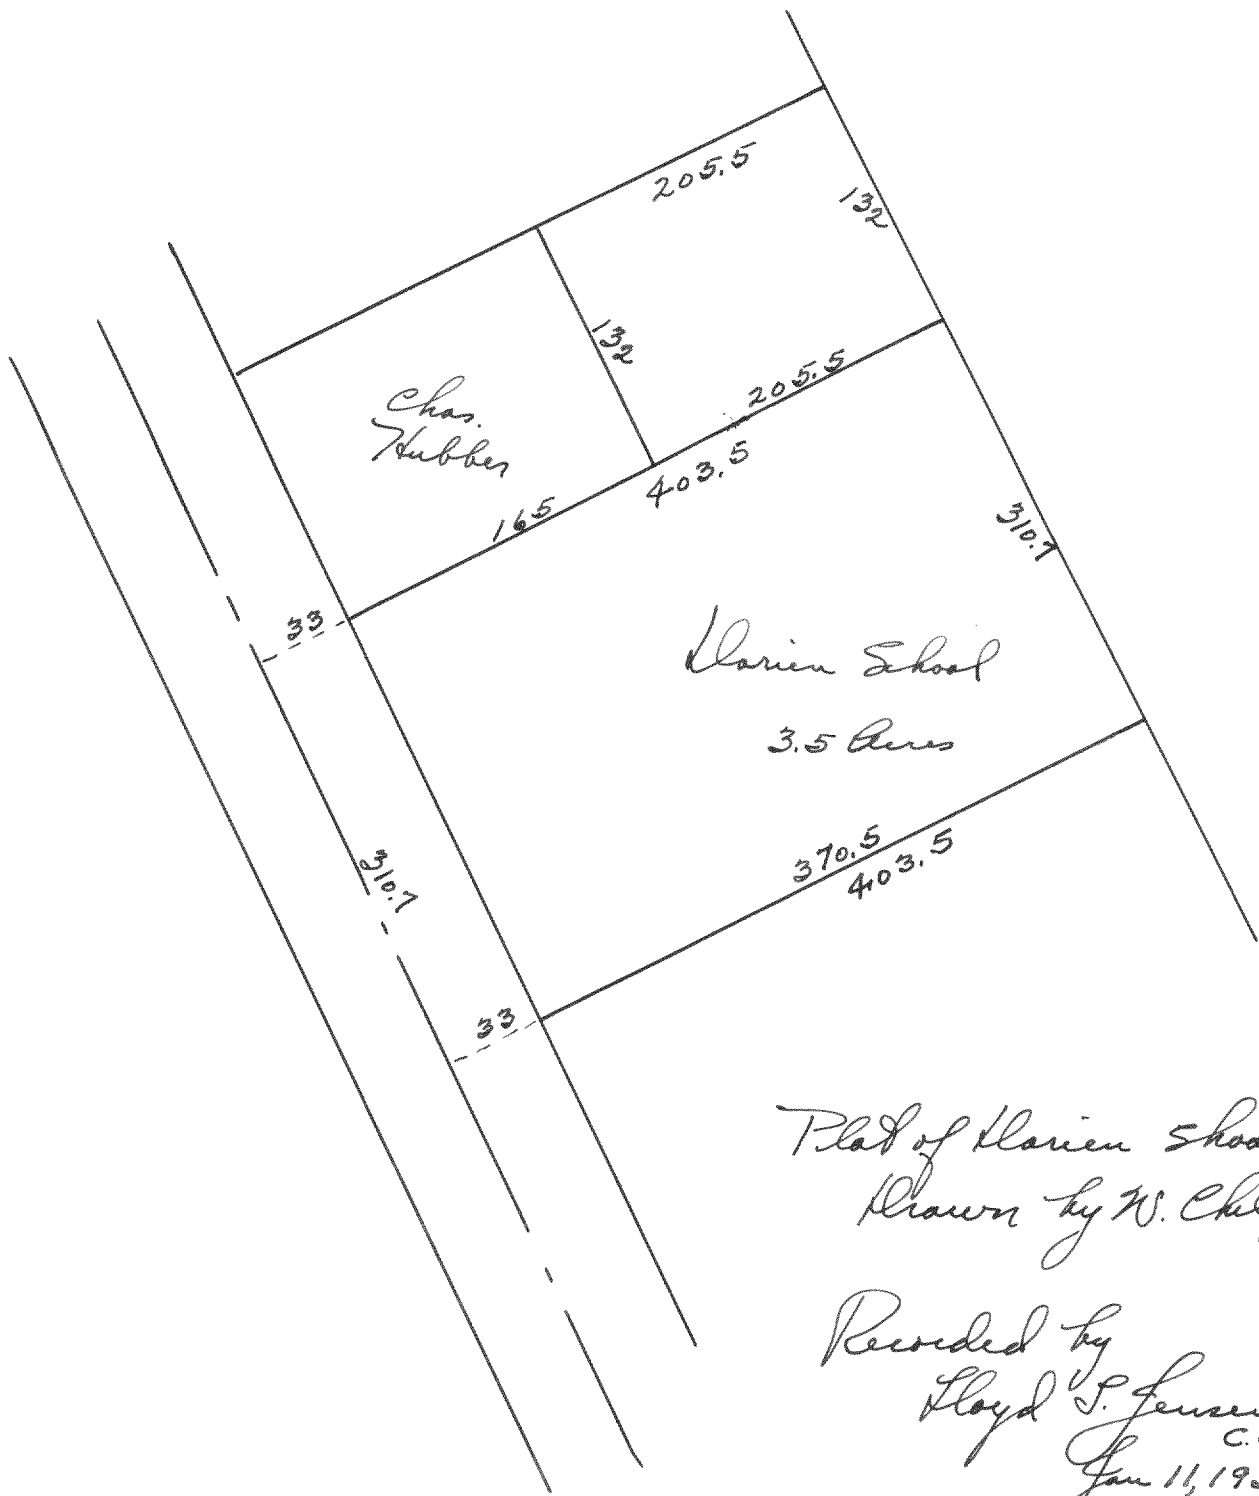

Plat of Clarion School.
Drawn by W. Childs
C.S.
Recorded by
Lloyd S. Jensen
C.S.
Jan 11, 1934

Plat of Block 8 of the original
Town of Clarion.
A. D. 1, in accordance
with the State Laws and Instructions of the Commissioner of the General Land office, and recorded in the
of Register in the County Clerk's office.
Witness my hand this day of
Recorded by Lloyd S. Jensen
C.S.
Jan 16, 1934

NAMES OF SWORN ASSISTANTS

CHAINMEN
FLAGMEN
AXMEN

24



Recorded by Lloyd P. Jensen
C.S.
Jan. 19, 1934

Survey of the Roy Thomas farm as shown in
the 1930 Atlas.

That I did on the 23rd day of April 1921, make a survey on the East half, of the North West Quarter, of Section No. 9 and the South East Quarter of the SW quarter of Section No. 4 of Town No. ~~4~~² North, Range 15 East, being the Town of Hoven, Walworth County, Wisconsin, as follows to wit:-

On the one eighth Section line, a point was made 30 feet north of the fence post on the South side of the road, for the center of the road, and from this point north 1952 feet to the N. W. Corner of the said East half. Thence East 1328 feet, to the quarter Section corner, on the North side of said section, being the North East corner of the said East half. Thence South, along the said East line, being also the N. & S. $\frac{1}{4}$ line, 1952 feet to a pt, that is 1325 feet East of the place of beginning, and 639 feet more to a point 38' South of the fence post on the North side of the road, which point was taken as the center of the road, and being 47' North of the South East Corner of the said West half, and I find that this piece contains 69.16 acres.

Surveyed by William Childs
C.S.

Recorded by Lloyd S. Jensen
C.S.
Jan. 19, 1934