



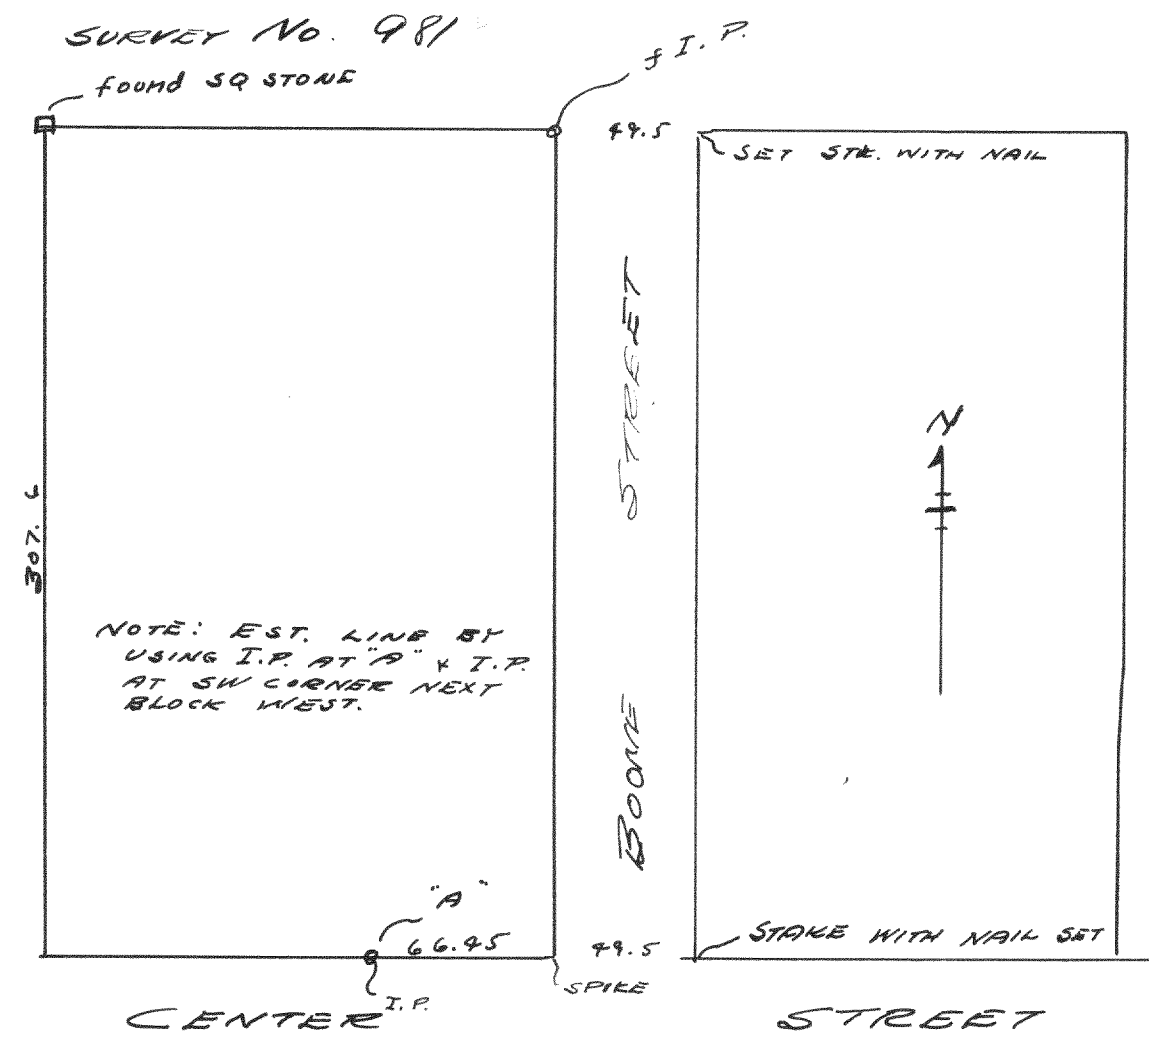

Plat of survey of N. block of
Boone Street
1939

Lloyd L. Jensen
by H. E. J.

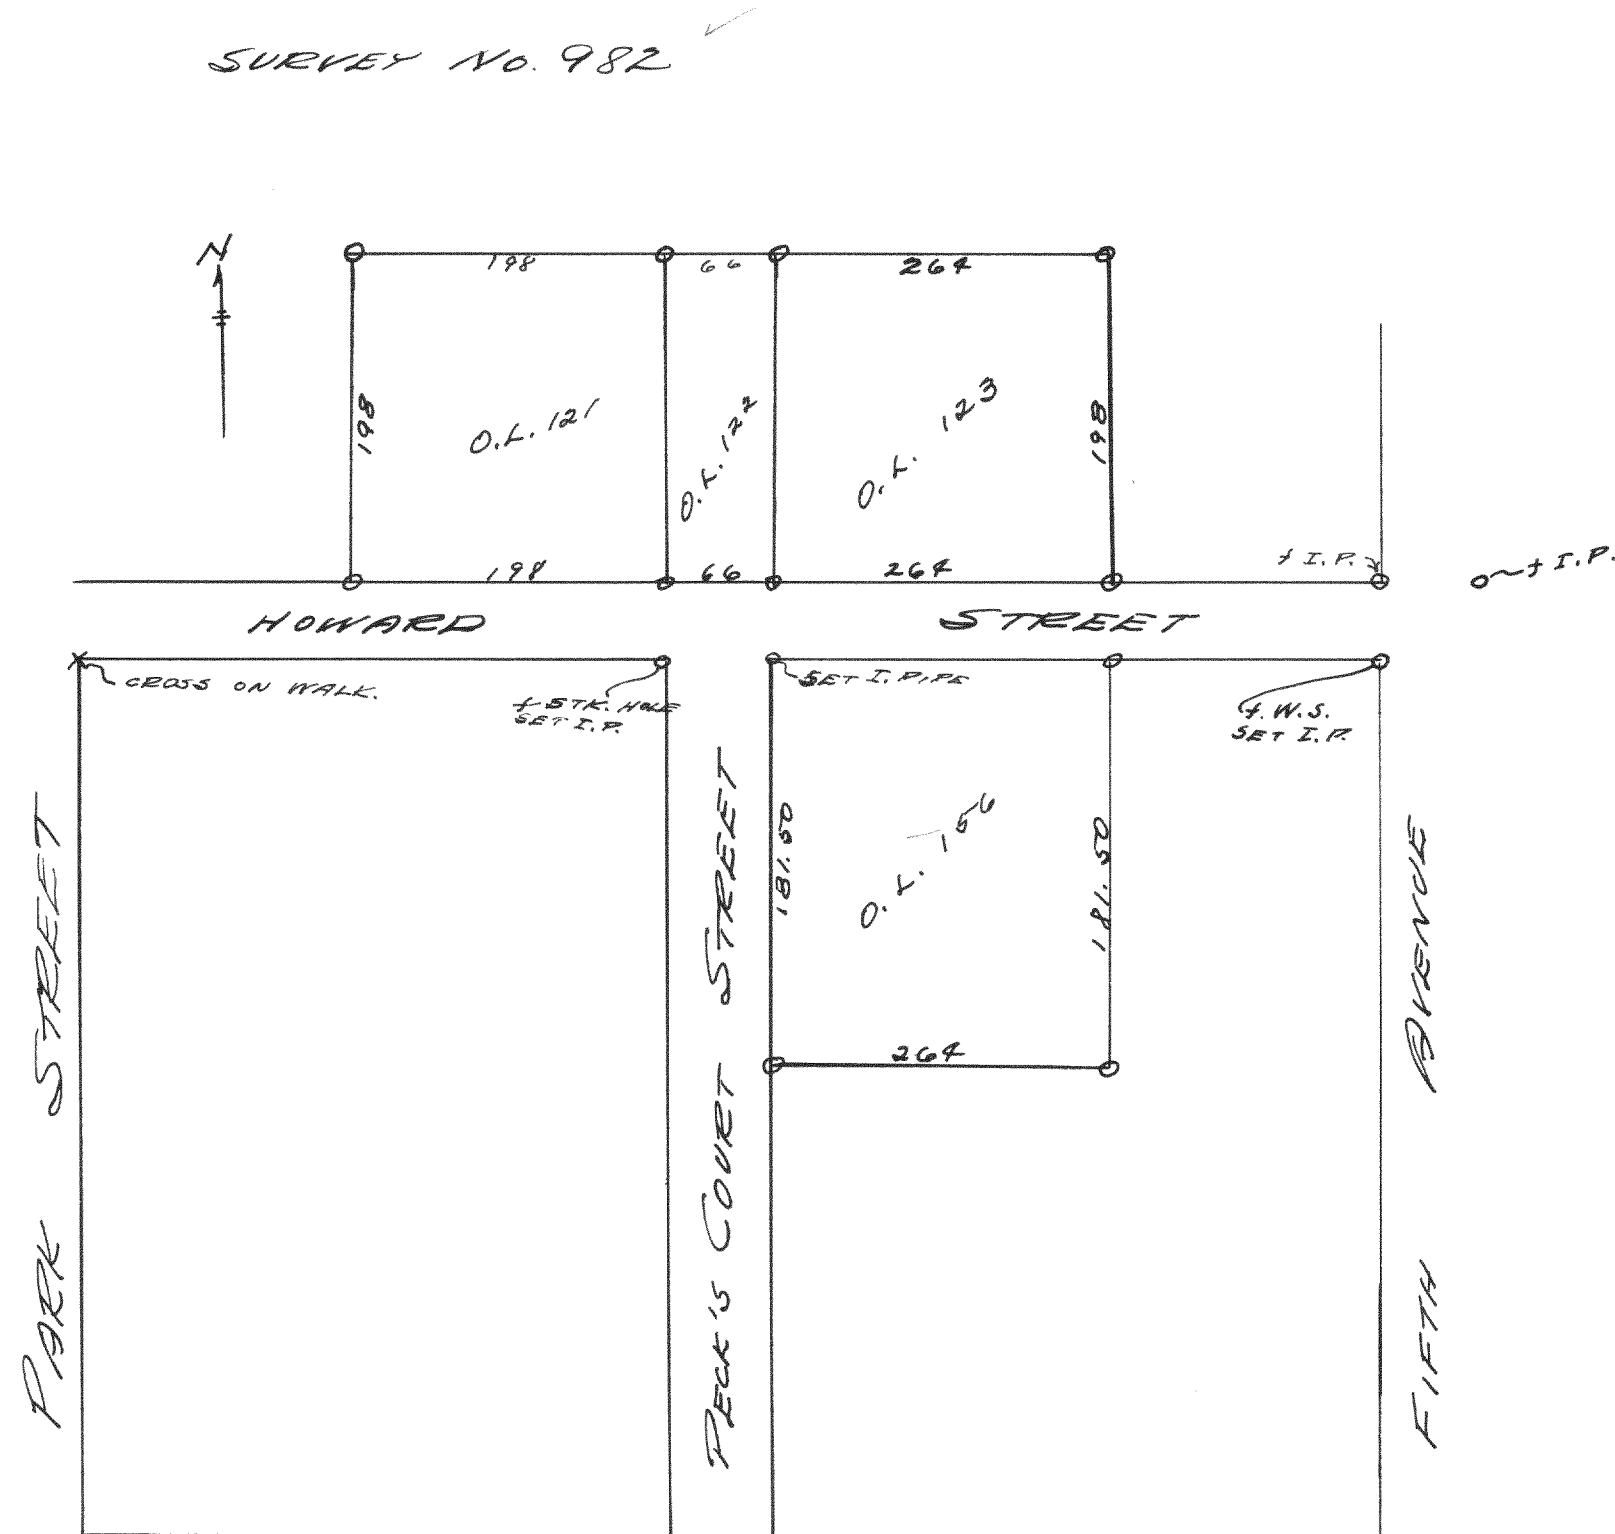

Plat of survey of Outlots 121, 122, 123
and 156 of the Village of Walworth.

June 1939

Lloyd L. Jensen
by H. E. J.