


SURVEY NO. 991

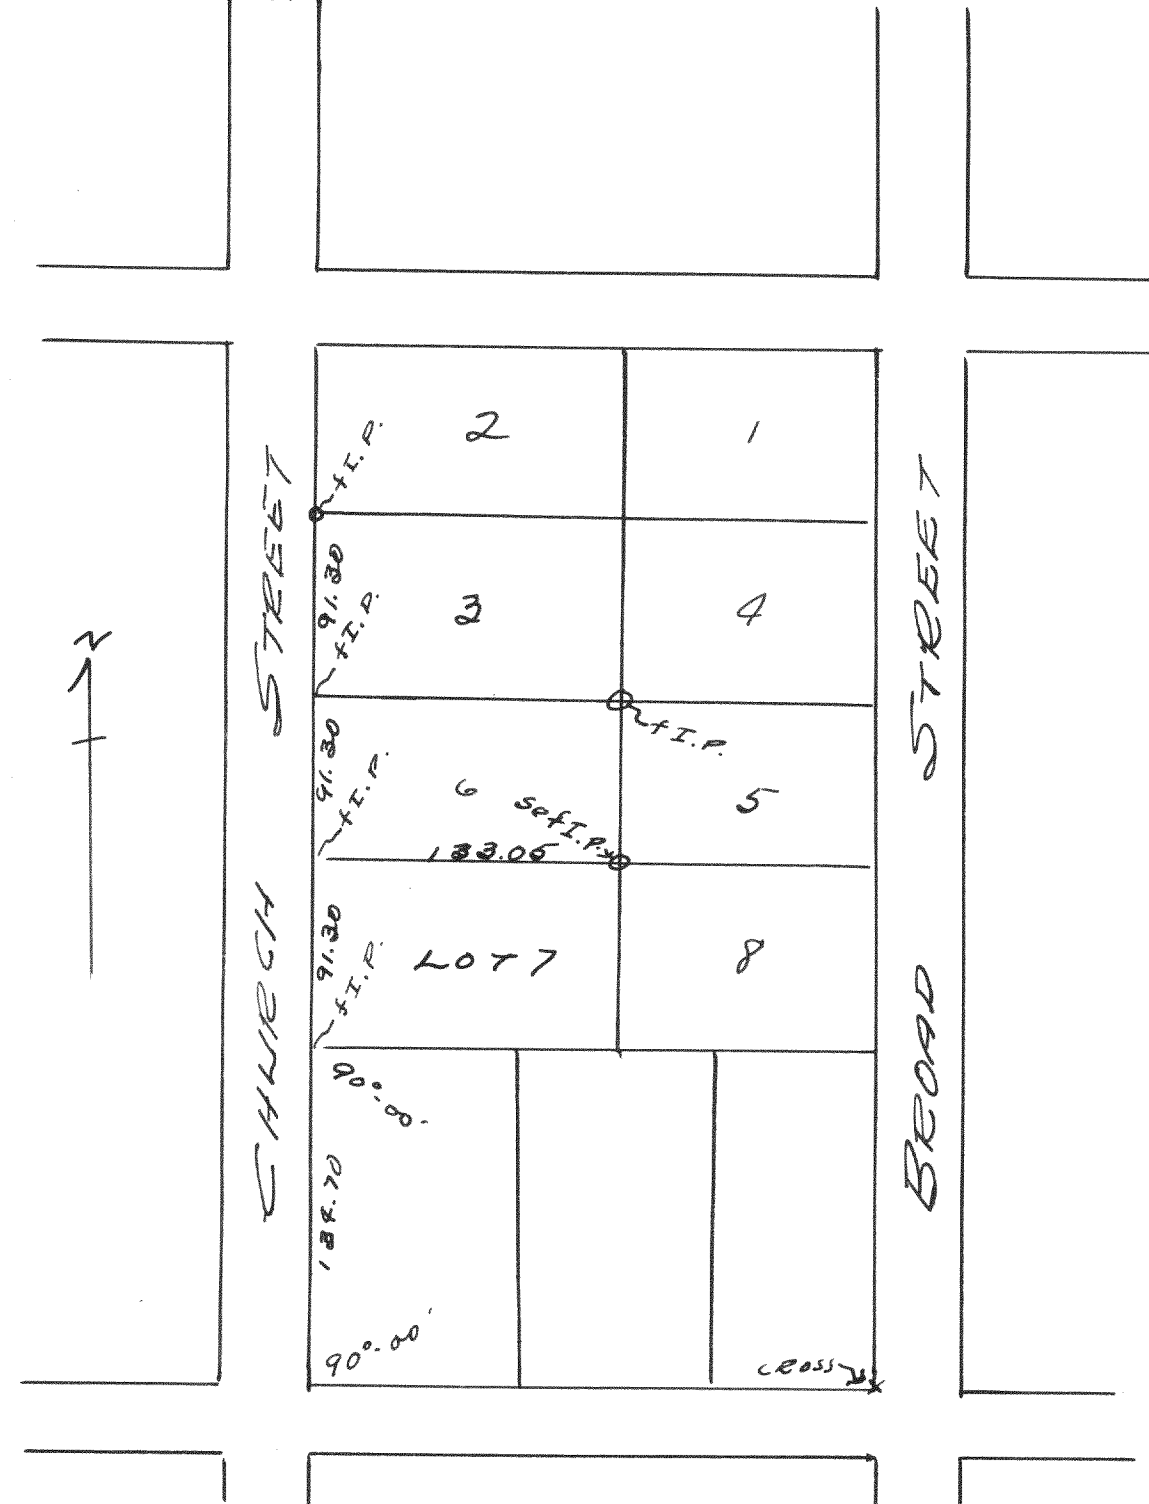


Plat of survey of Lot 7 Block 17
of the original plat of the City of
Elkhorn.

9-16-38

Lloyd L. Jensen
by H. C. J.

SURVEY NO. 992

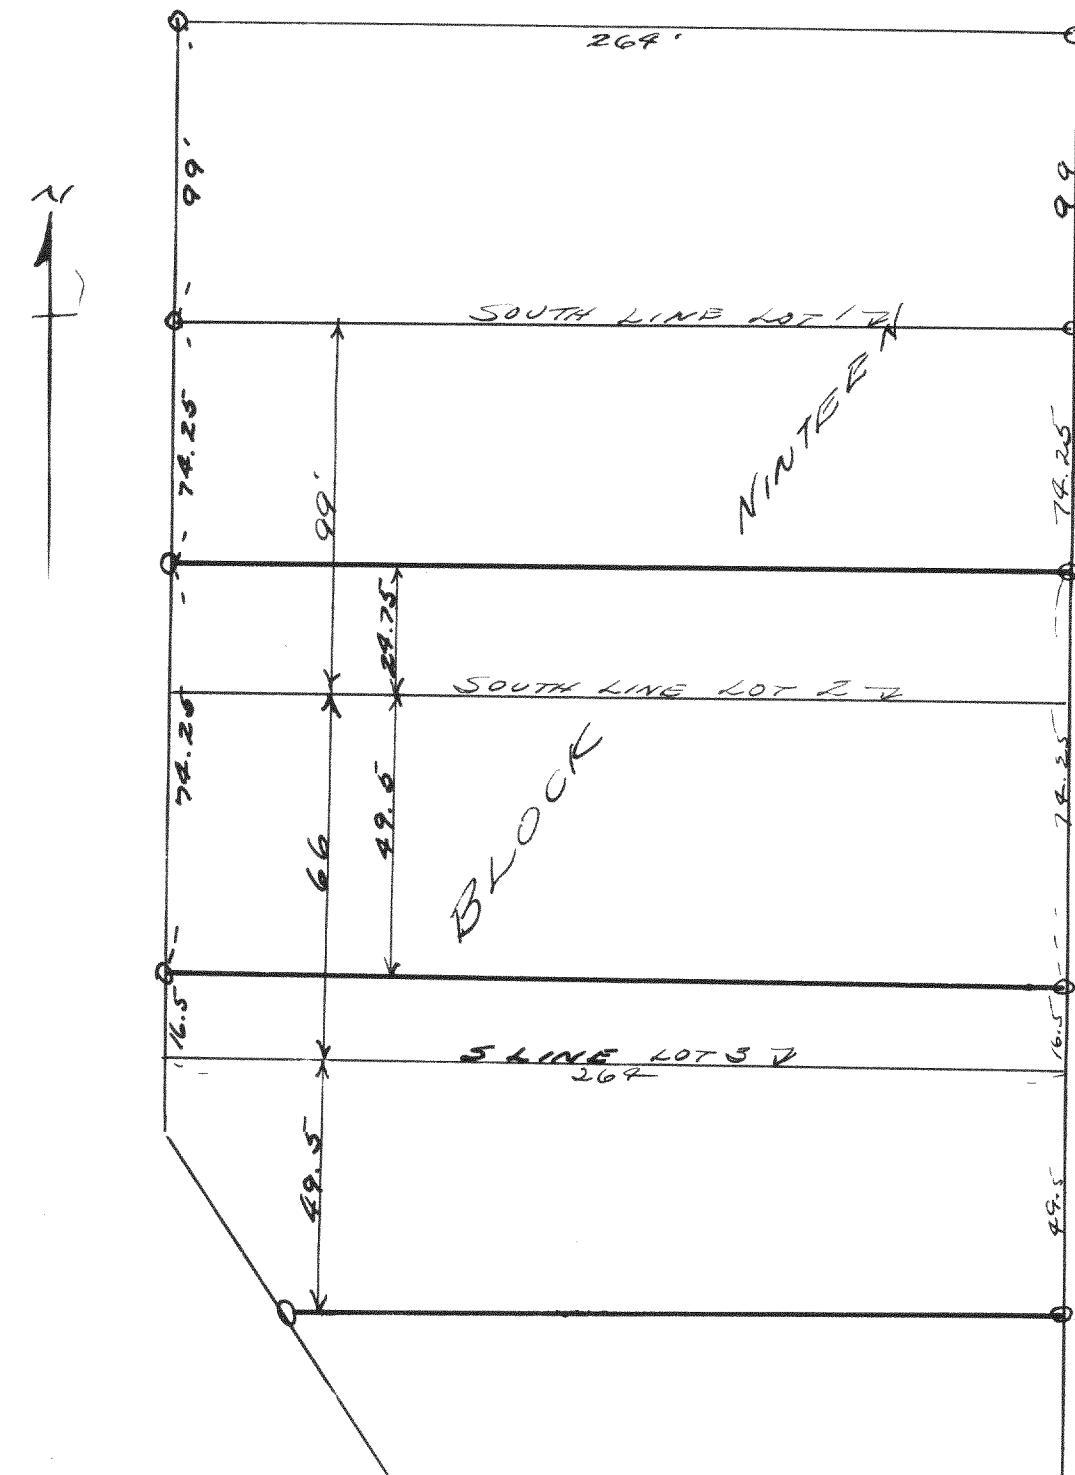

Plot of Survey of lots 2 & 3 of
Block 18 of the Original village
of East Troy,
April 3, 1939 Lloyd L. Jen

Lloyd L. Jensen
by R.E.J.