


SURVEY No. 1003

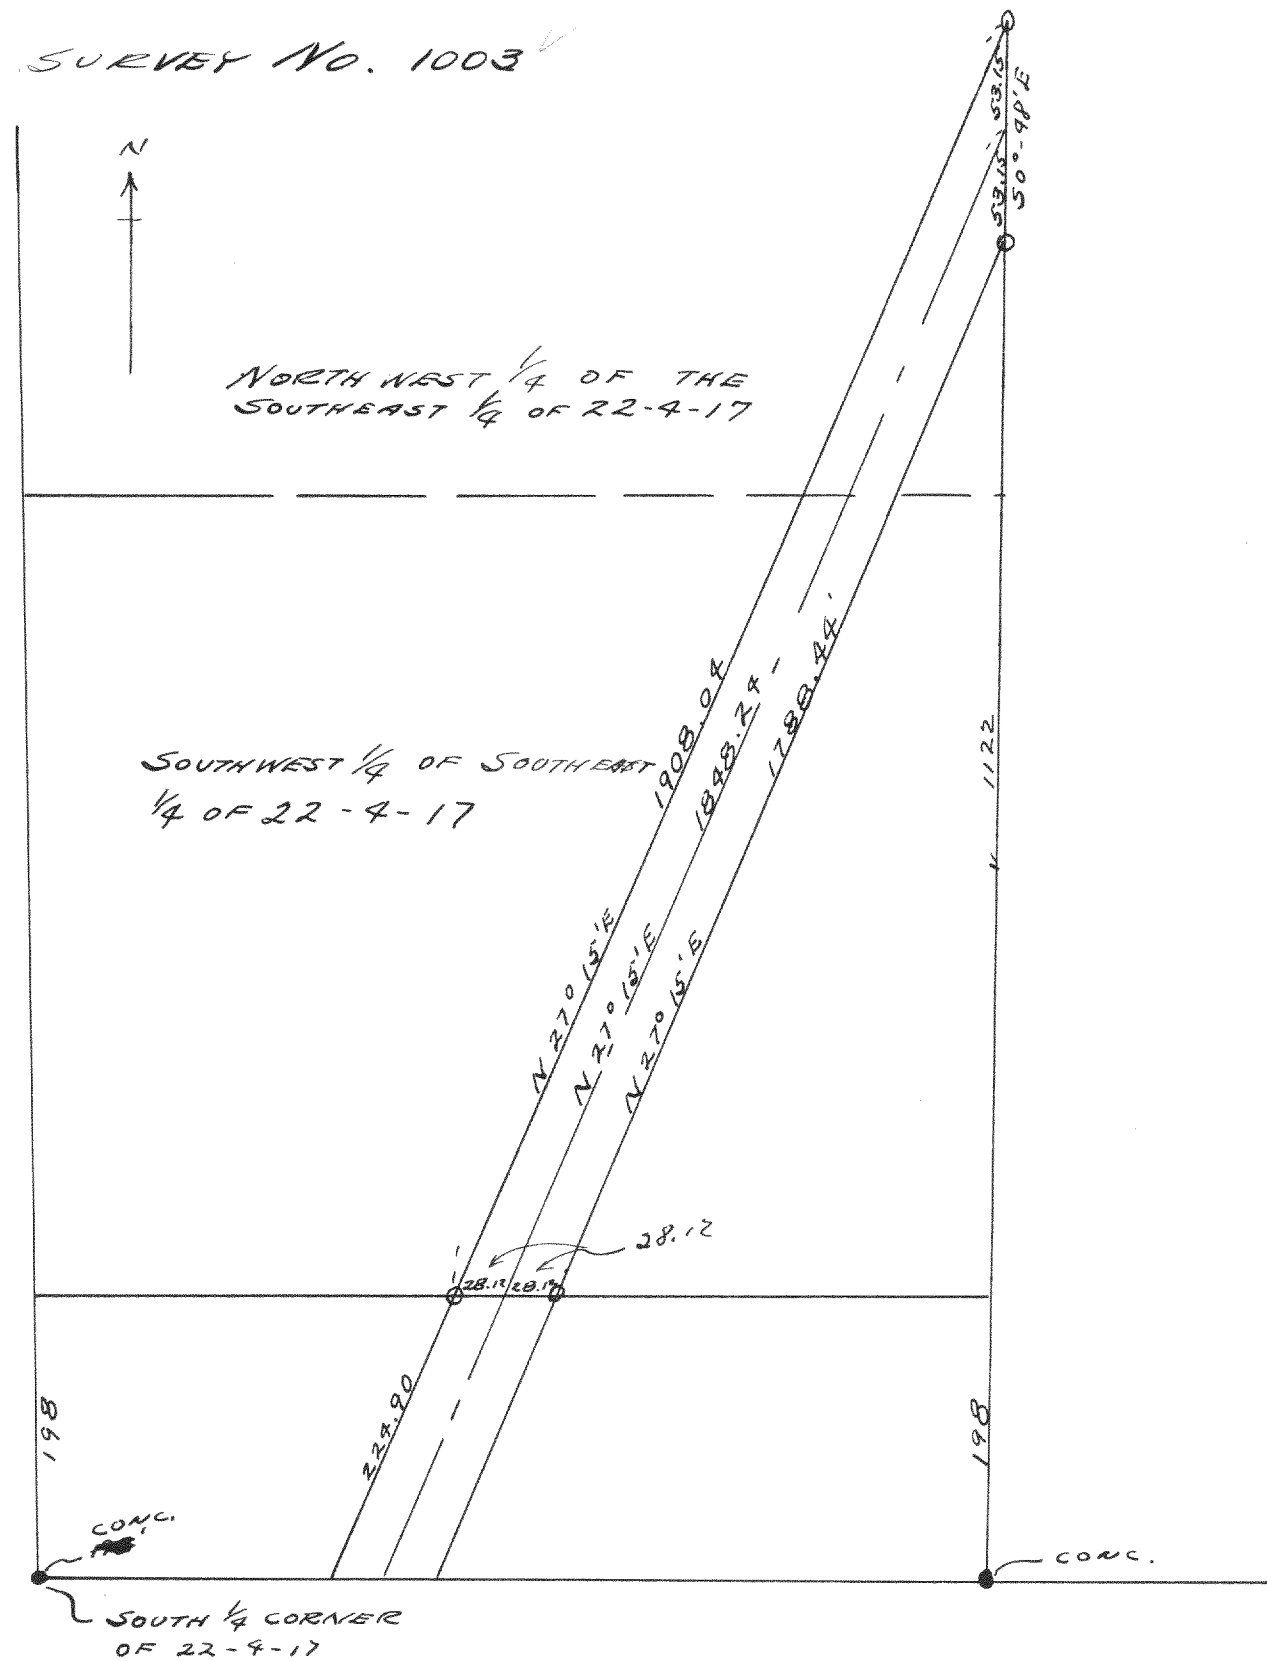


Plat of survey of 50 foot
Right of Way across the
Northwest $\frac{1}{4}$ of the SE $\frac{1}{4}$ of 22-4-17
and part of the SW $\frac{1}{4}$ of the SE $\frac{1}{4}$ of
sec. 22-4-17

June 2, 1939

Lloyd L. Jensen
by N. E. J.

SURVEY No. 1004

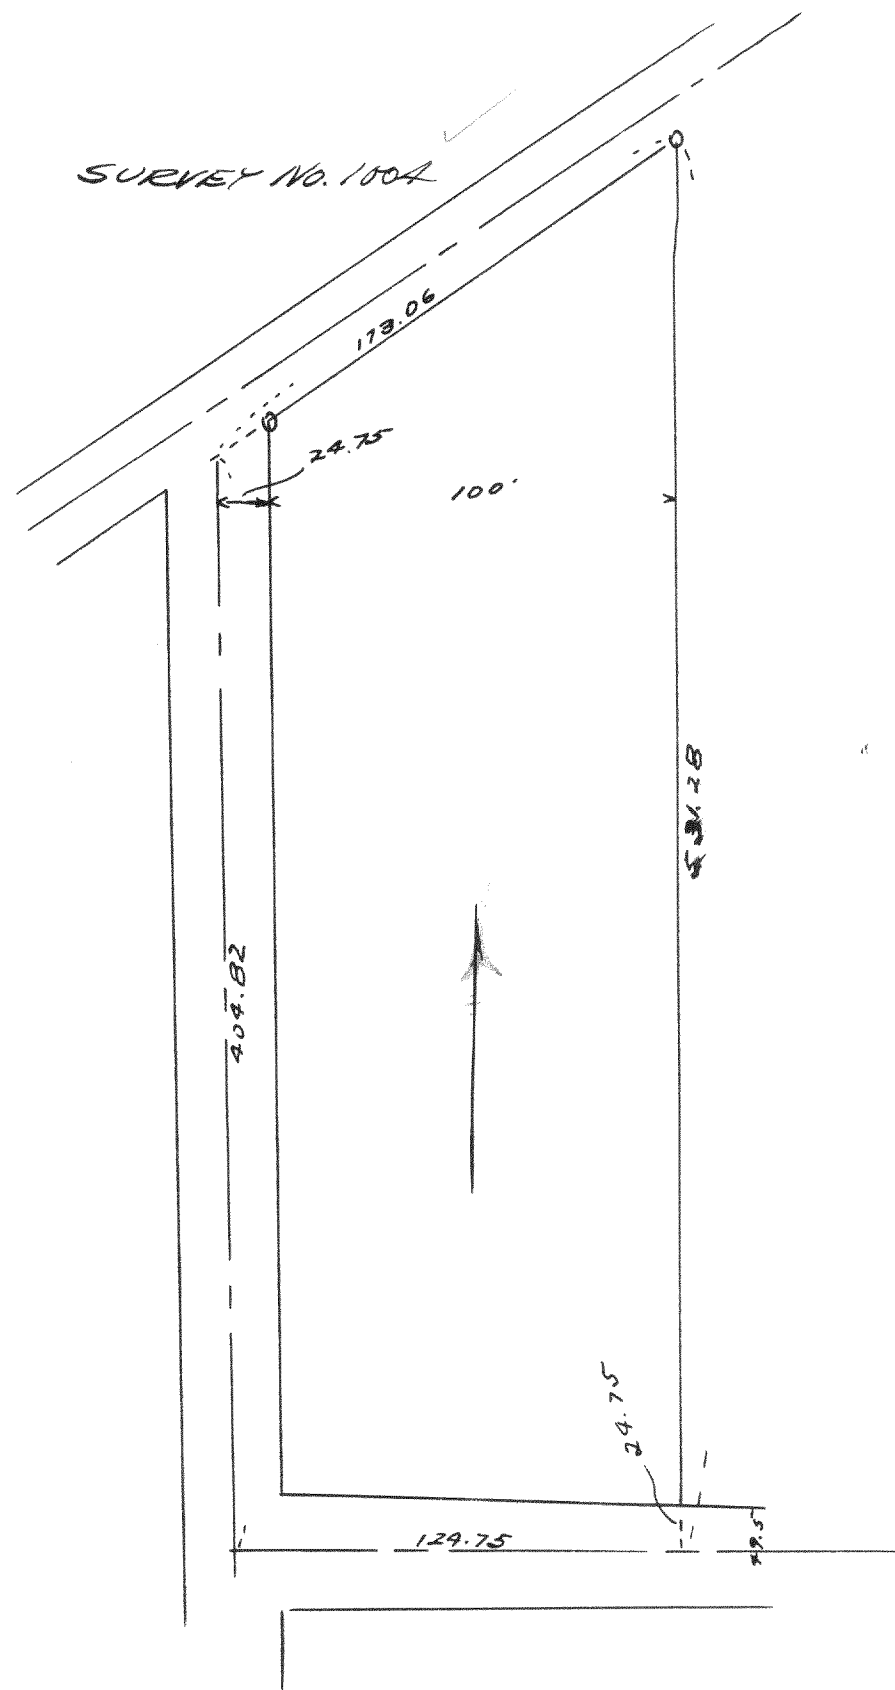


Plat of survey of part of
the northwest $\frac{1}{4}$ of section 33

T2N R17E, Wal. Co. Wis.

Feb. 1939

Lloyd L. Jensen
by N. E. J.

SURVEY No. 1005

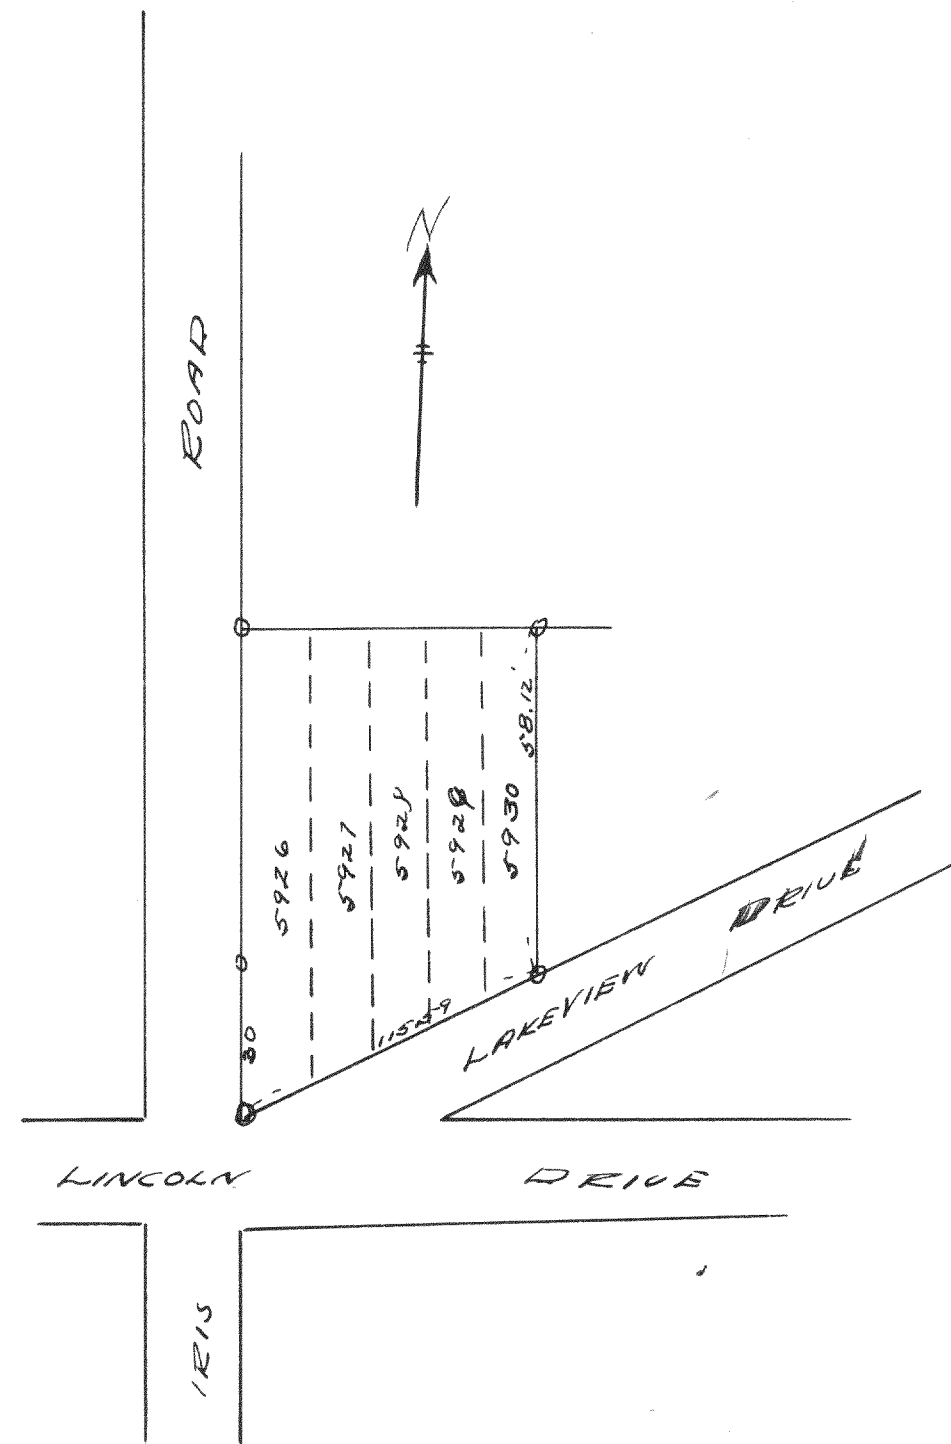

Plat of survey of lots
5926 to 5930 of Lake Como
Beach Subd. Wal. Co. Wis.

July 7, 1939

Lloyd L. Jensen
by N. E. J.