



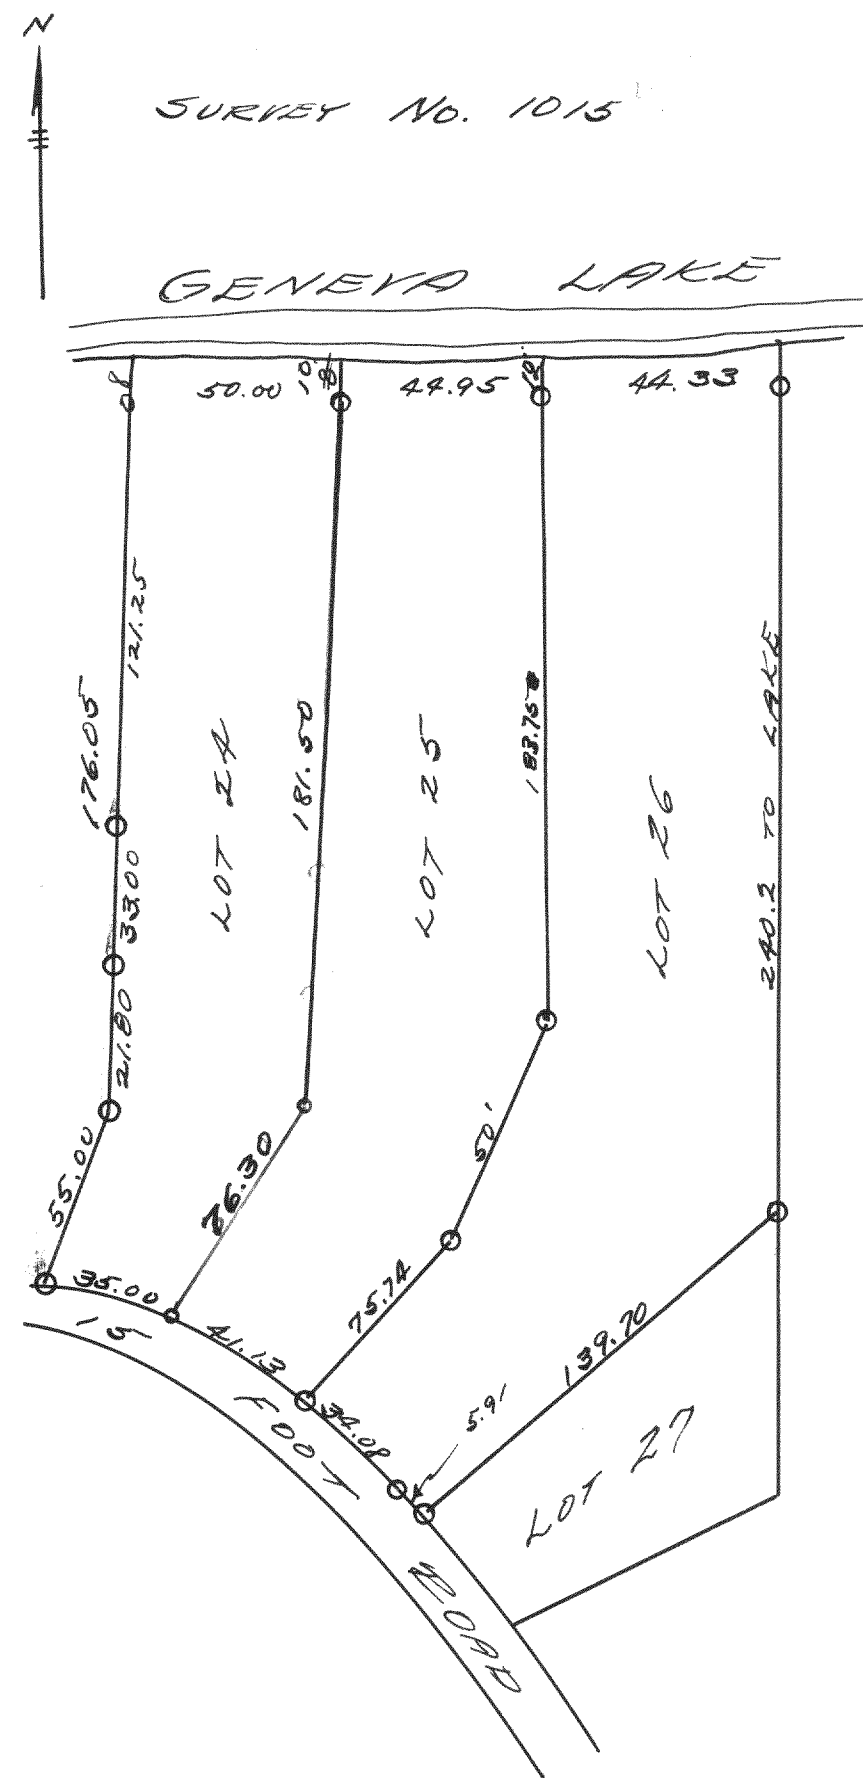

Survey of lots 24, 25 & 26
of Block One of Indian Hills
Subdivision, Walworth County,
Wisconsin.
Sept. 19, 1939
Lloyd L. Jensen
L.E.J.

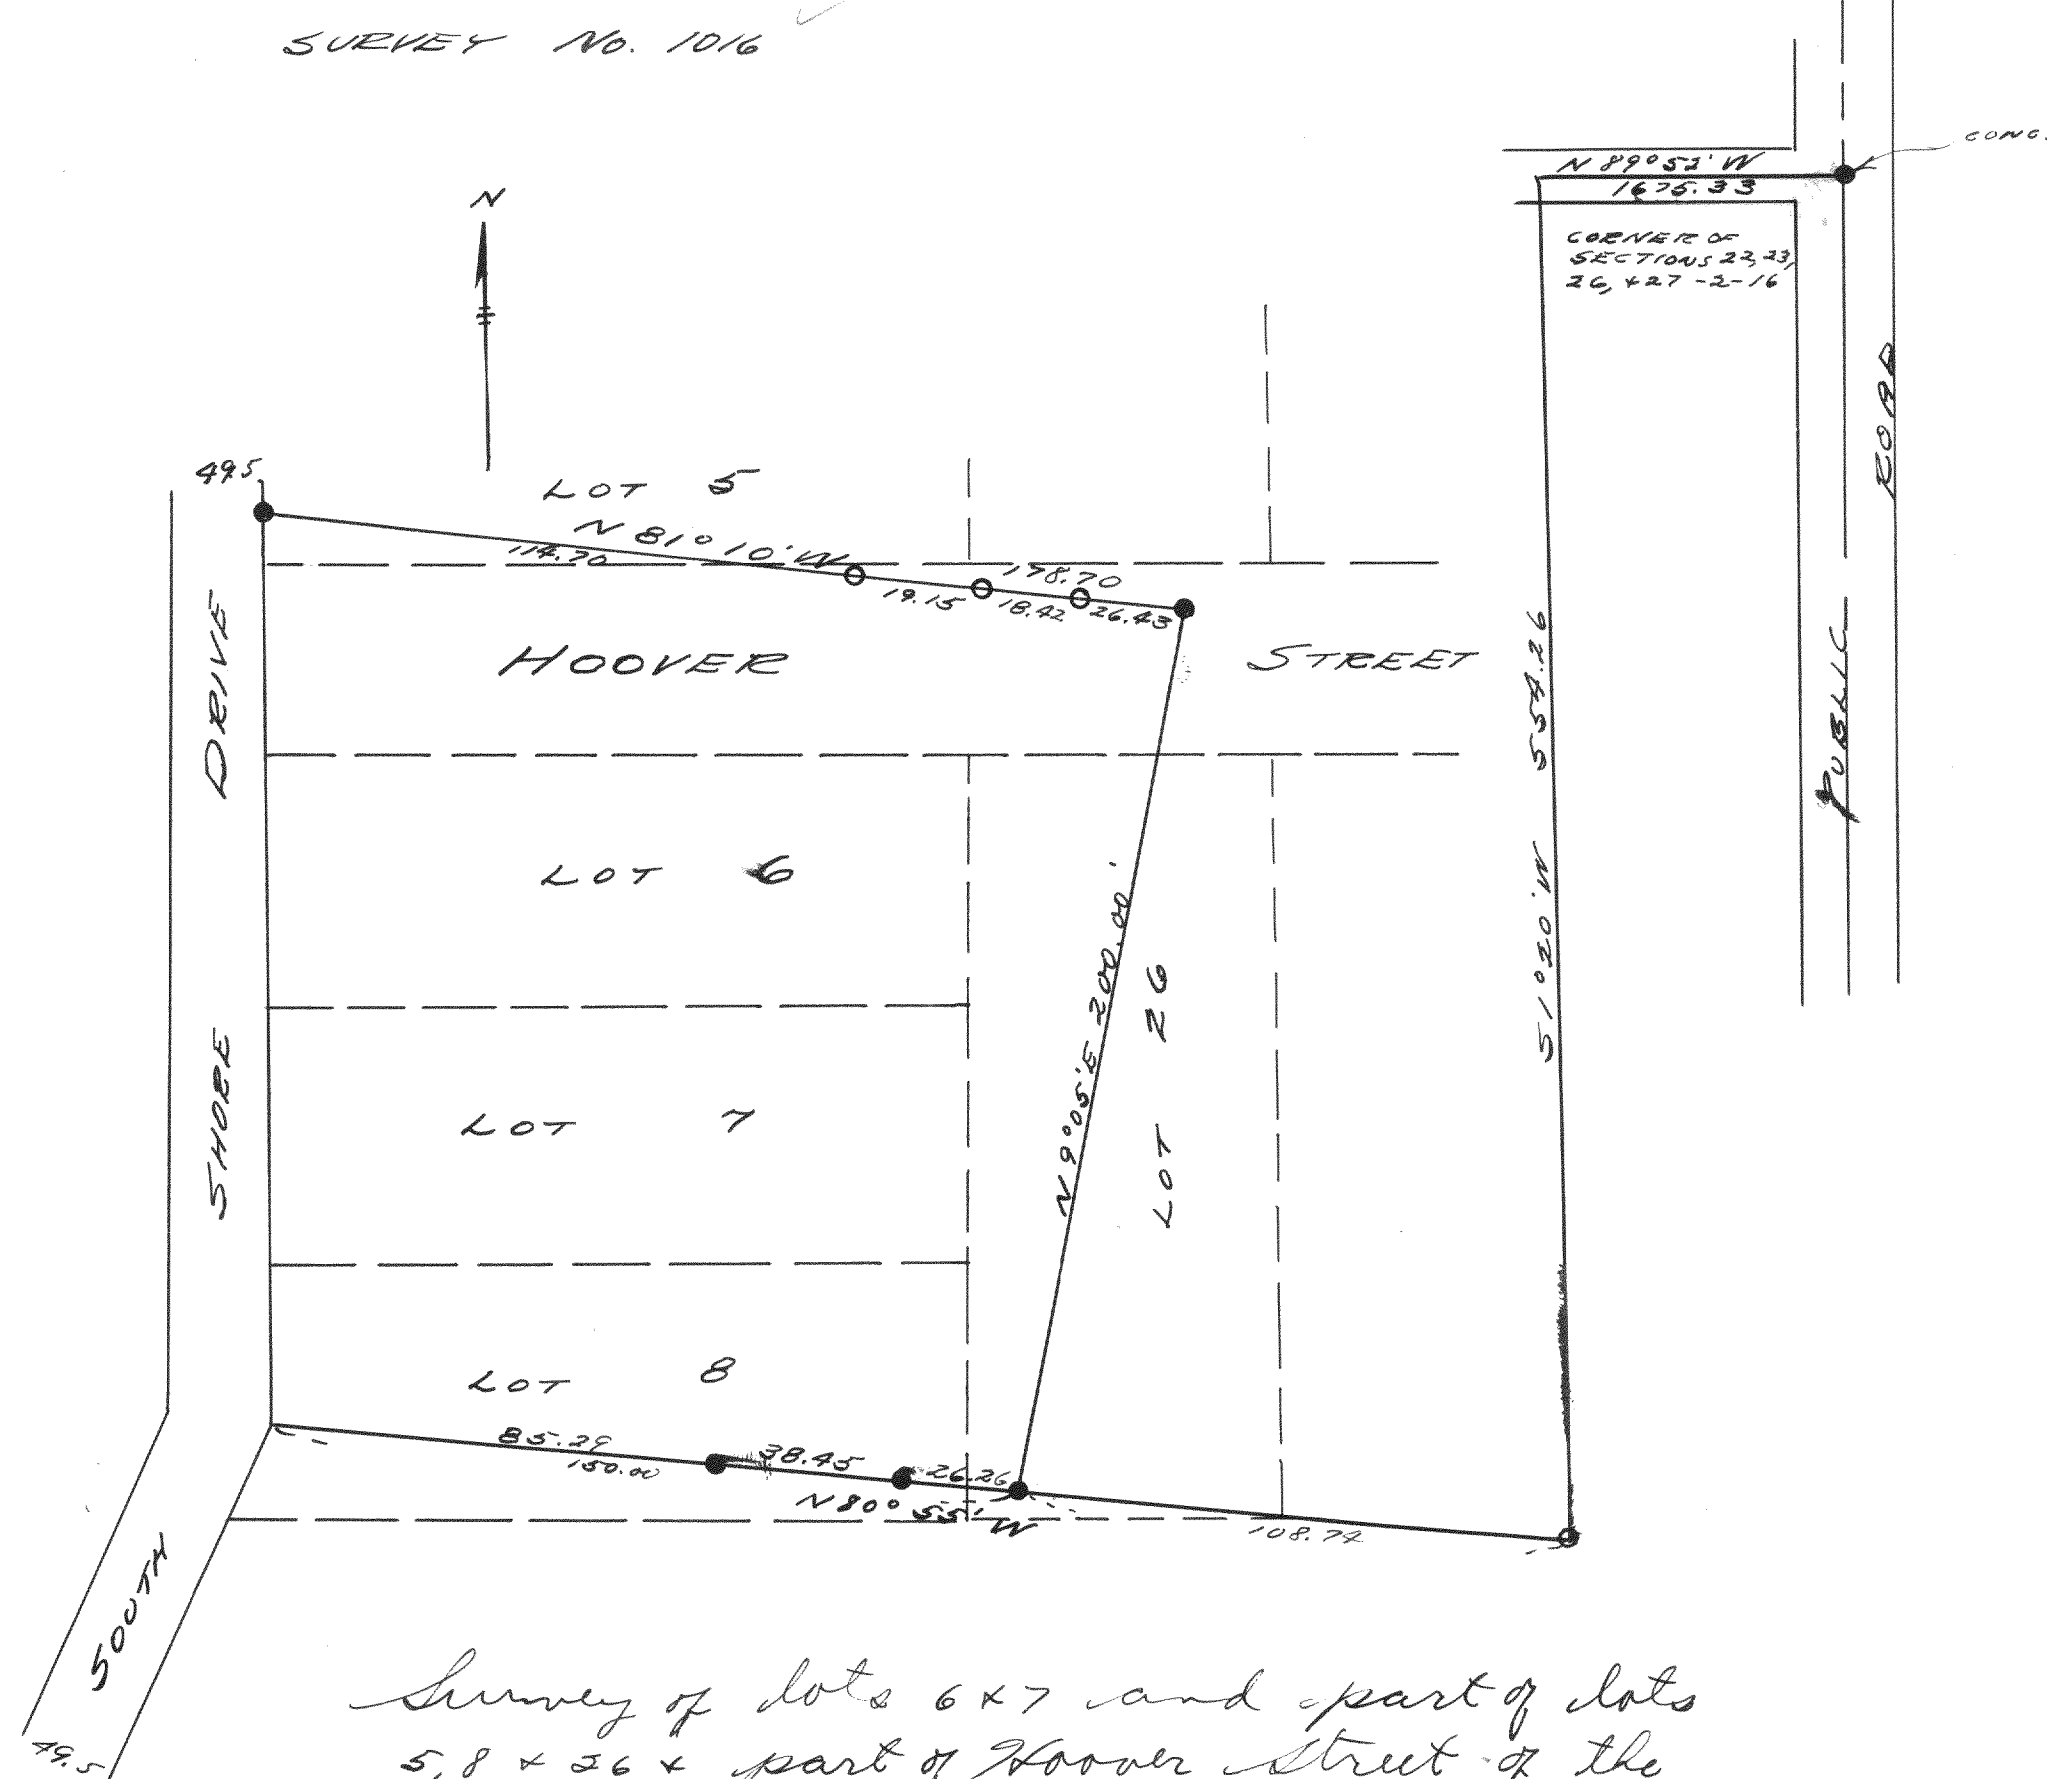

Survey of lots 6 & 7 and part of lots
5, 8 & 26 & part of Hoover Street of the
unrecorded plat of Holig's woods being
a part of the NE 1/4 of section 27
T2N R16E, Walworth County, Wisconsin
Nov. 1939
Lloyd L. Jensen
L.E.J.