



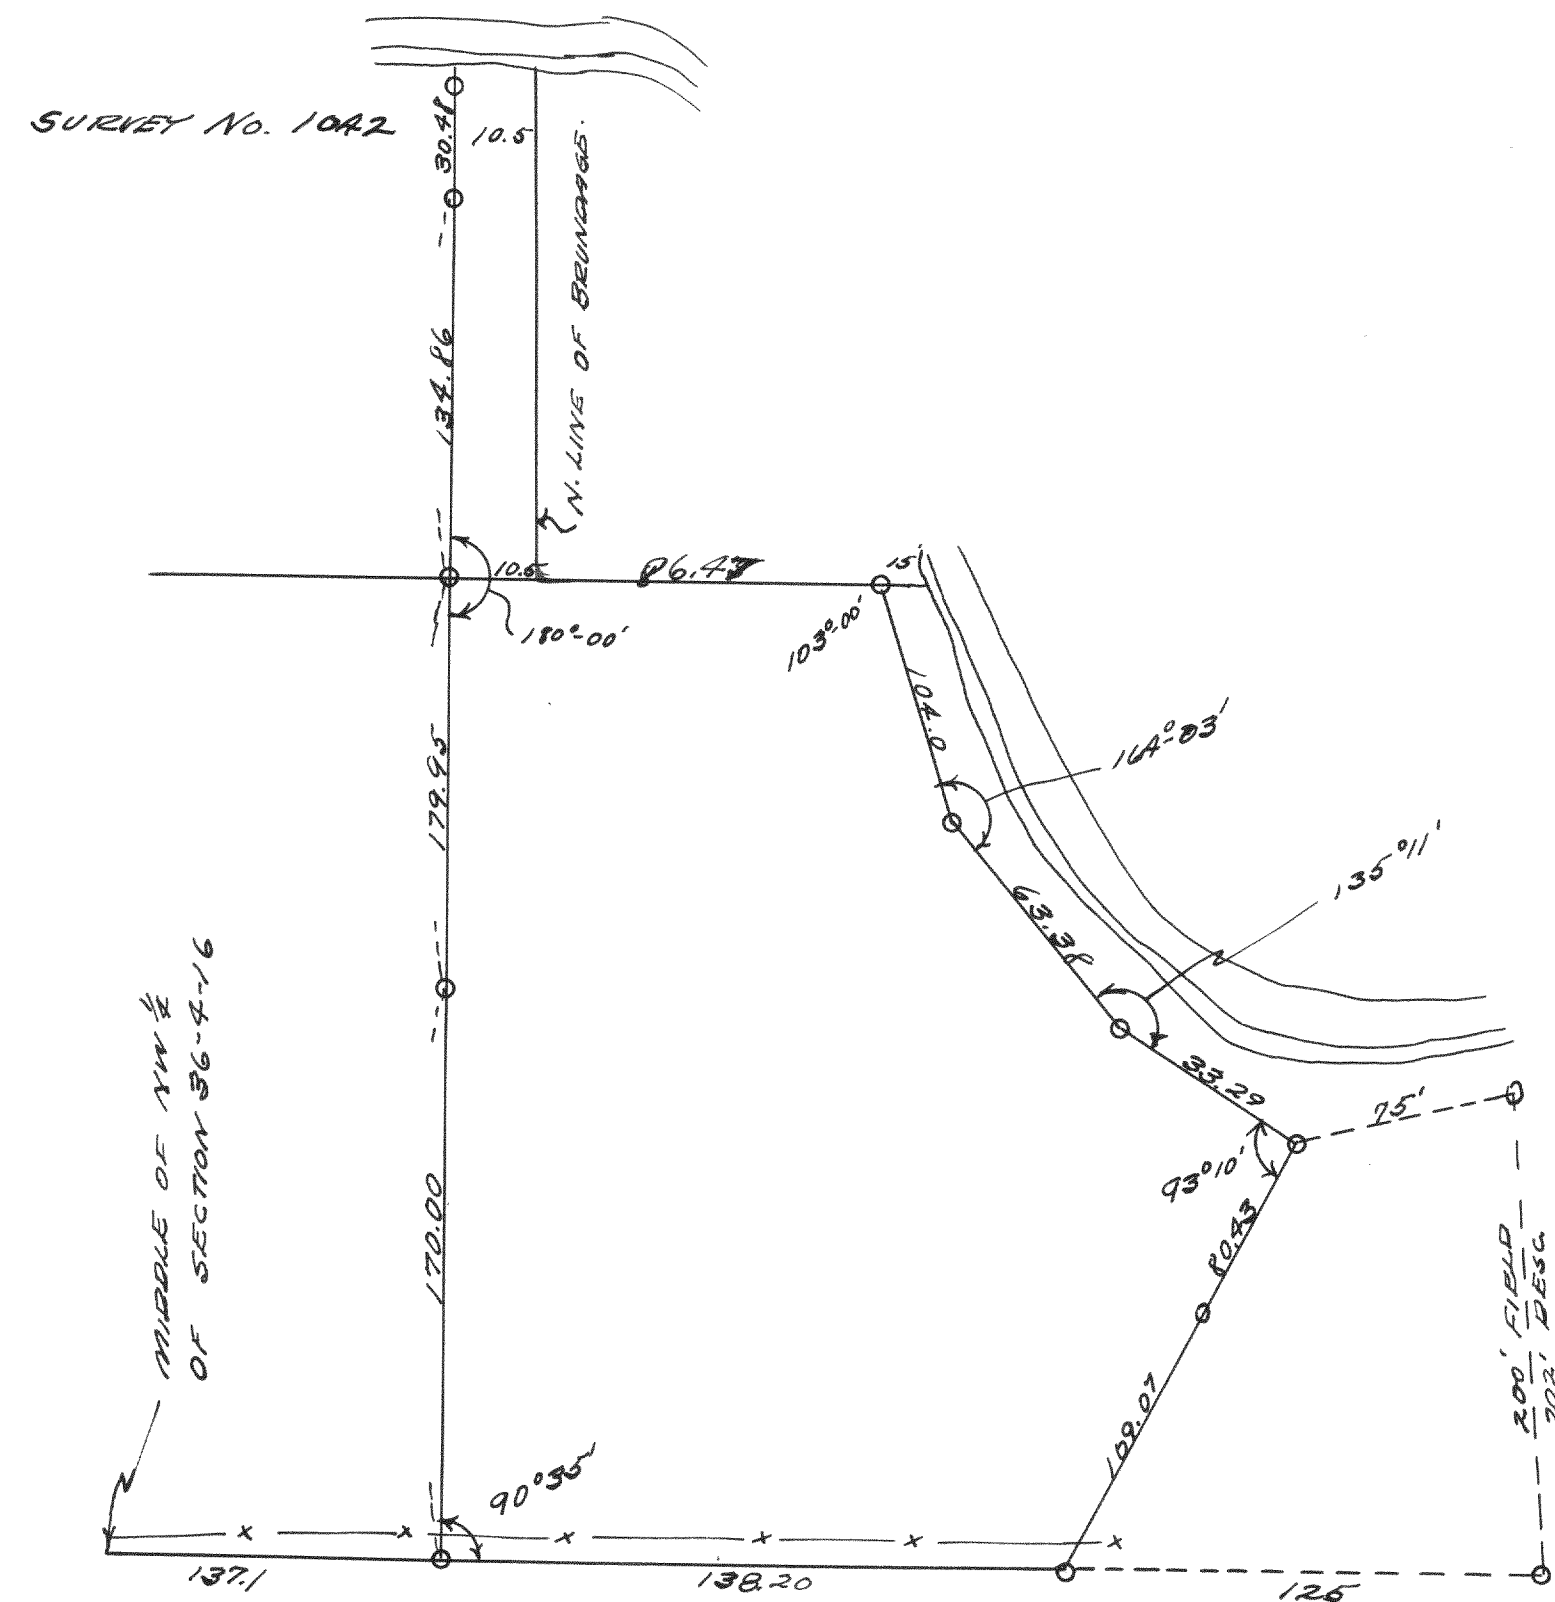

Survey of land in the NW. 1/4 of section
36 T4N E16E of Walworth County, Wisconsin

July 13, 1937

Lloyd L. Jensen
by K. E. J.

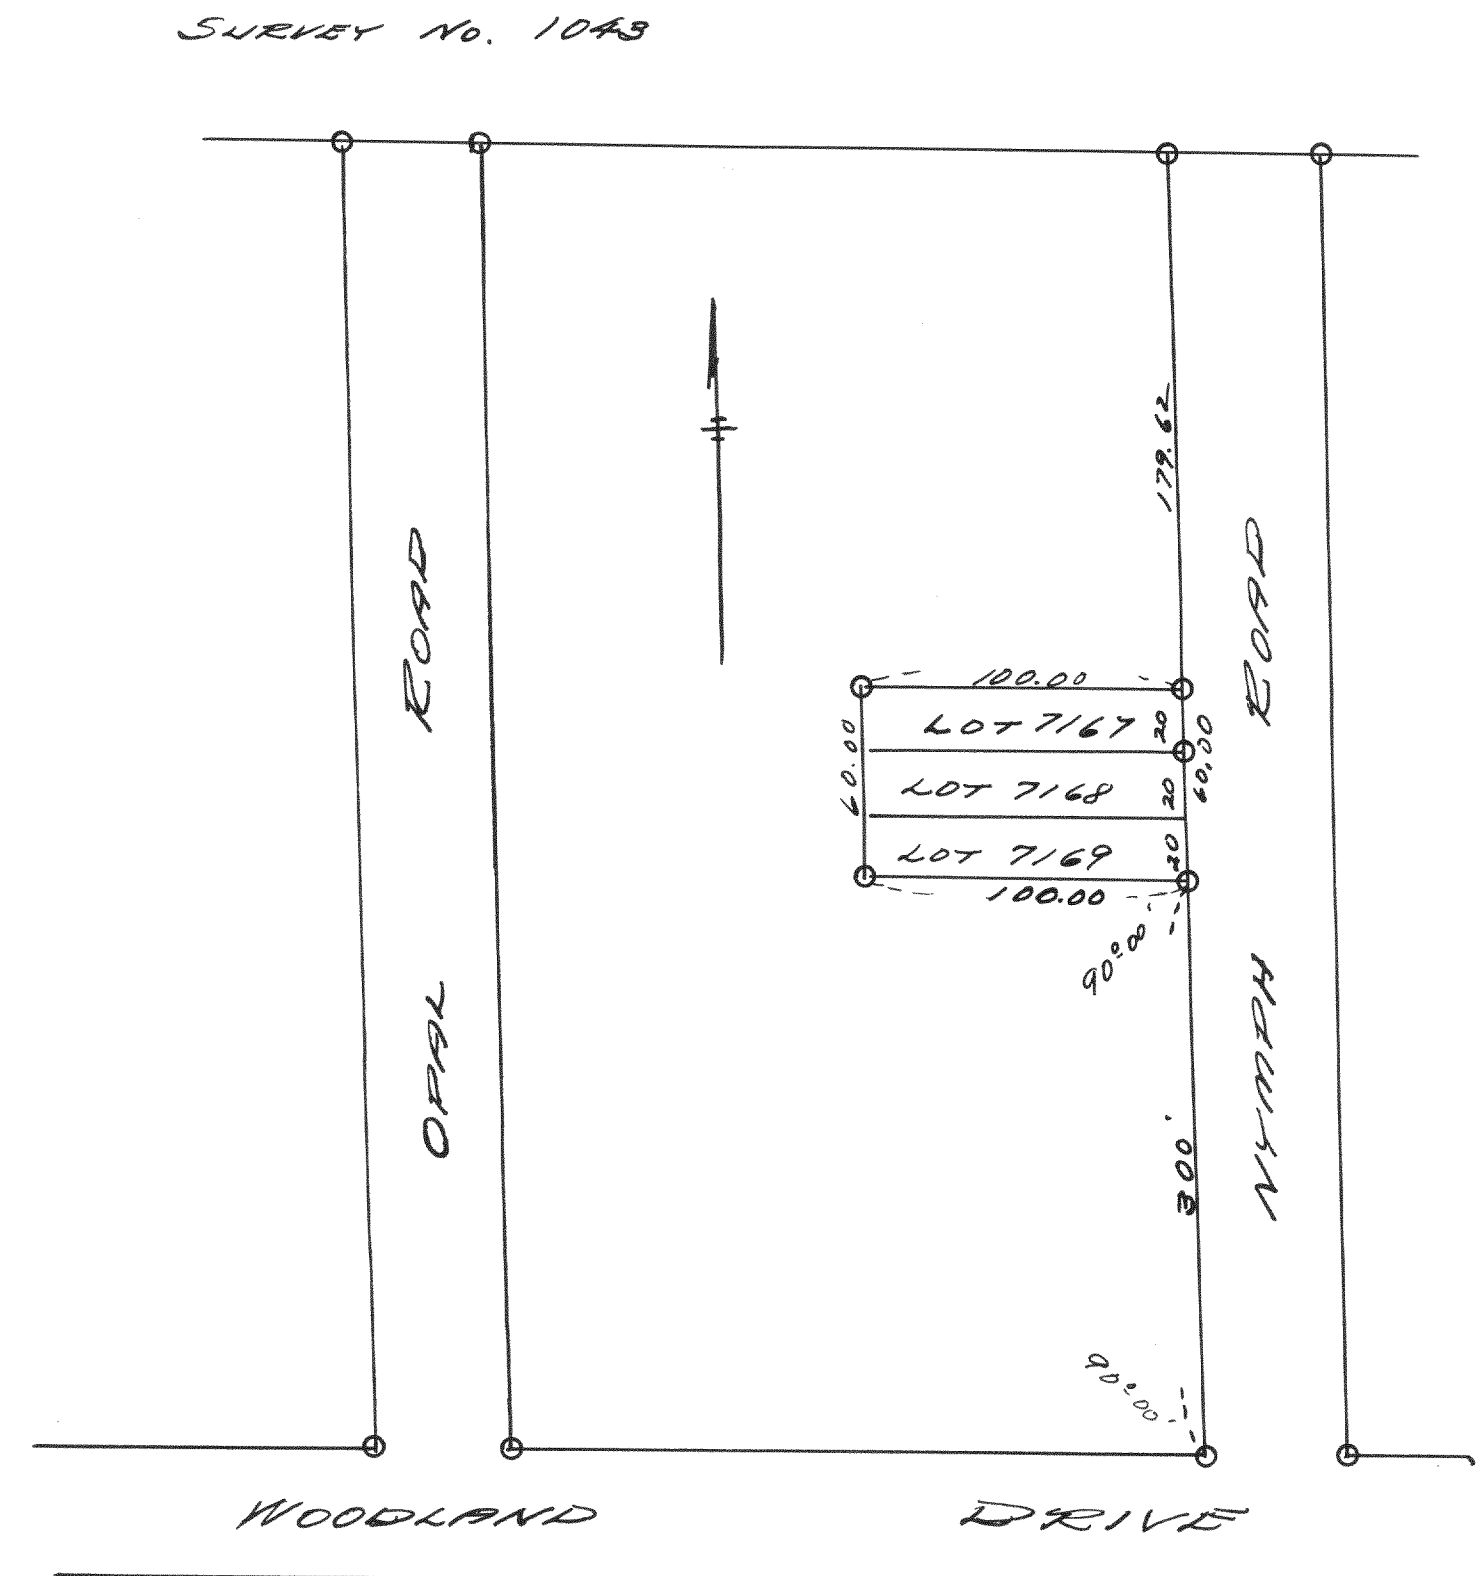

Survey of Land in Lake Como
Beach Subdivision T2N R17E
of Walworth County, Wisconsin

Nov. 10, 1939

Lloyd Jensen
by R. E. J.