




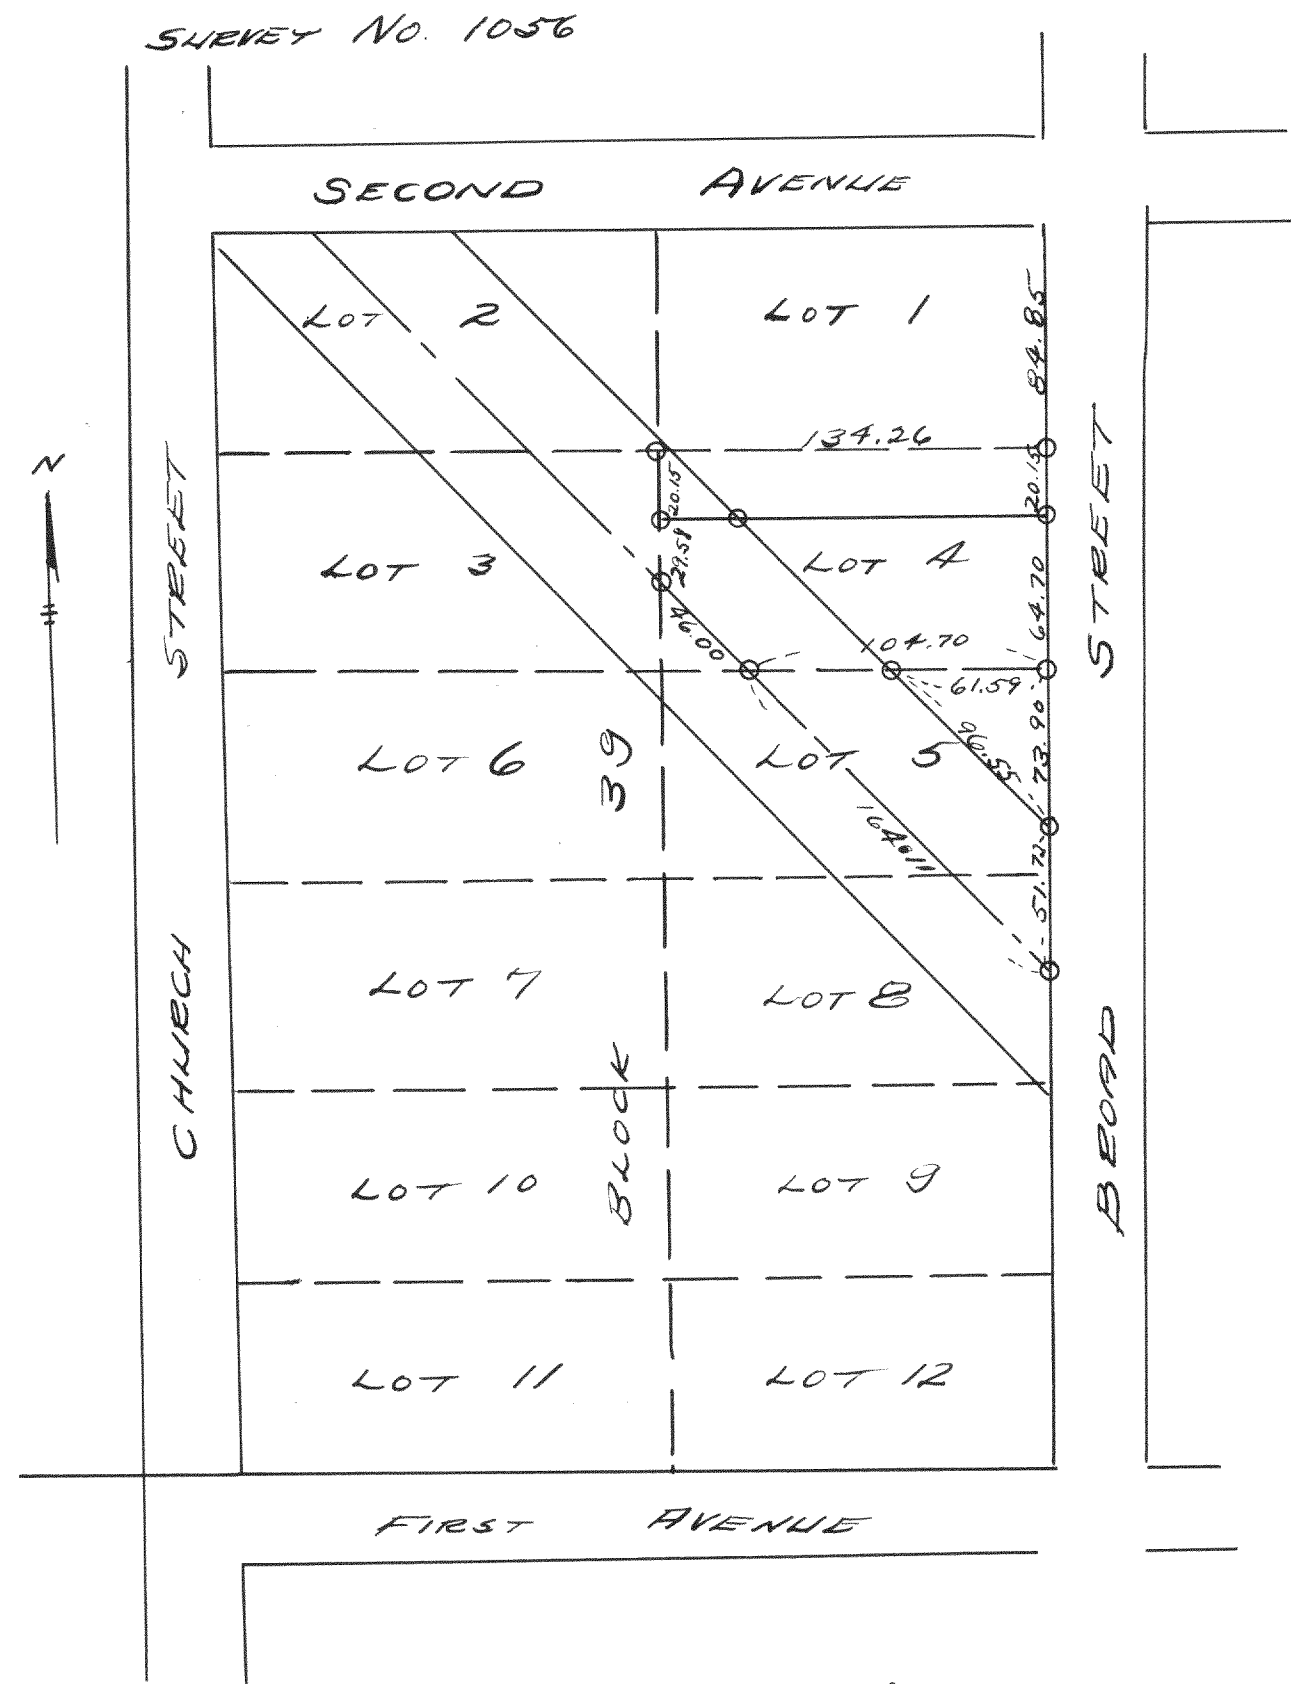

Survey of part of lots 4 & 5 of
Block 39 of Davis' Addition to
the City of Elkhorn, Walworth
County, Wisconsin.
Dec. 1939 Lloyd L. Jensen
by K.E.J.

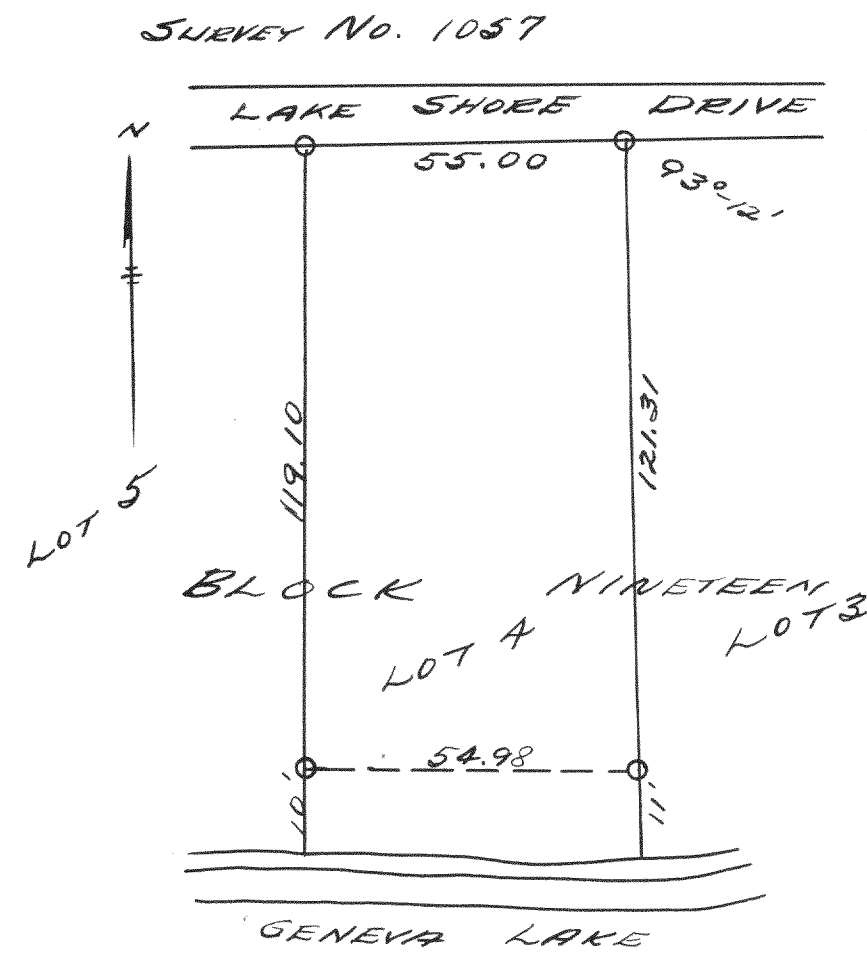

Survey of lot 4 of Block 19
of Lake Geneva Manor
in the City of Lake Geneva,
Walworth County, Wisconsin
Nov. 1939 Lloyd L. Jensen
by K.E.J.

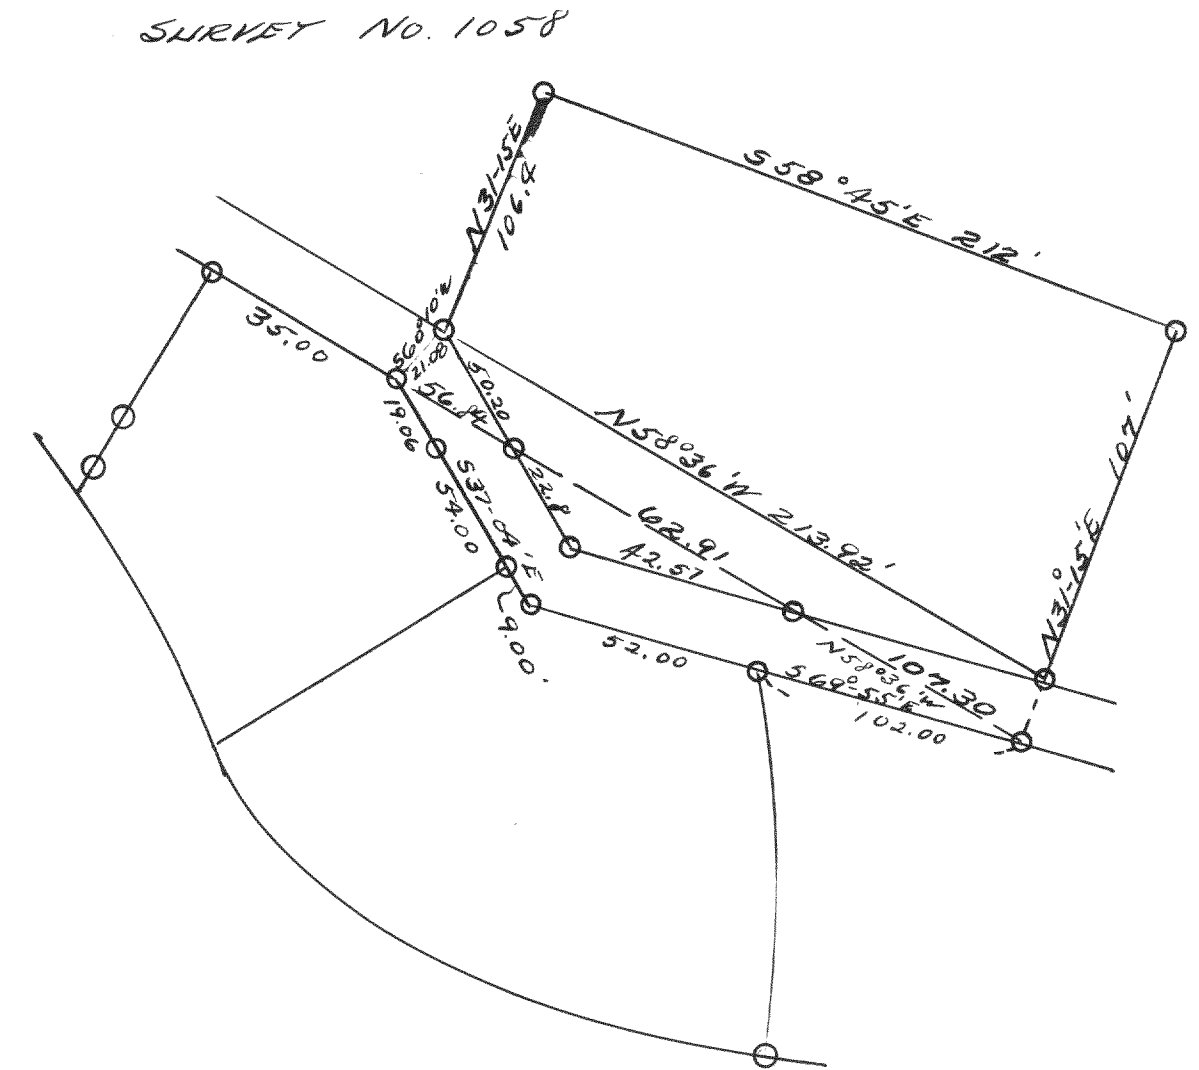

Survey of part of lots 11 & 20
and of present roadway
between said lots 11, 20 & 21
as shown on the revised
plat of The Gardens, Village
of Montandon-on-Geneva-Lake
Nov. 15, 1939 Lloyd L. Jensen
by K.E.J.