


SURVEY No. 1059

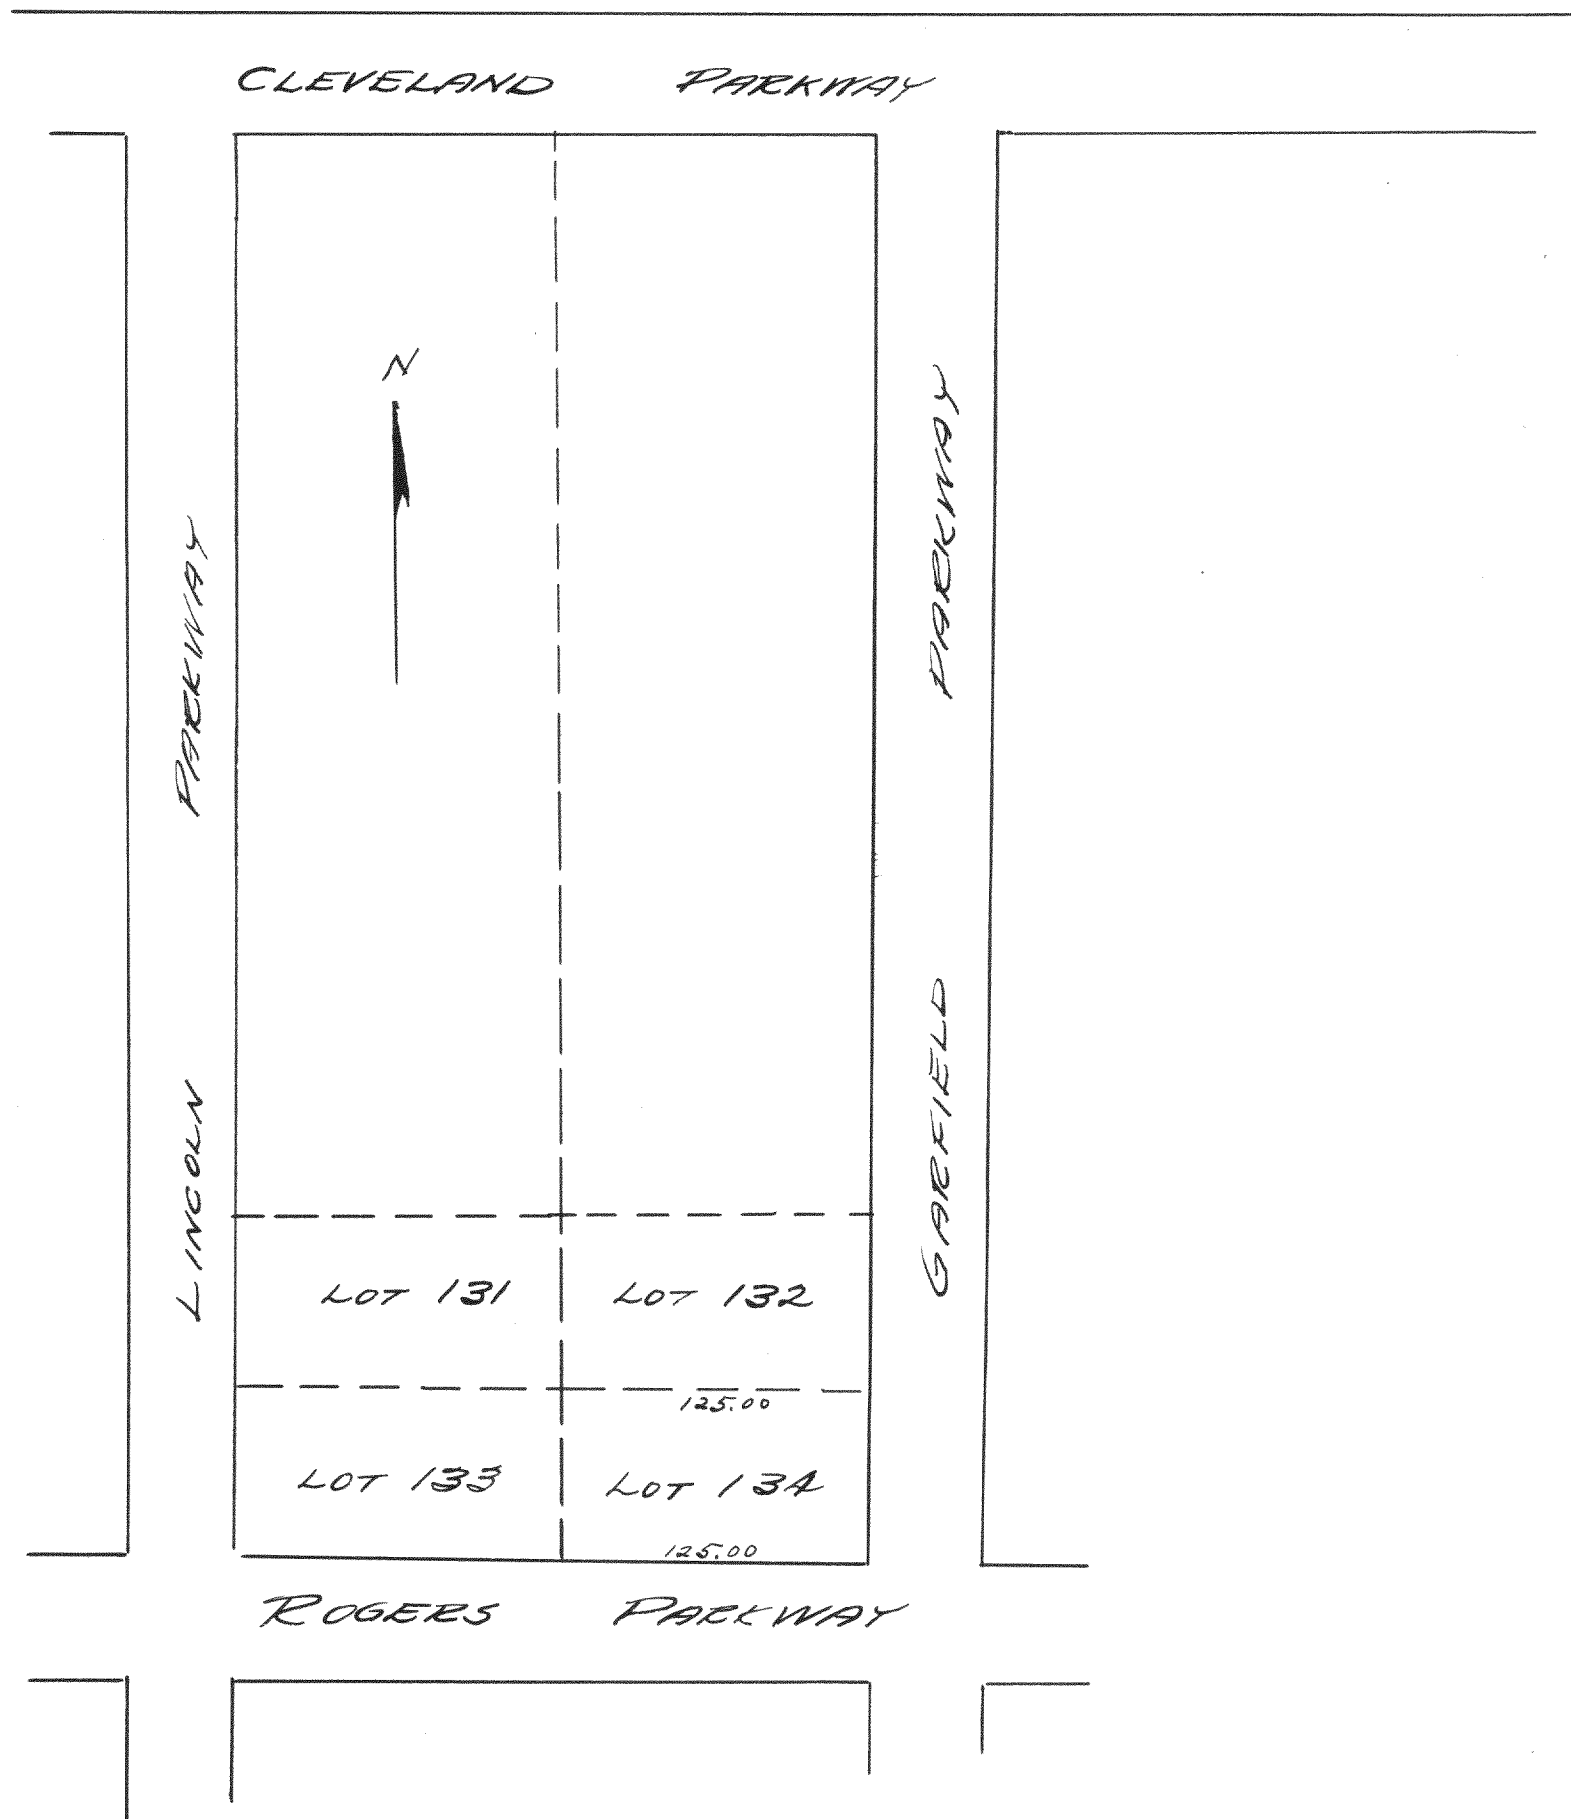


Survey of lot 134 of the original
Cedar Point Park Subdivision
in the Village of Wm. Bay, Walworth
County, Wisconsin

Nov. 1939

Lloyd L. Jensen
by T.E.J.

SURVEY No. 1060

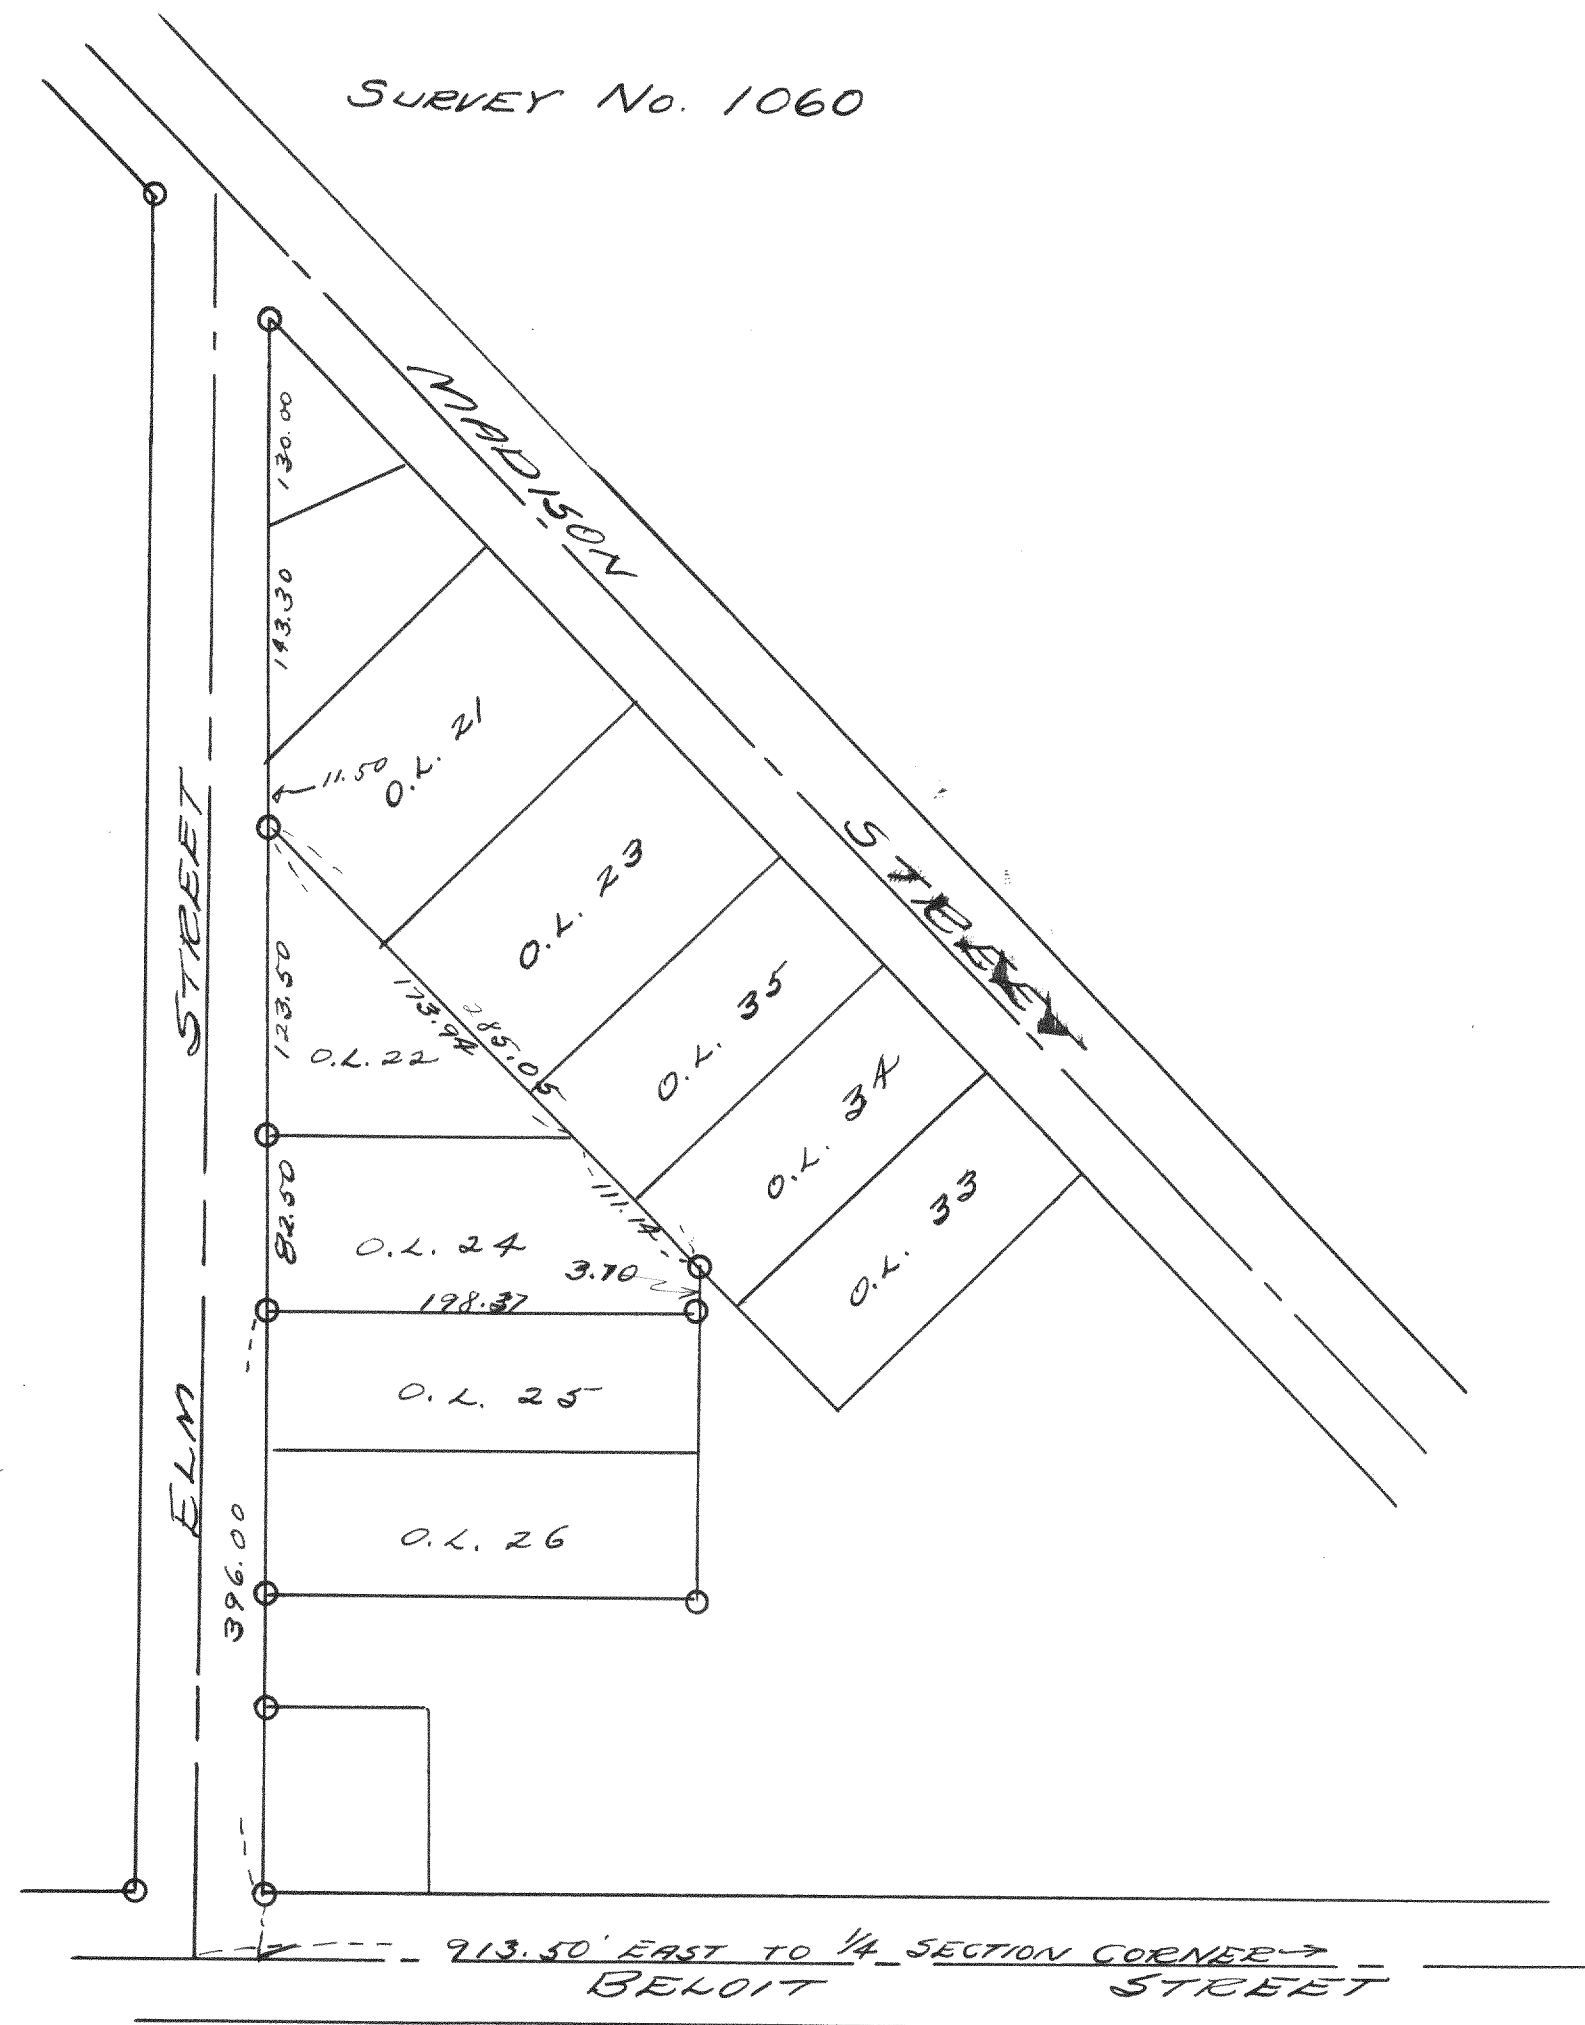

Survey of outlots 22 & 24 of the Village
of Walworth, Walworth County, Wisc.

Dec. 14, 1939

Lloyd L. Jensen
by T.E.J.