



SURVEY NO. 1064

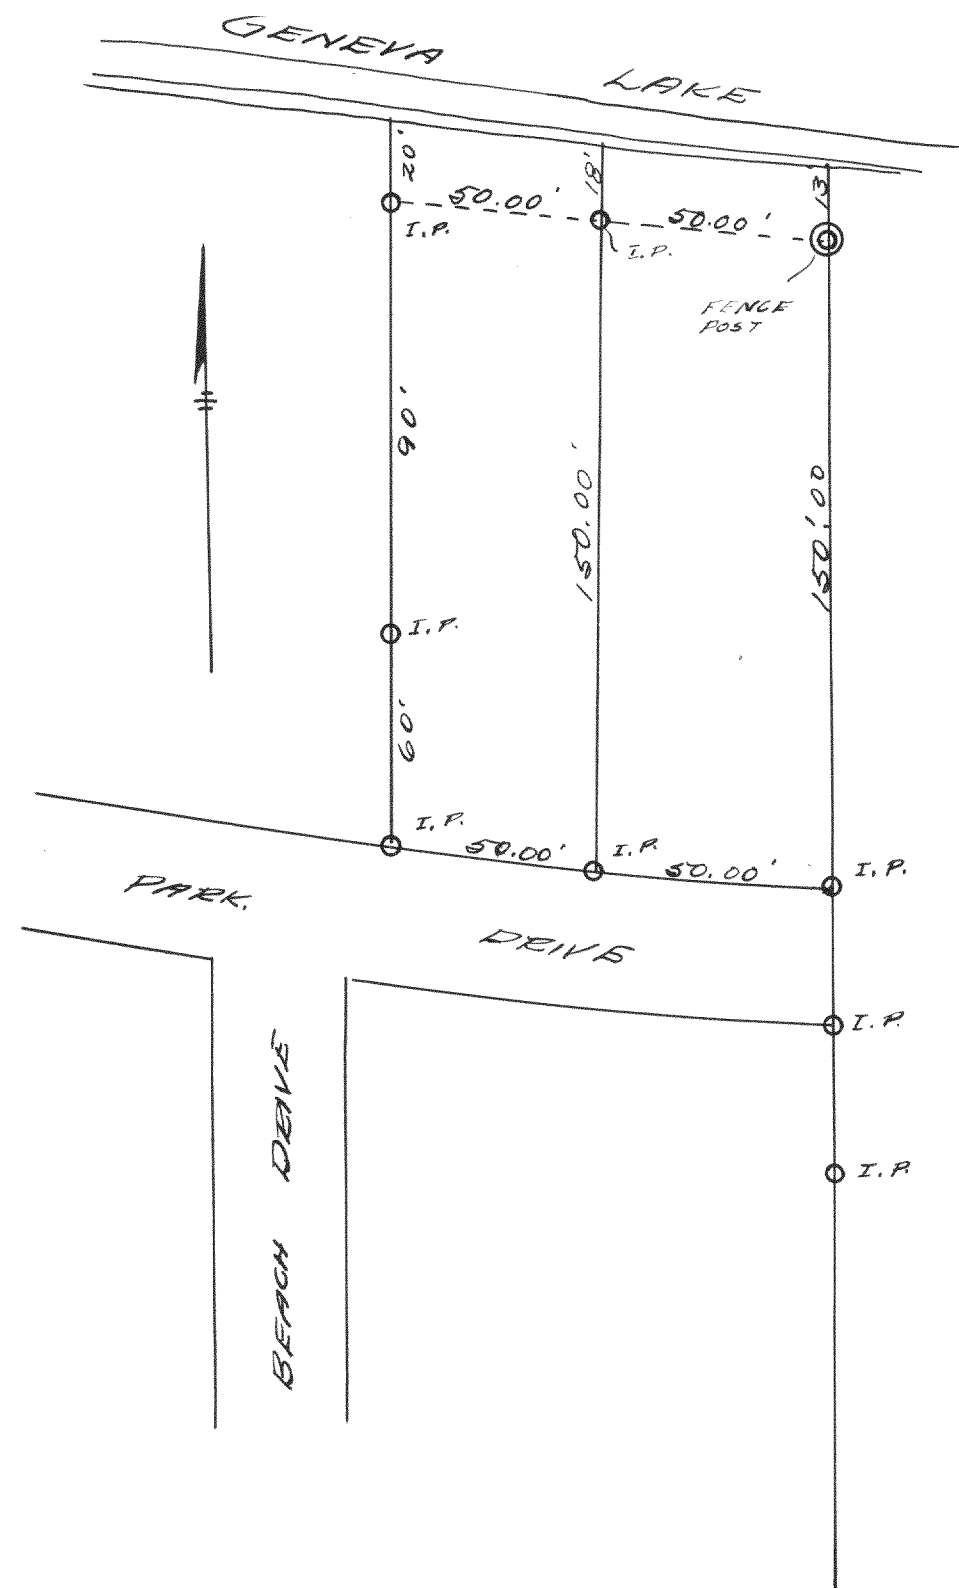


SURVEY OF LOTS 142 OF LAKE
GENEVA BEACH, SECTION 11, TIN
RITE, WALWORTH COUNTY, WISCONSIN.
AUG. 17, 1939
Lloyd L. Jensen
by H. E. J.

SURVEY NO. 1065

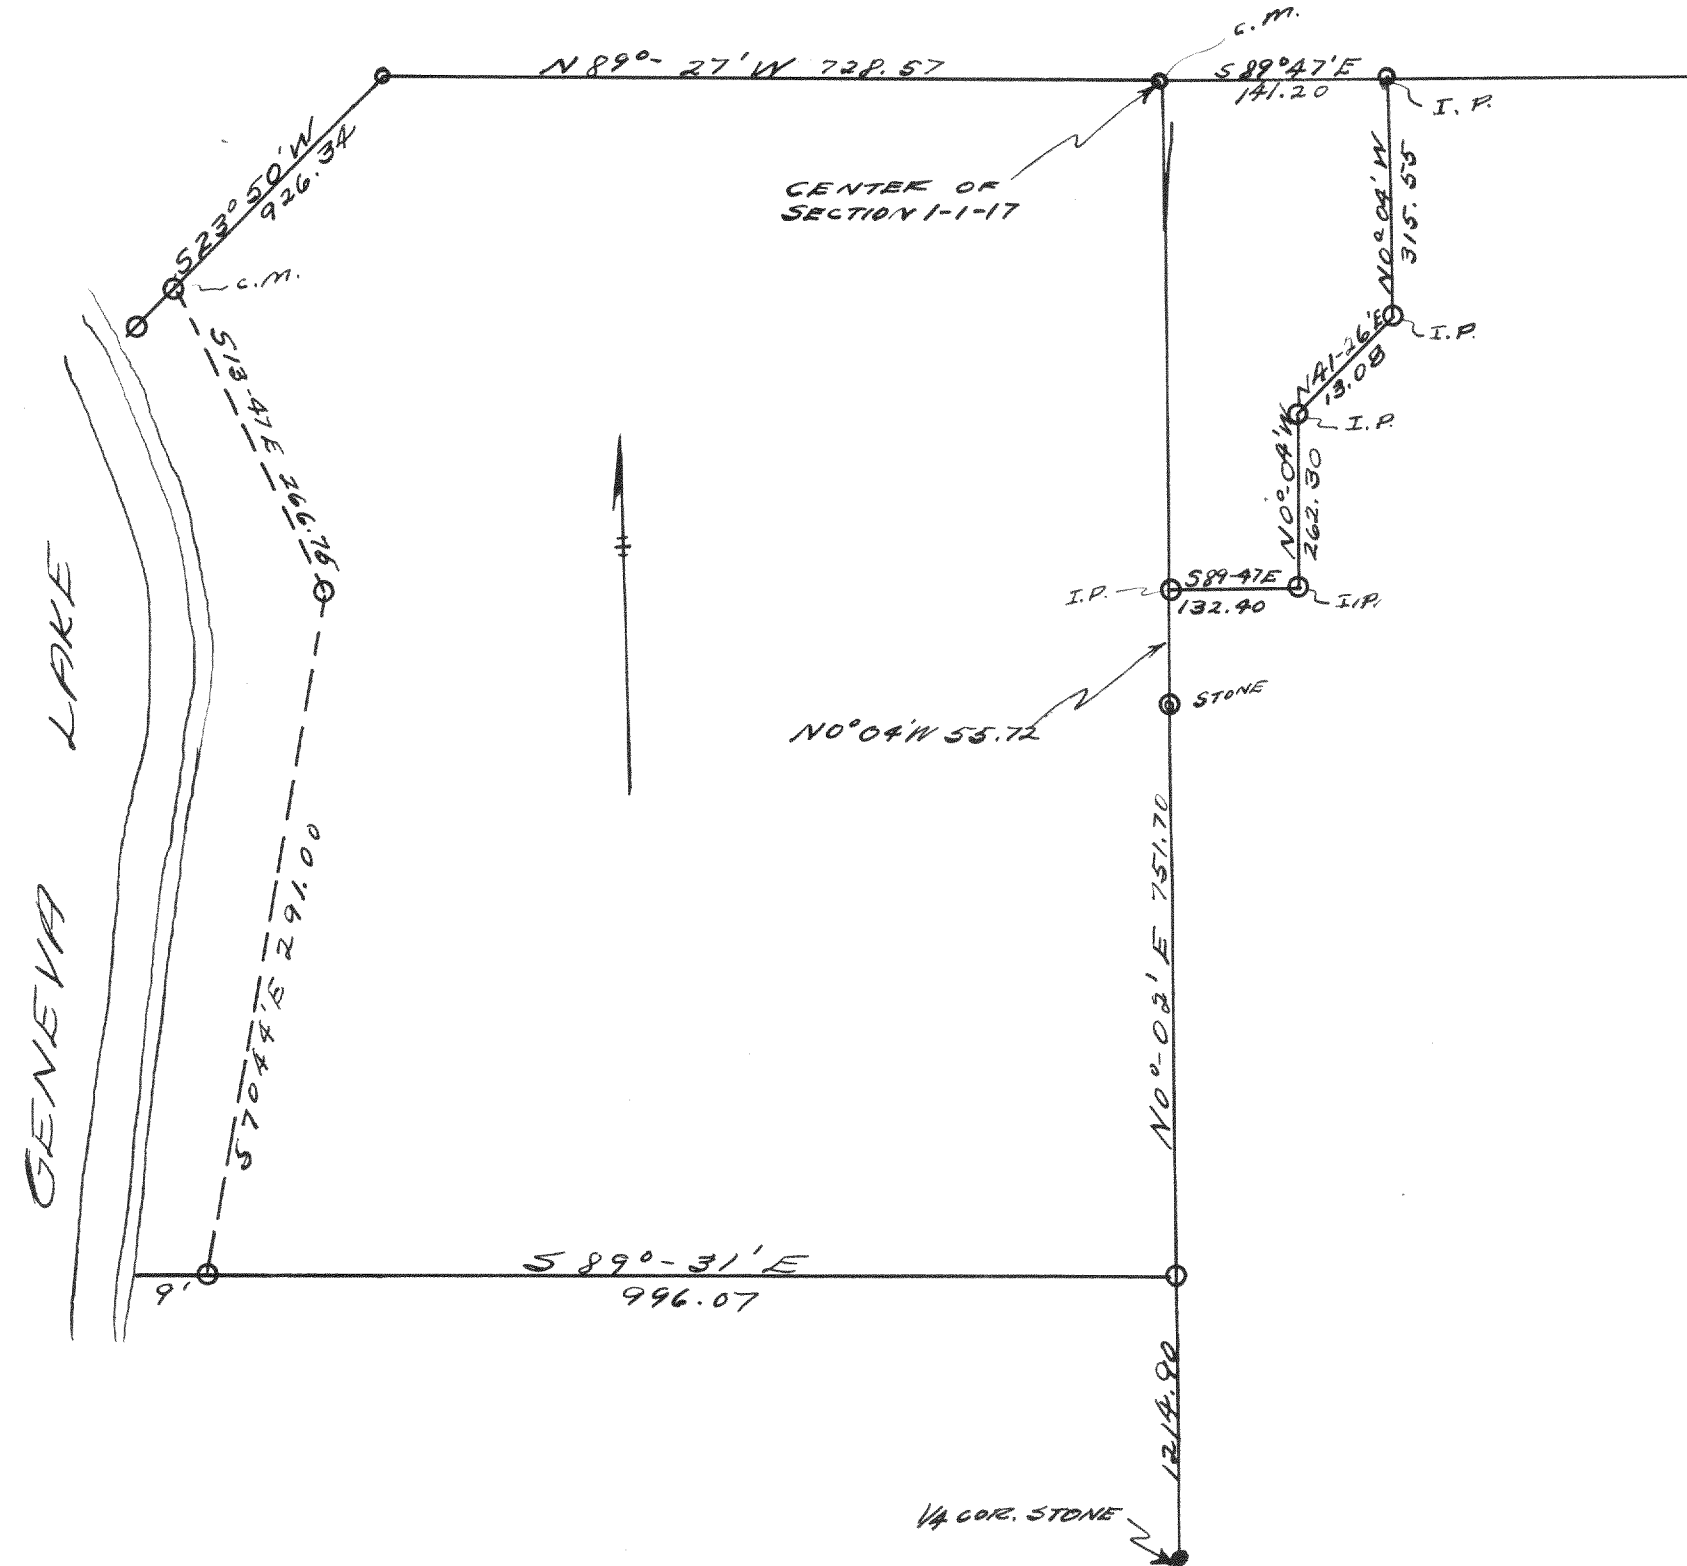

SURVEY OF PART OF SECTION
1-1-17 (MANDALANE FARMS)
Dec., 1938
Lloyd L. Jensen
H. E. J.

SURVEY NO. 1066

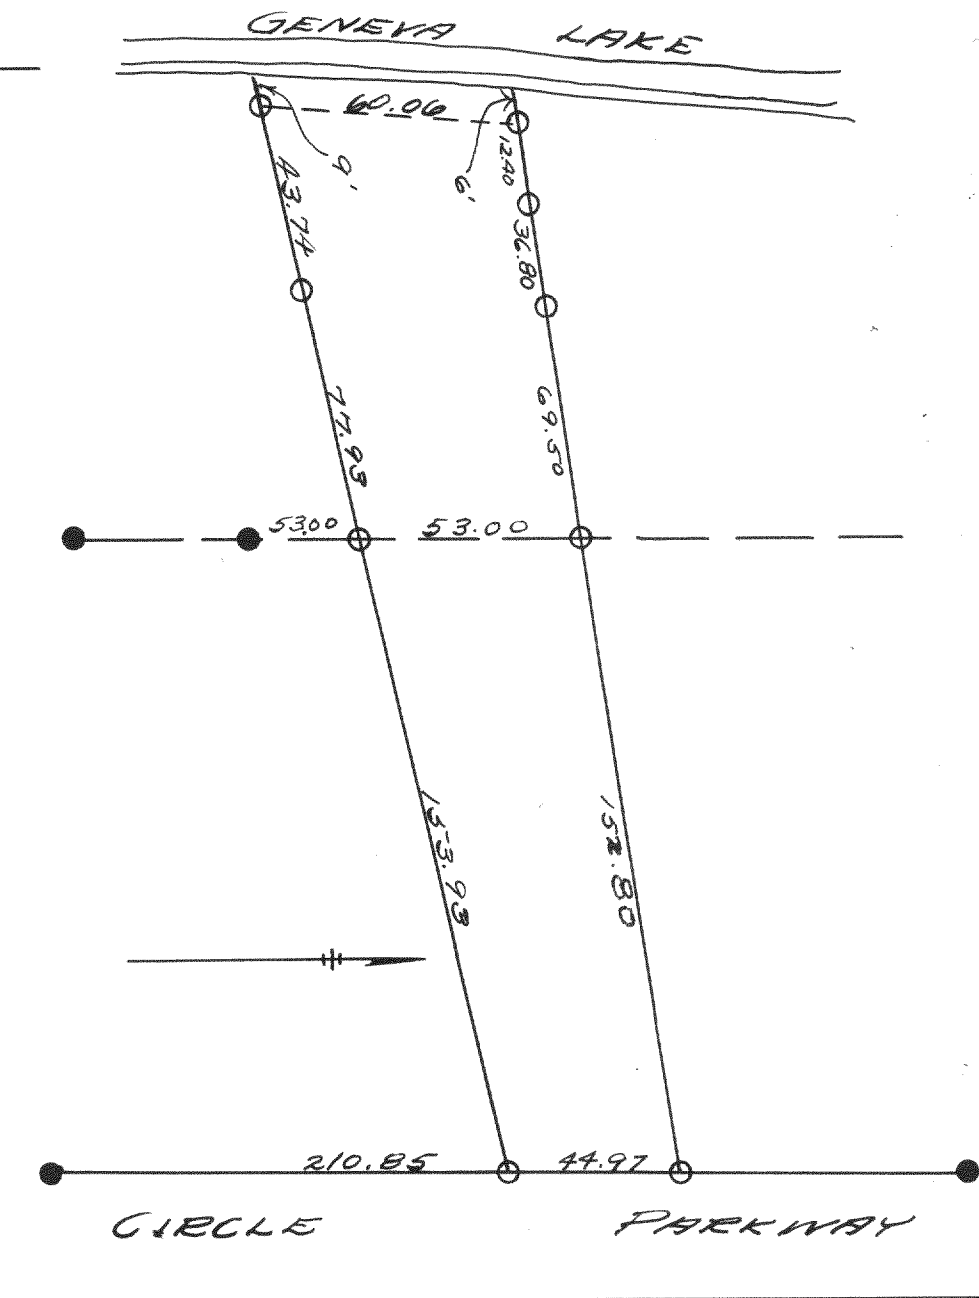

SURVEY OF LOT NO. 211 OF
THE THIRD ADDITION TO CEDAR
POINT PARK
OCT. 11, 1939
Lloyd L. Jensen
H. E. J.