



SURVEY No. 1070

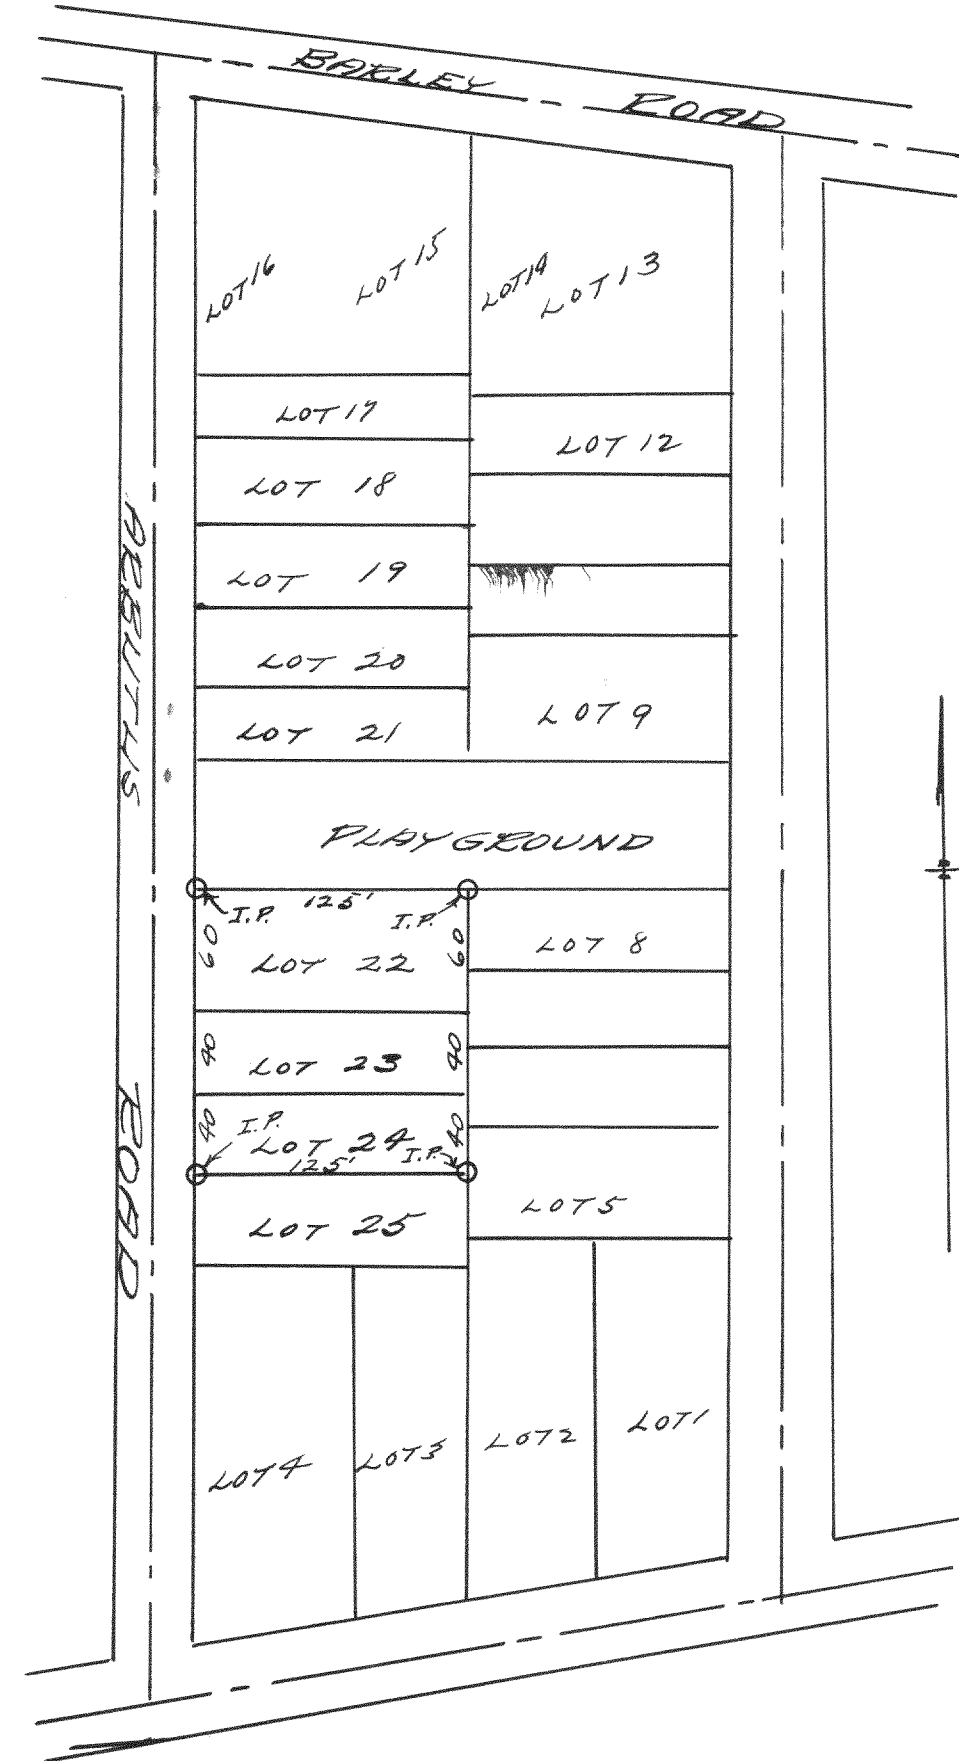

SURVEY OF LOTS 22, 23, + 24
OF BLOCK 45 OF FLAT IV
OF INTERLAKE SUBDIVISION
4-18-39

Lloyd L. Jensen
by N.E.J.

SURVEY No. 1071

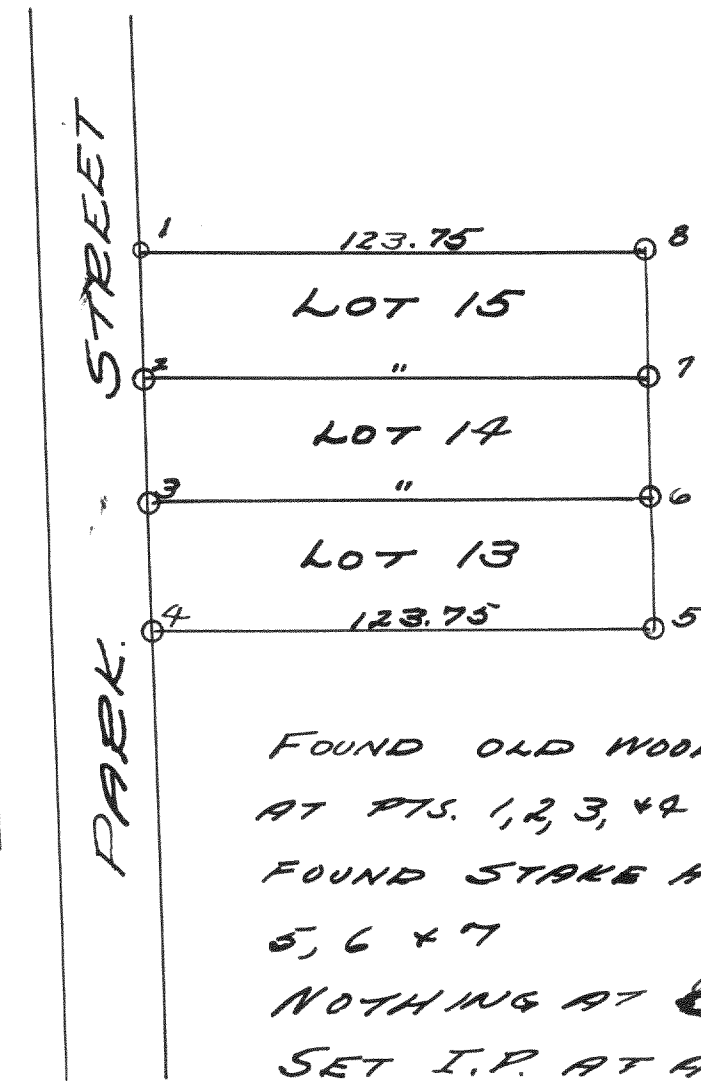


FOUND OLD WOOD STAKES
AT PTS. 1, 2, 3, + 4
FOUND STAKE HOLES AT
5, 6 + 7
NOTHING AT 8
SET I.P. AT ALL PTS.

SURVEY OF LOTS 13, 14 + 15
OF BLOCK I OF F.W. TRATTS
PARKLAWN ADDITION TO THE
CITY OF WHITEWATER
7-9-39

Lloyd L. Jensen
by N.E.J.

SURVEY No. 1072

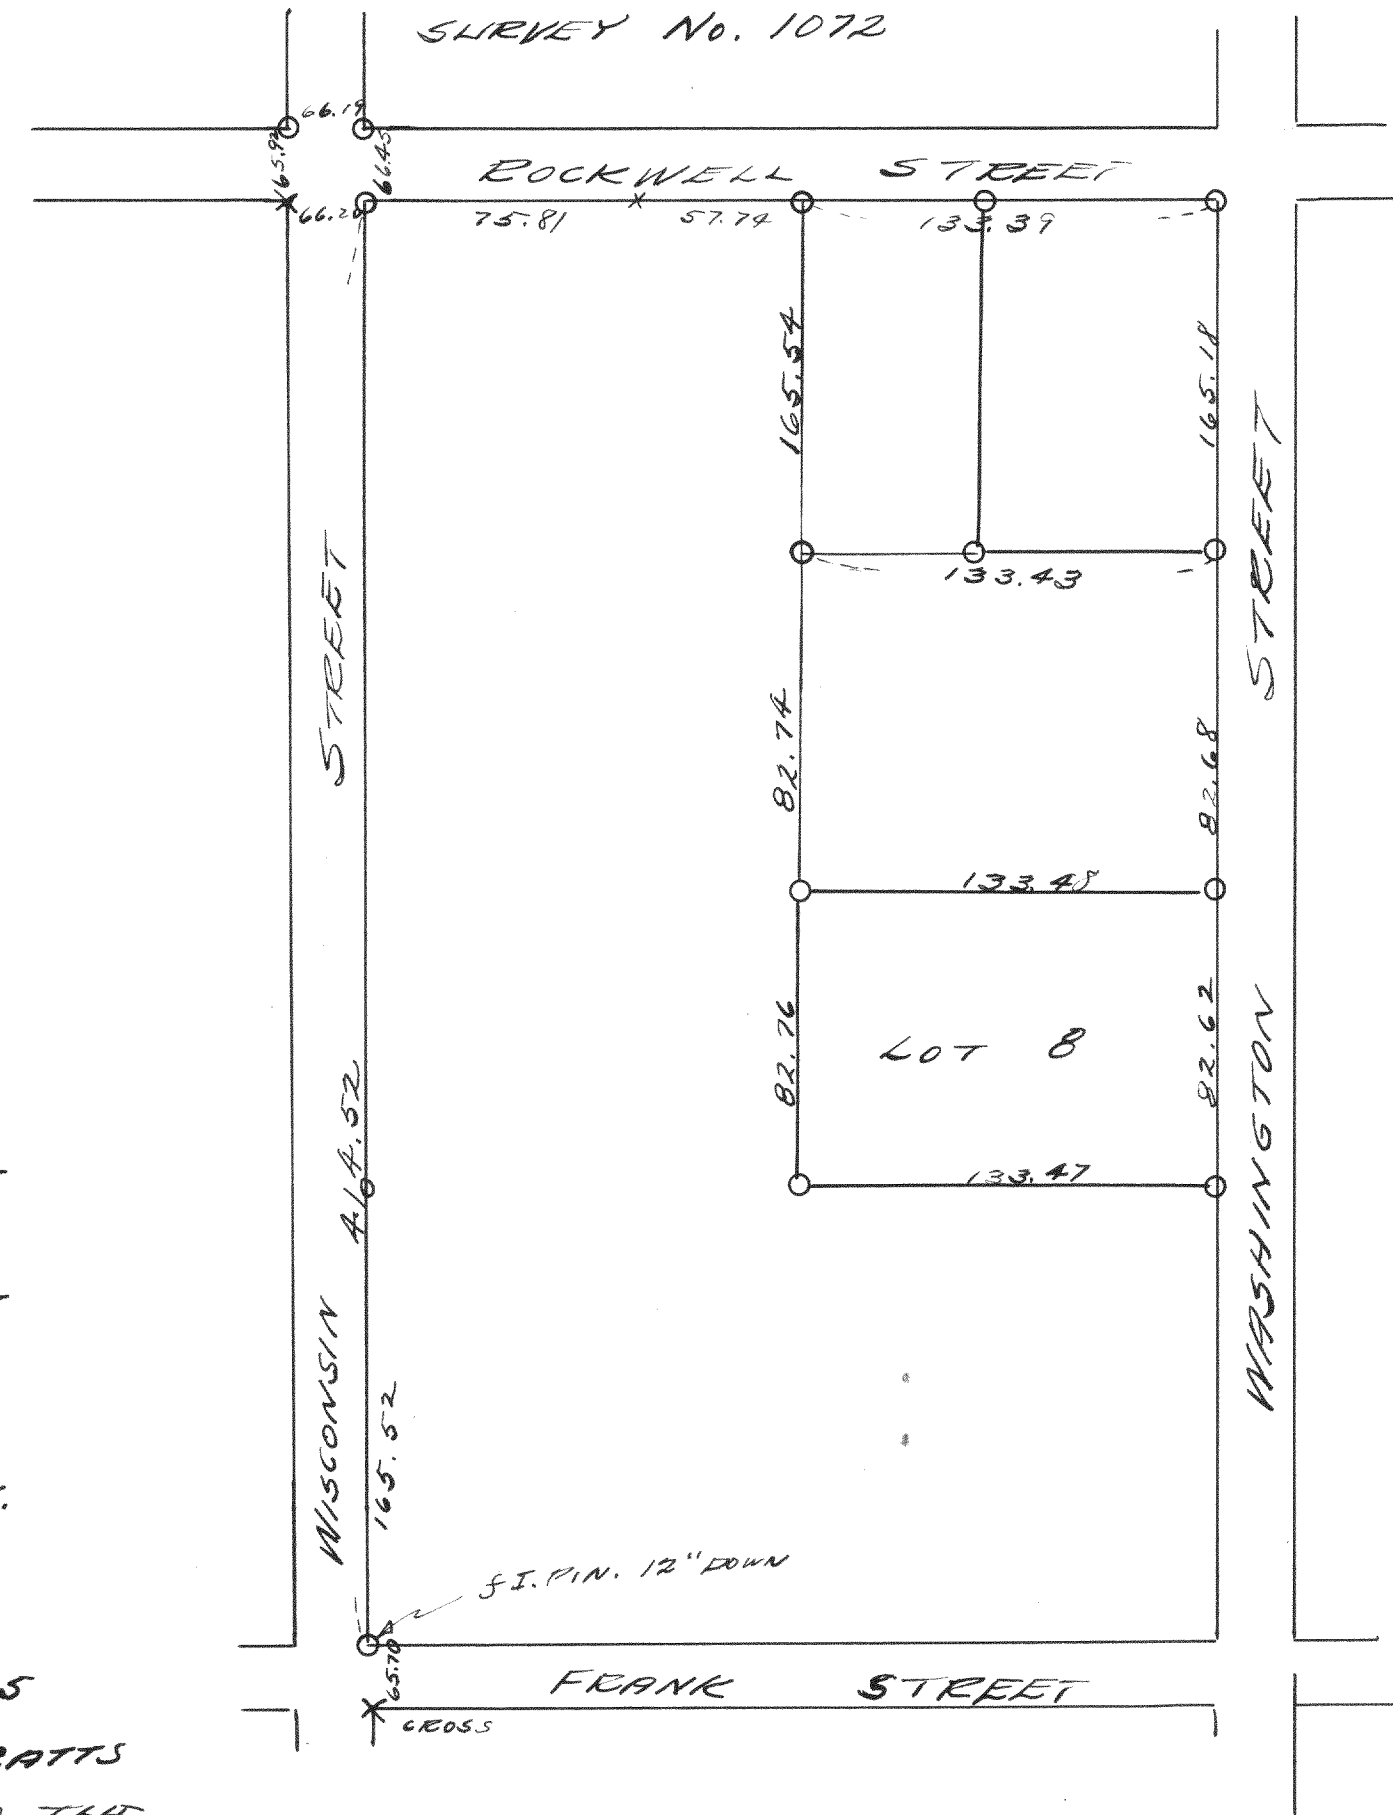

SURVEY OF LOT 8 OF BLOCK 43
OF ROCKWELL'S 2ND ADD. TO
THE CITY OF ELKHORN
NOV. 1939

Lloyd L. Jensen
by N.E.J.