


SURVEY NO. 1081

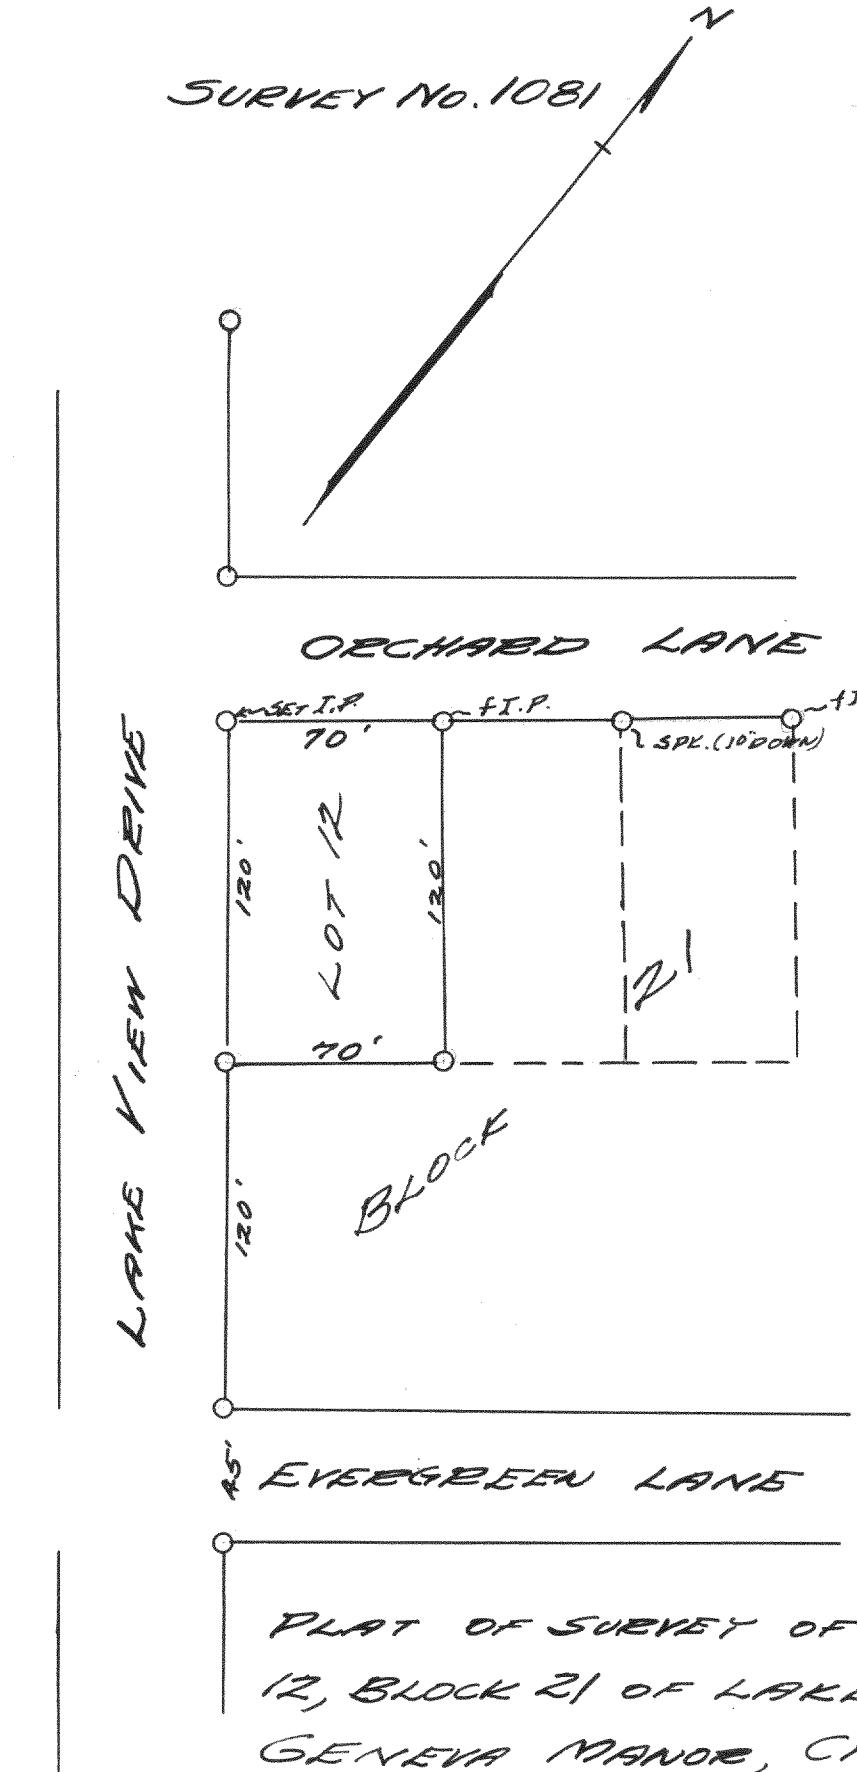


PLAT OF SURVEY OF LOT
12, BLOCK 21 OF LAKE
GENEVA MANOR, CITY
OF LAKE GENEVA, WALWORTH
COUNTY, WISCONSIN.

FEB. 28, 1940

Lloyd L. Jensen
H.E.S.

SURVEY NO. 1082

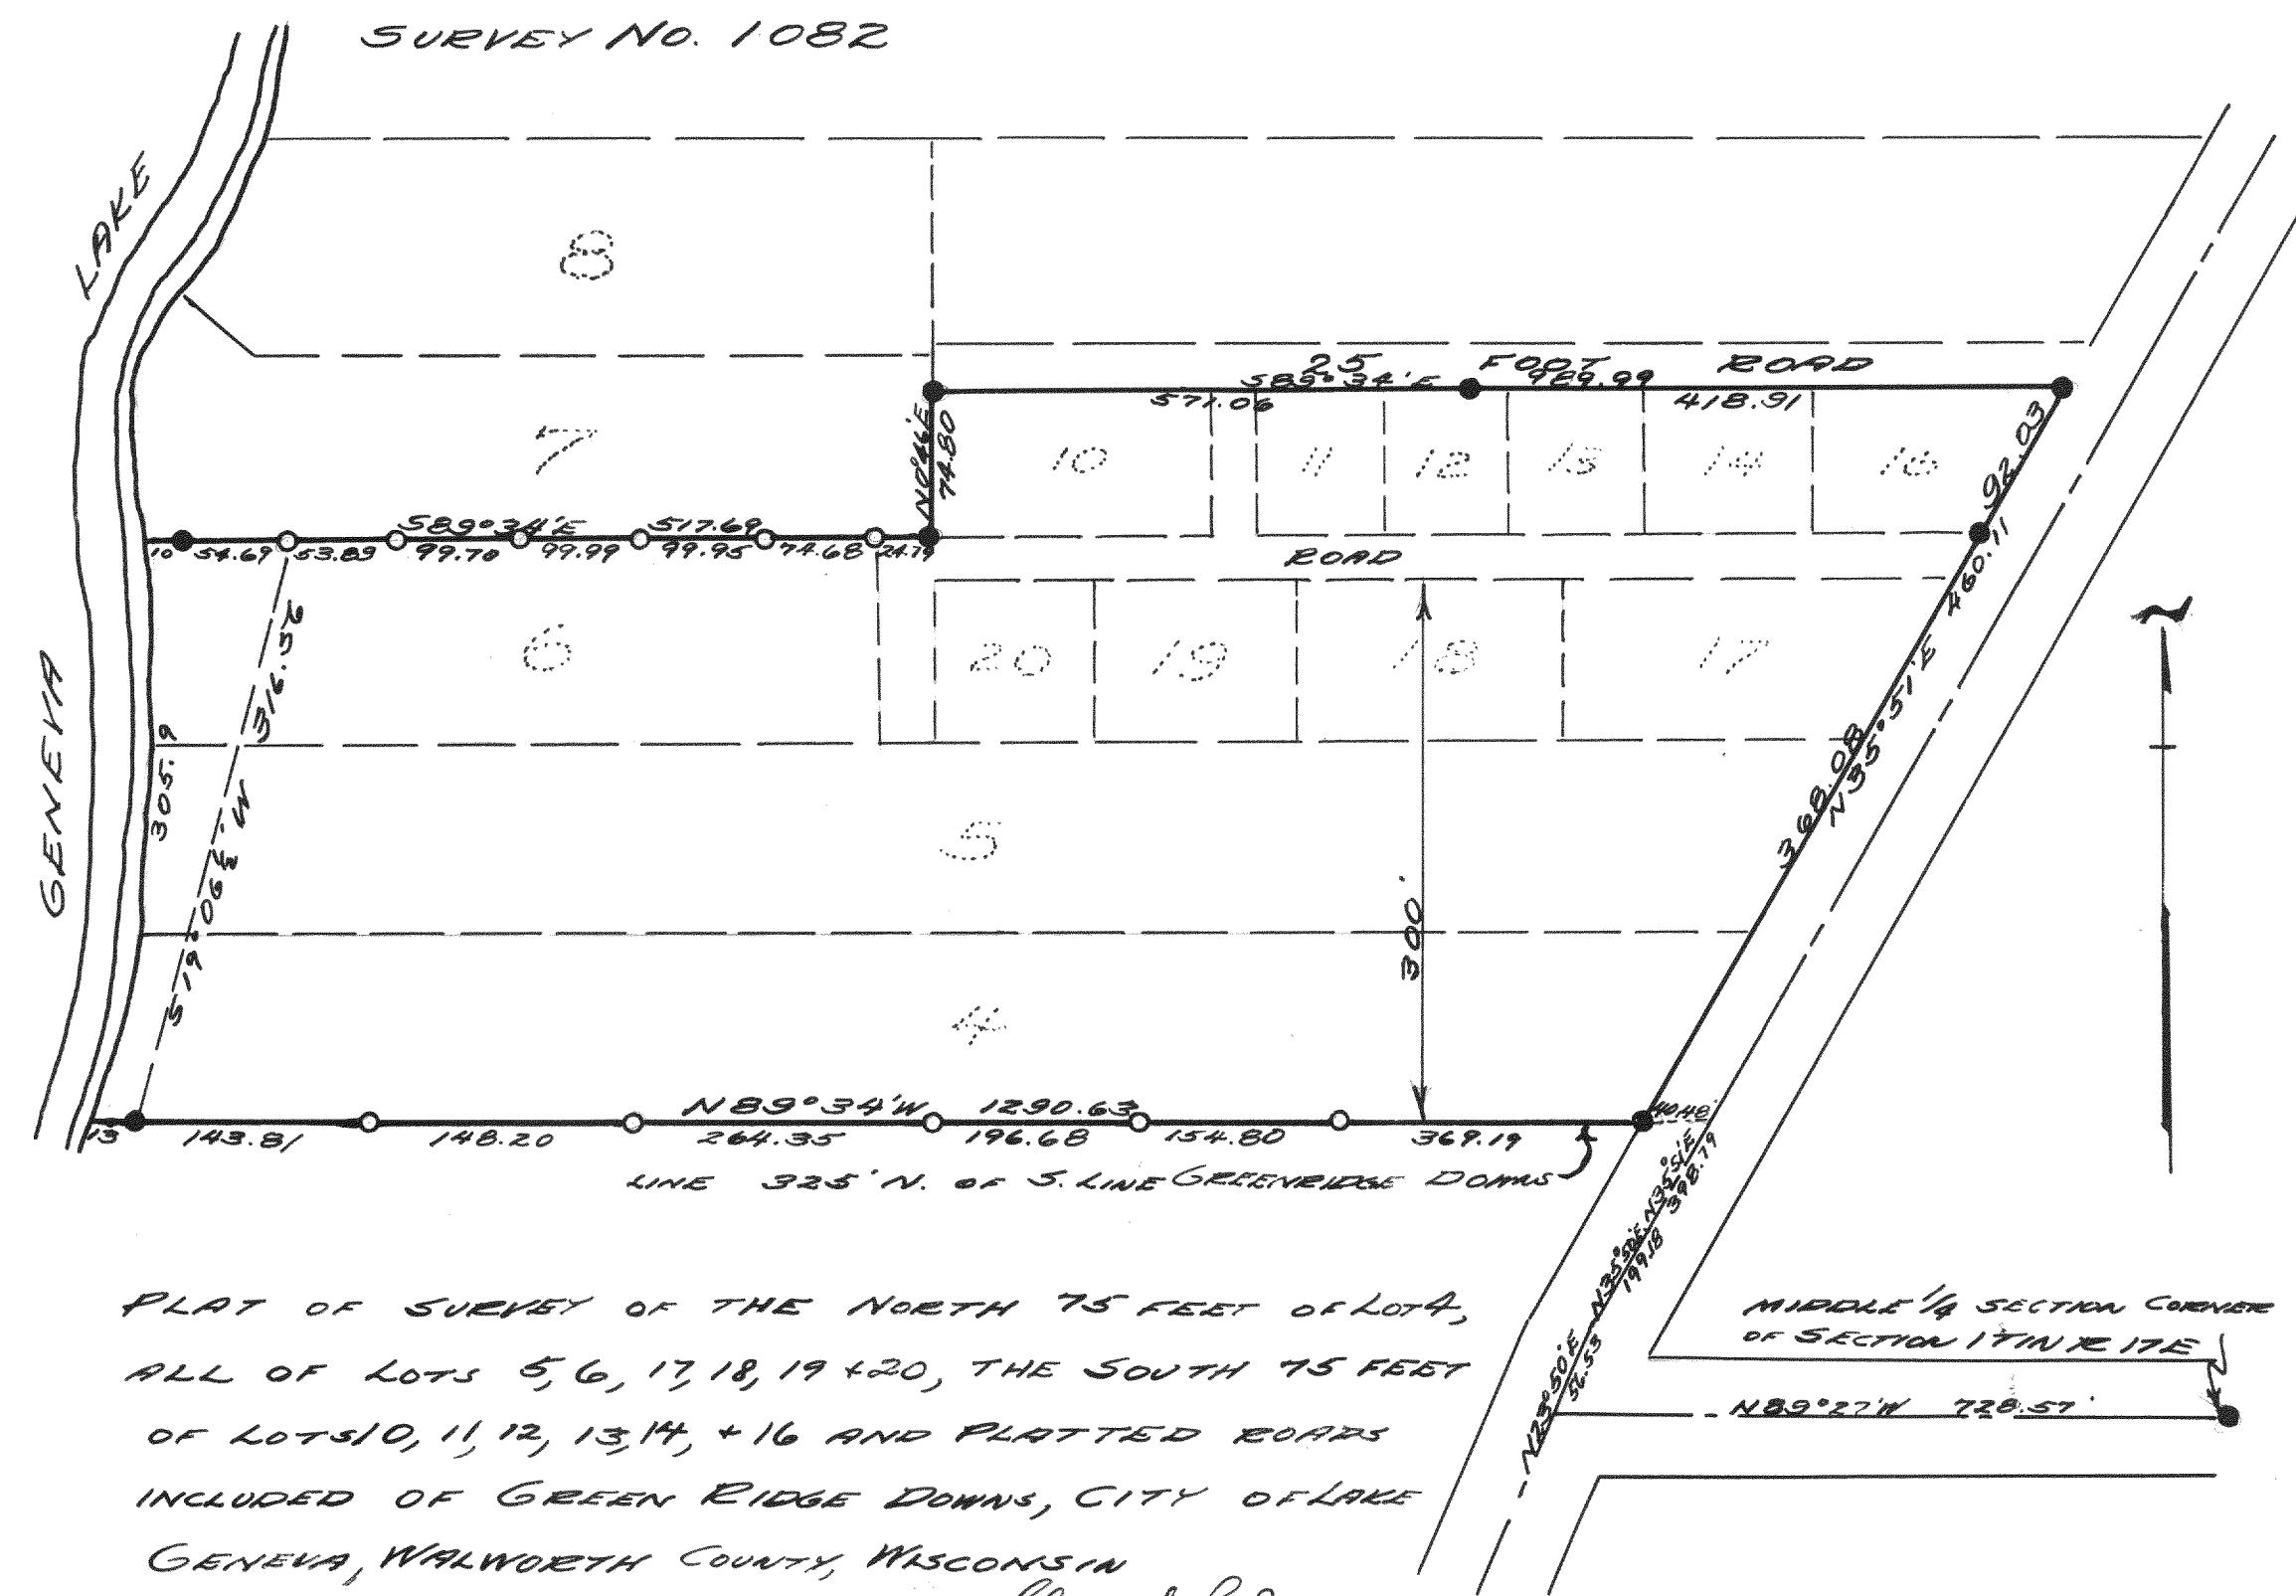

PLAT OF SURVEY OF THE NORTH 75 FEET OF LOT 4,
ALL OF LOTS 5, 6, 17, 18, 19 + 20, THE SOUTH 75 FEET
OF LOTS 10, 11, 12, 13, 14, + 16 AND PLATTED ROADS
INCLUDED OF GREEN RIDGE DOWNS, CITY OF LAKE
GENEVA, WALWORTH COUNTY, WISCONSIN
APRIL 1940

Lloyd L. Jensen
H.E.S.