



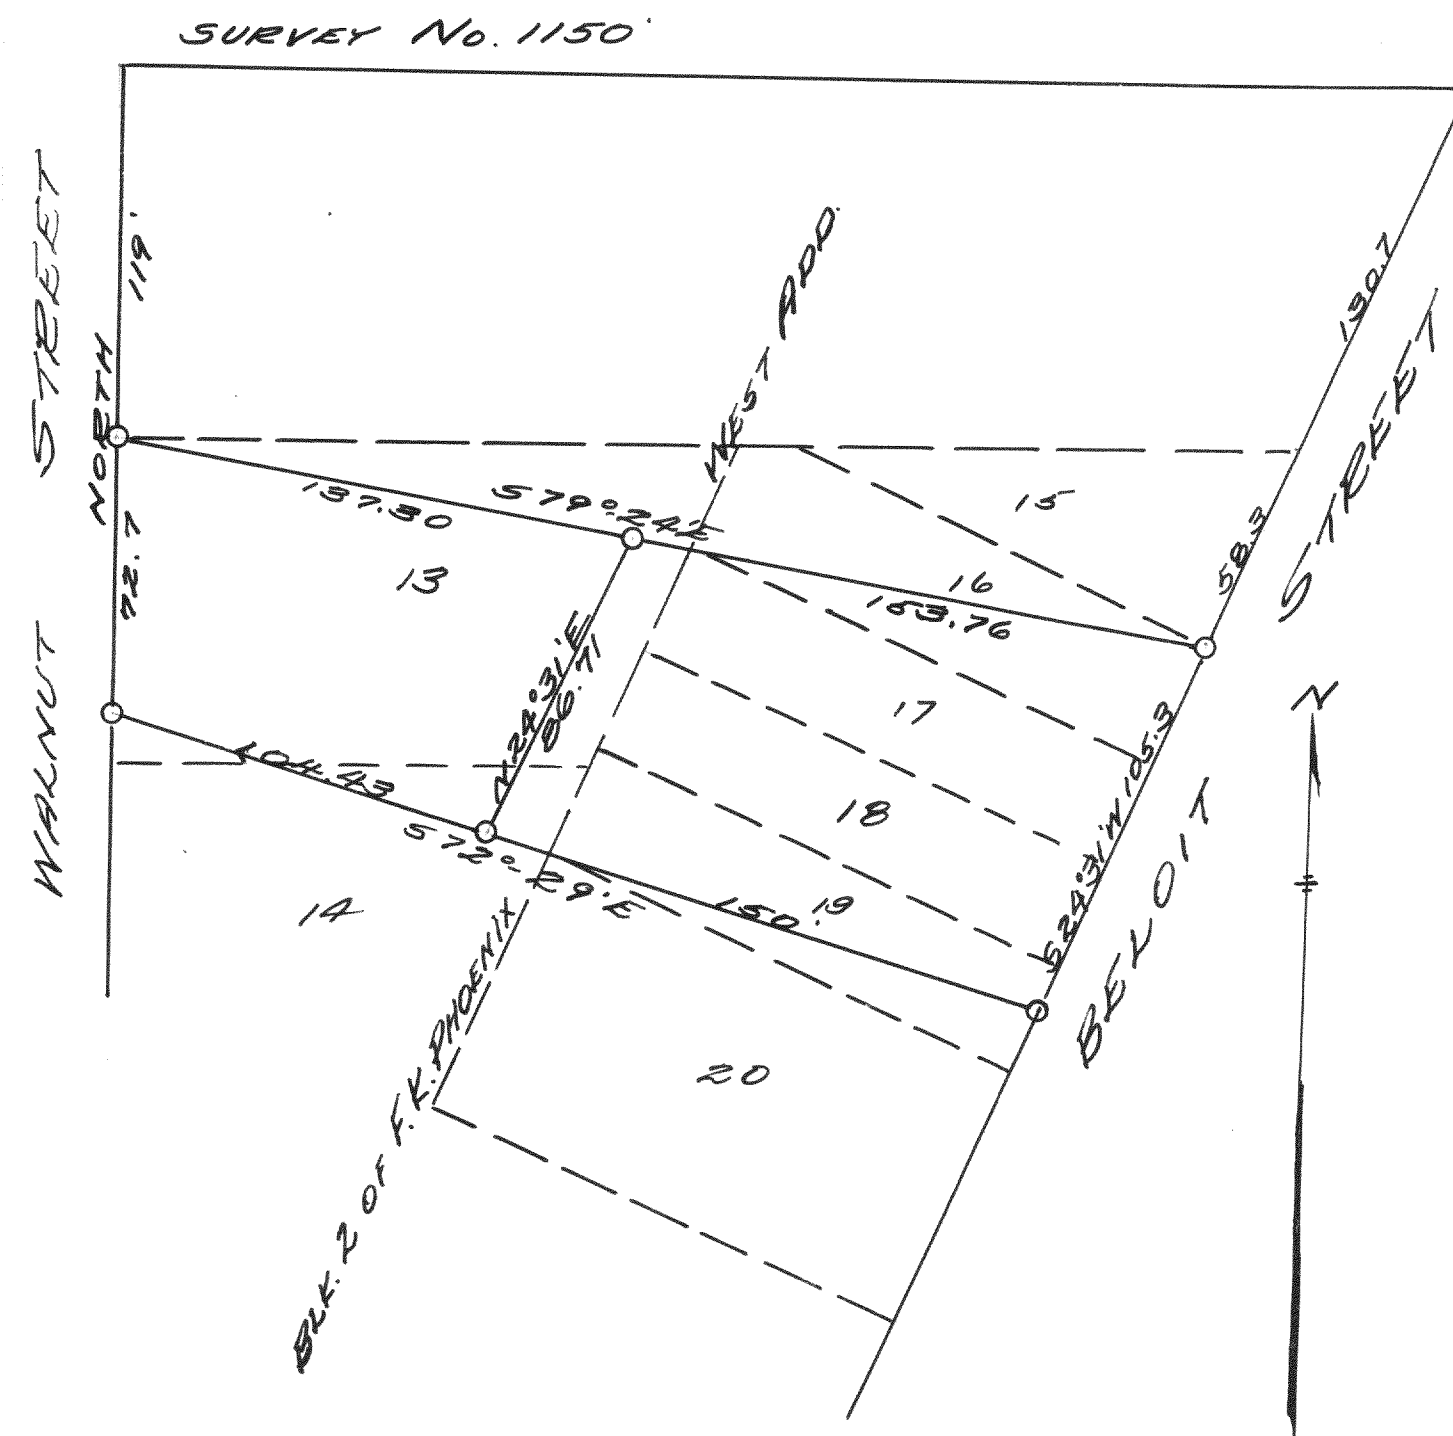

PLAT OF SURVEY OF LAND LOCATED
IN BLOCK 2 OF F.K. PHOENIX'S WEST
ADDITION TO THE CITY OF DELAVAN,
WALWORTH COUNTY, WISCONSIN
AUGUST 1940

Lloyd L. Jensen
S.E.J.

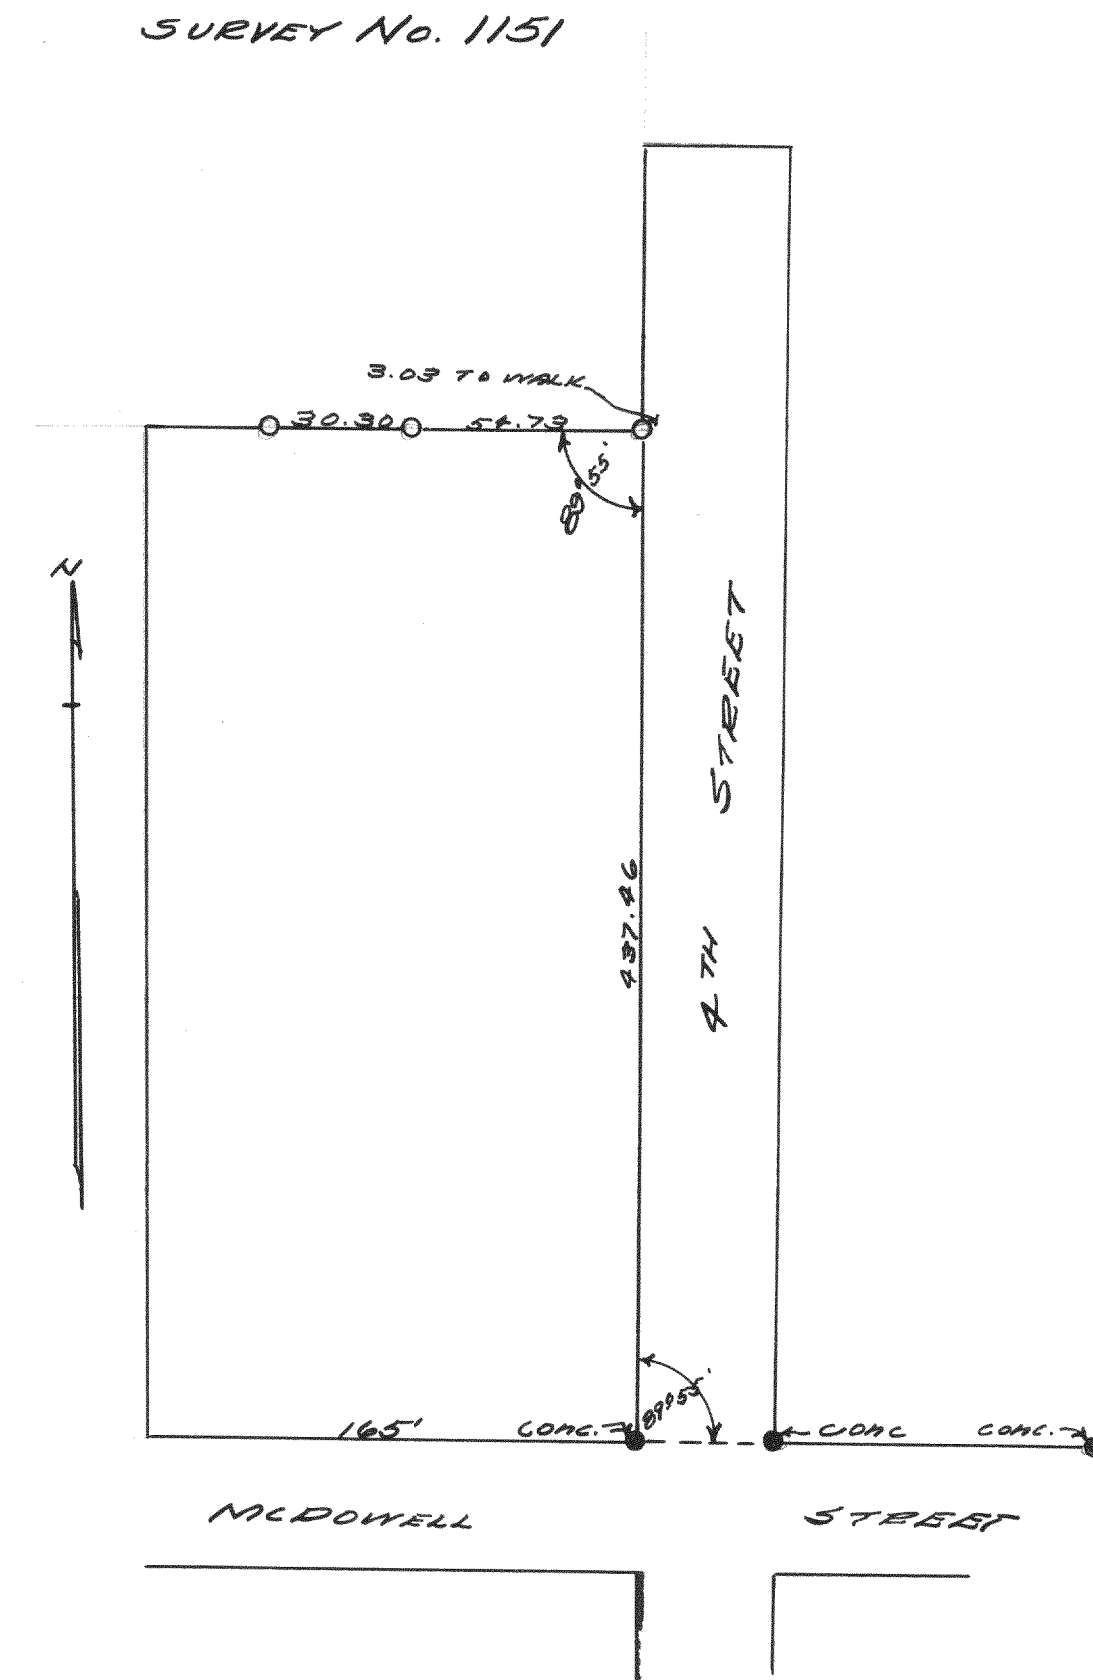

PLAT OF SURVEY TO LOCATE THE NORTH
LINE OF THE MARGARET GRACE THOMAS
PROPERTY (230-533) IN THE CITY OF
DELAVAN, WALWORTH COUNTY, WISCONSIN.
AUGUST 10, 1940

Lloyd L. Jensen
S.E.J.