



SURVEY No. 1164

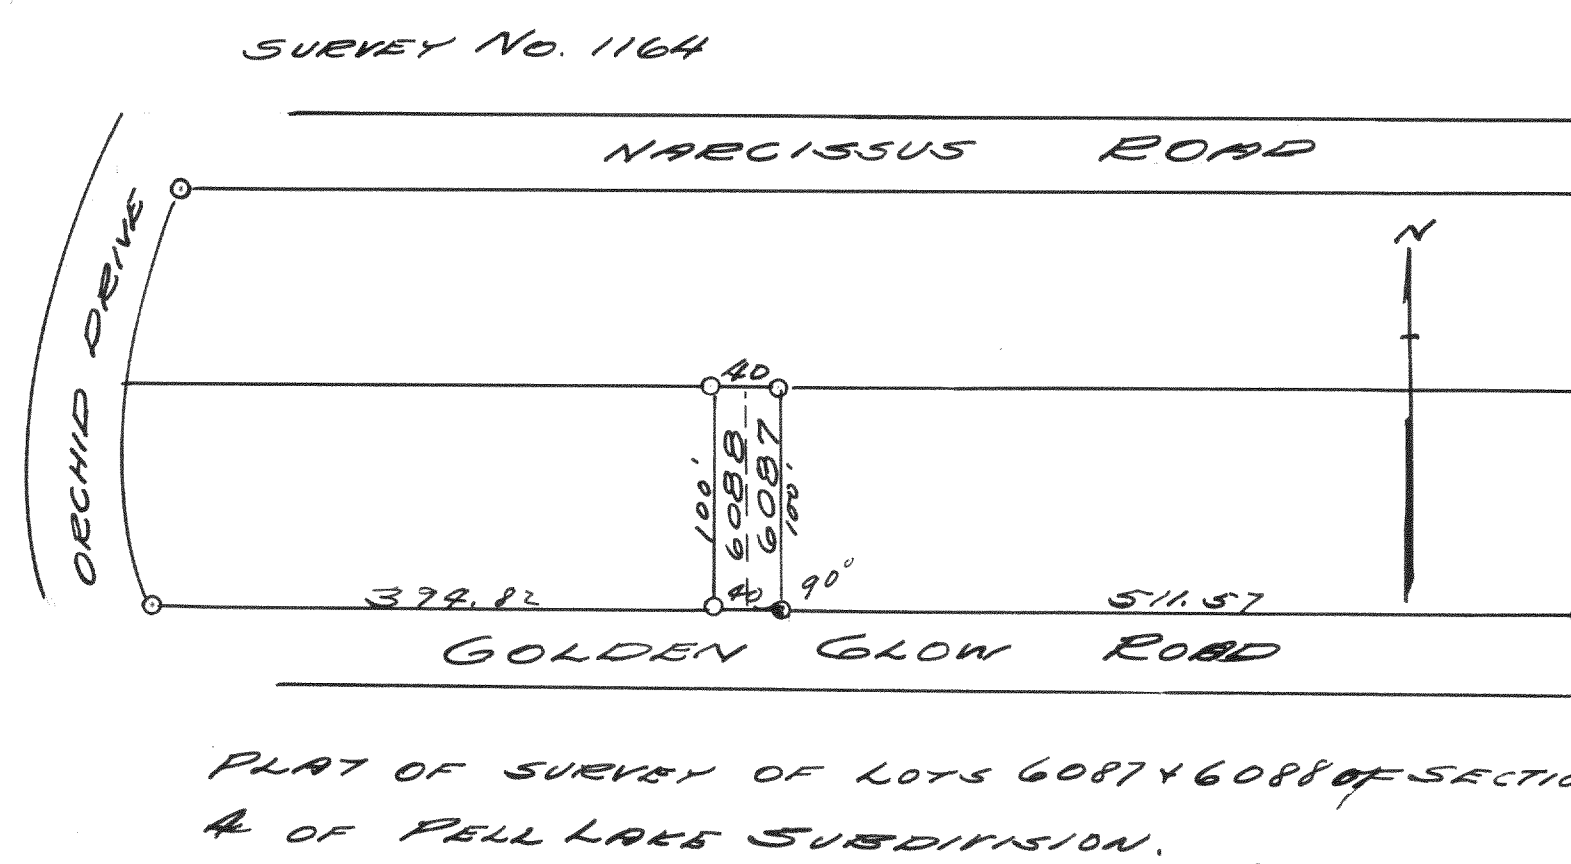

PLAT OF SURVEY OF LOTS 6087 & 6088 OF SECTION
4 OF PELL LAKE SUBDIVISION.
AUGUST 31, 1990 Lloyd E. Jensen

PLAT OF SURVEY OF LOTS 6087 & 6088 OF SECTION
4 OF PELL LAKE SUBDIVISION.
AUGUST 31, 1990 Lloyd E. Jensen


Lloyd L. Jensen
F.E.J.

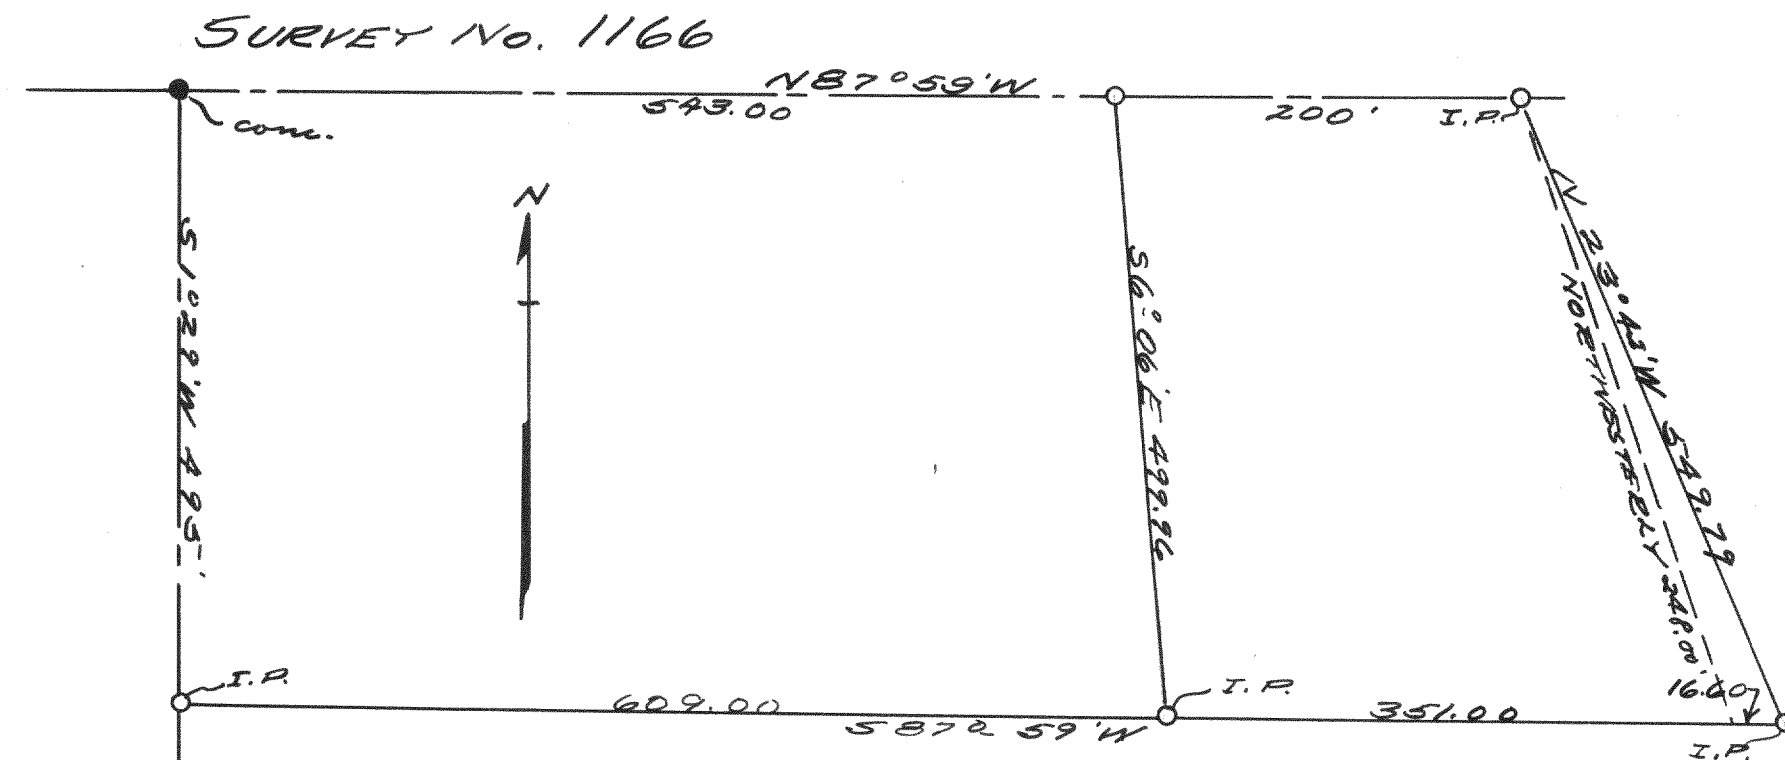

PLAT OF SURVEY OF LAND LOCATED IN THE NORTHWEST
1/4 OF SECTION 10 T4N R18E OF WALWORTH CO. WISCONSIN
JAN 7, 1941 *Clarence L. Jensen*

Lloyd L. Jensen
H.E.J.

SURVEY NO. 1165

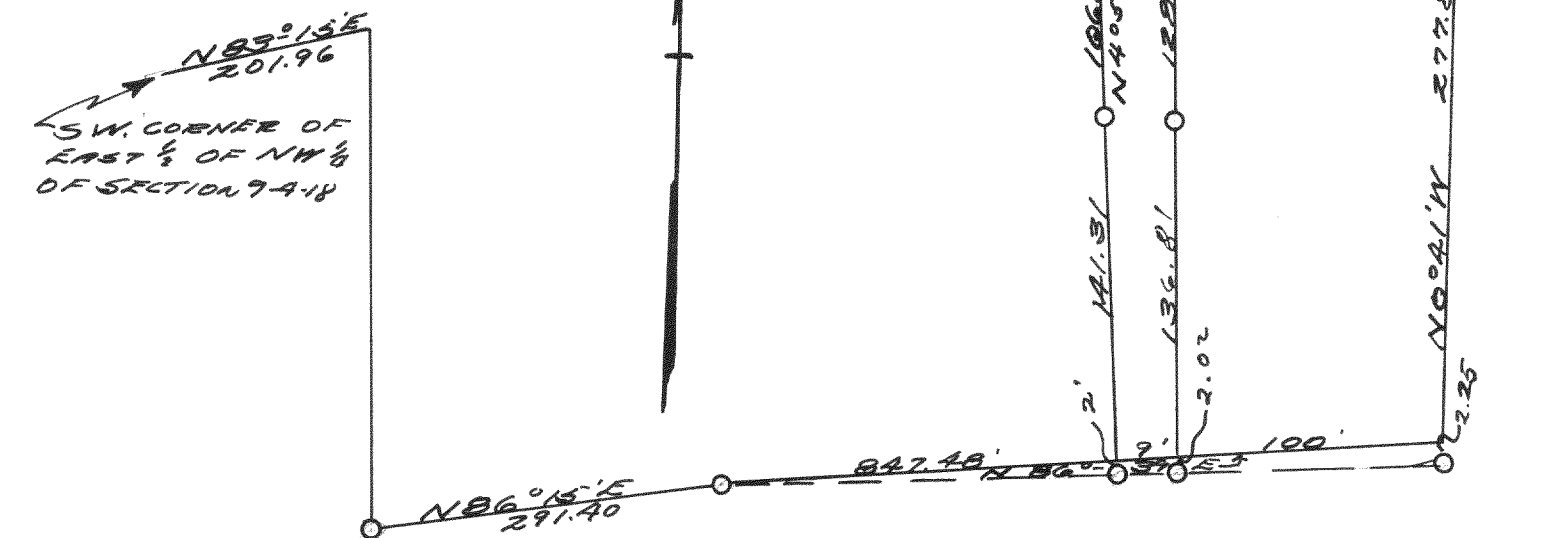


PLAT OF SURVEY OF A PARCEL OF LAND
IN ~~THE~~ SECTION 9 T4NR18E, WALWORTH
COUNTY, WISCONSIN.

Оср. 10, 1940

Lloyd L. Jensen
H.E.J.

SURVEY NO. 1167

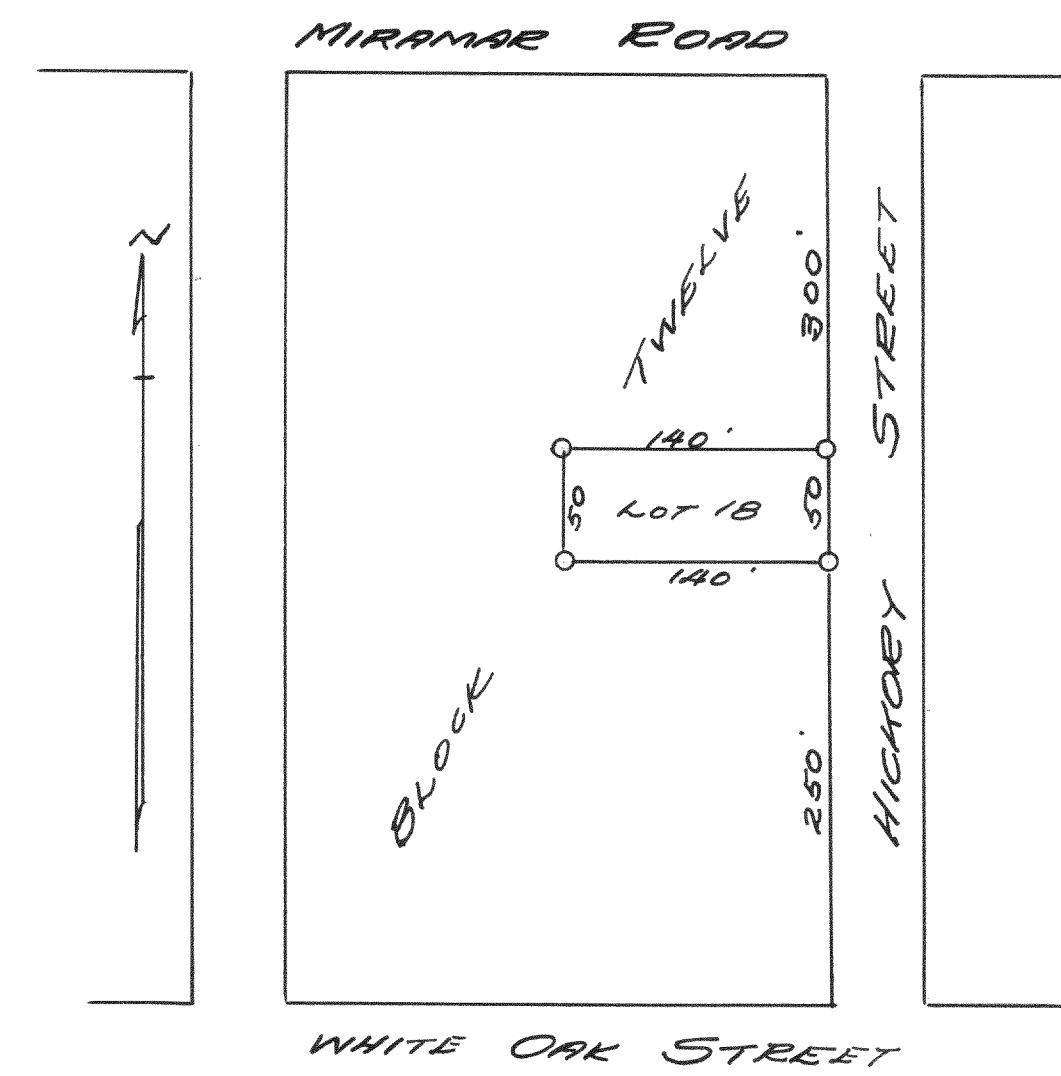

PLAT OF SURVEY OF LOT 18 OF BLOCK 12
OF MIKMAR SUBD. Lloyd Jensen

Lloyd L. Jensen