


Record of Survey.

DESCRIPTION

no 174

Township....., North of Range.....of 4 Principal Meridian
as presented by the courses and distances on the following plat, and annexed field-notes of survey:
Established the center of the section at the point of intersection of STRAIGHT quarter lines.
Established all quarter-quarter corners upon the section boundary at proportional distances between known section and quarter section corners, according to the original field-notes of the Government survey.
Established all lost corners at proportionate distances between known corners, according to the original field notes of the Government survey.

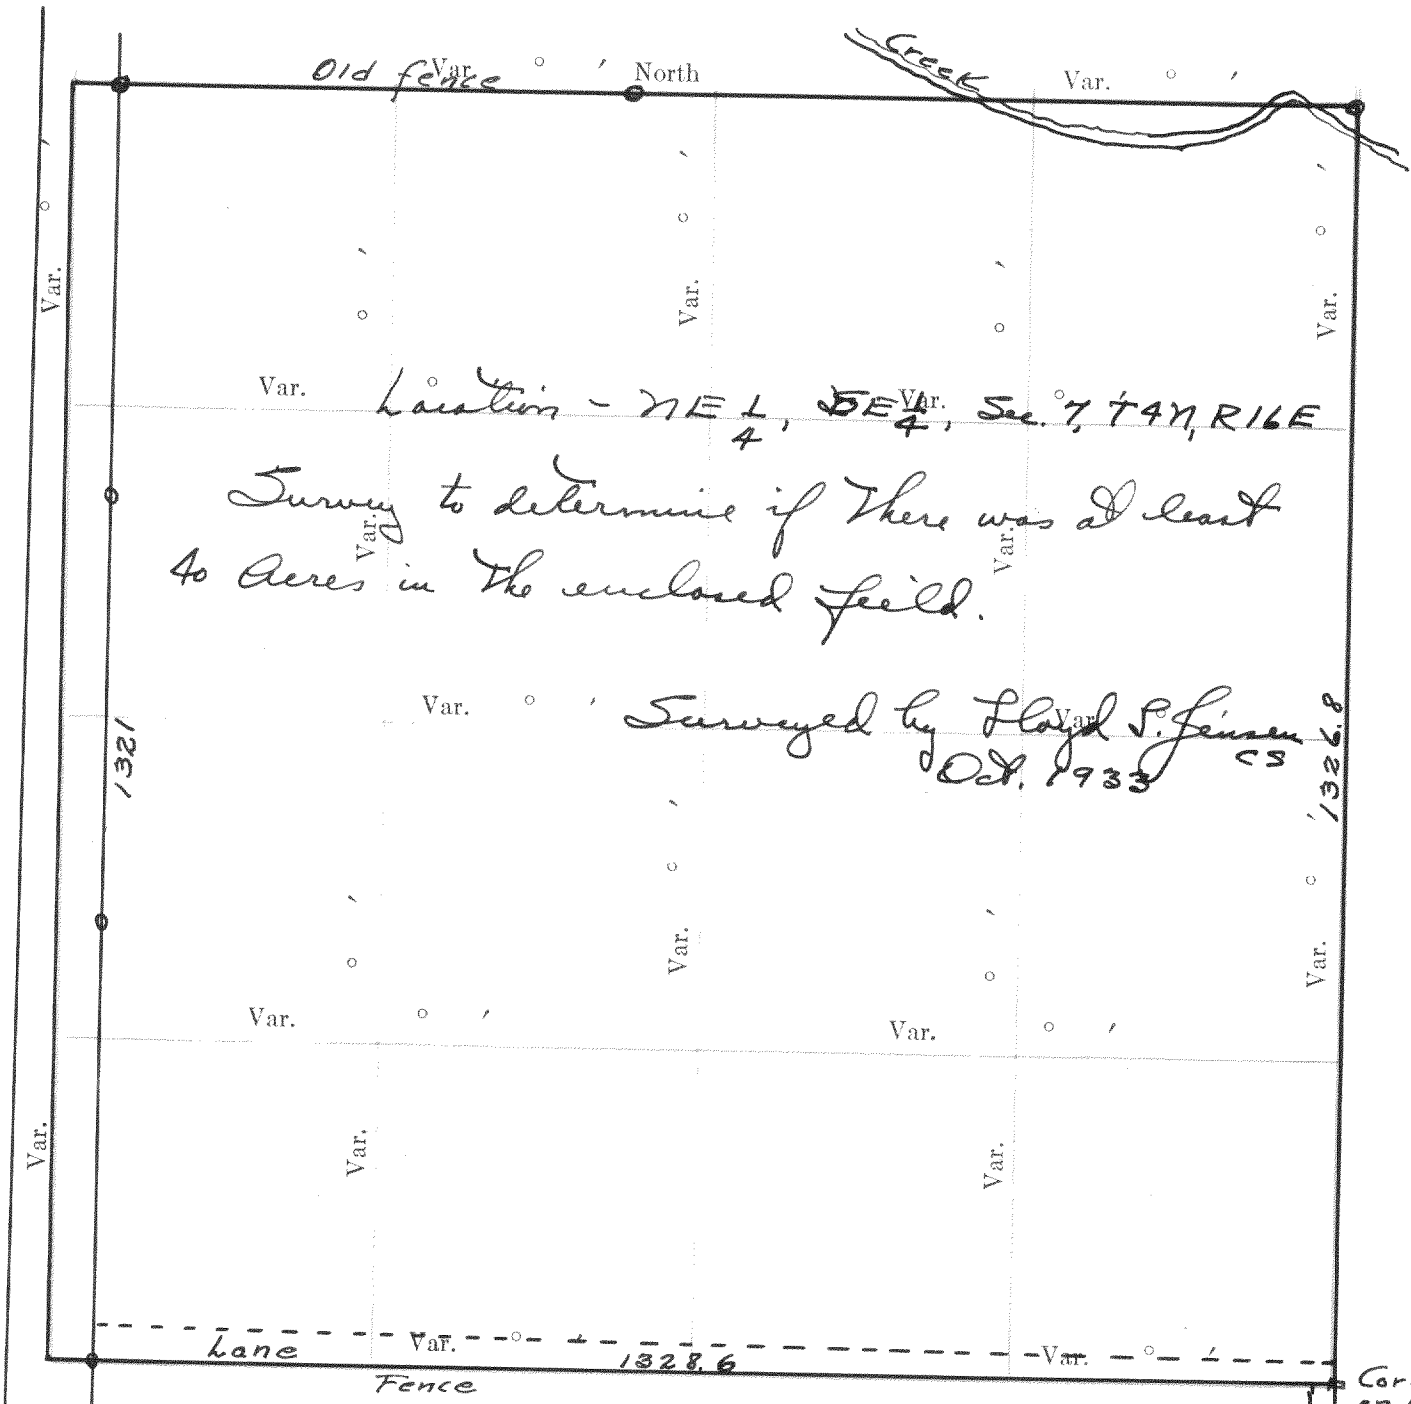

Plat of Section....., Township.....North, Range.....of 4 Principal Meridian Scale
80 chains to 6 inches. The figures in red ink are the lengths of the lines as stated in the field-notes of the
Government survey.
Declination of the Magnetic Meridian from the True Meridian.....
Surveyed and sub-divided.....A. D. 1....., in accordance
with the State Laws and Instructions of the Commissioner of the General Land office, and recorded on pages
.....of Register in the County Clerk's office.
Witness my hand this.....day of.....A. D. 1.....
.....SURVEYOR.

OF SECTION, QUARTER SECTION AND QUARTER QUARTER SECTION CORNERS

No.	GOVERNMENT CORNERS				H. C. MILLER CO., MFG. STATIONERS, MILWAUKEE WISCONSIN							
	Bearing	In.	Courses	Links	Bearing	In.	Courses	Links	Bearing	In.	Courses	Links
	Trces	Dia.	they bear	Distant	Trces	Dia.	they bear	Distant	Trces	Dia.	they bear	Distant

- 1. N. W. Sec. Cor. identified,
- 2. N. E. Sec. Cor. identified,
- 3. S. E. Sec. Cor. identified,
- 4. S. W. Sec. Cor. identified,
- 5. N. 1/4 Sec. Cor. identified,
- 6. E. 1/4 Sec. Cor. identified,
- 7. S. 1/4 Sec. Cor. identified,
- 8. W. 1/4 Sec. Cor. identified,

- Subdivision Corners
- 1. Center 1/4 Sec. Cor.
 - 2. North 1/4-1/4s N. W. qr.,
 - 3. East 1/4-1/4s N. W. qr.,
 - 4. South 1/4-1/4s N. W. qr.,
 - 5. West 1/4-1/4s N. W. qr.,
 - 6. Center 1/4-1/4s N. W. qr.,
 - 7. North 1/4-1/4s N. E. qr.,
 - 8. East 1/4-1/4s N. E. qr.,
 - 9. South 1/4-1/4s N. E. qr.,
 - 10. Center 1/4-1/4s N. E. qr.,
 - 11. East 1/4-1/4s S. E. qr.,
 - 12. South 1/4-1/4s S. E. qr.,
 - 13. West 1/4-1/4s S. E. qr.,
 - 14. Center 1/4-1/4s S. E. qr.,
 - 15. South 1/4-1/4s S. W. qr.,
 - 16. West 1/4-1/4s S. W. qr.,

Corner Post on line but ways.

no 175
Finish School district
Distance from Finish school to Munson residence = 13,804 feet.
Distance from Finish school to George Verden residence = 13,007 feet.
Floyd S. Jensen CS.
Sept. 15, 1933

NAMES OF SWORN ASSISTANTS

CHAINMEN FLAGMEN AXMEN

no 176

26-2-16

I hereby certify That on the 31 first day of Oct. 1933 I made a survey of that portion of the S. Dixon farm That lies in the Southwest one quarter of section 26, T2N, R16E, of the 4th P.M.

Which is described as follows:


Beginning at the west one quarter section corner of said section 26; Thence East on the one quarter section line 2642.5 feet to the center of section 26; Thence South on the one quarter section line 1320.6 feet to the one eighth section corner; Thence west on the one eighth section line 659.3 feet; Thence north 440.5 feet; Thence west 1986.6 feet to the west line of section 26; Thence north 887.8 feet to the place of beginning, containing 60.2 acres of land more or less.

Lloyd S. Jensen
C.S.
Nov. 1, 1933

In the above survey the lines were taken as the lines.
S.S.P.

no 177

Lots 1 & 2 of the Revised
Plat of THE GARDENS.

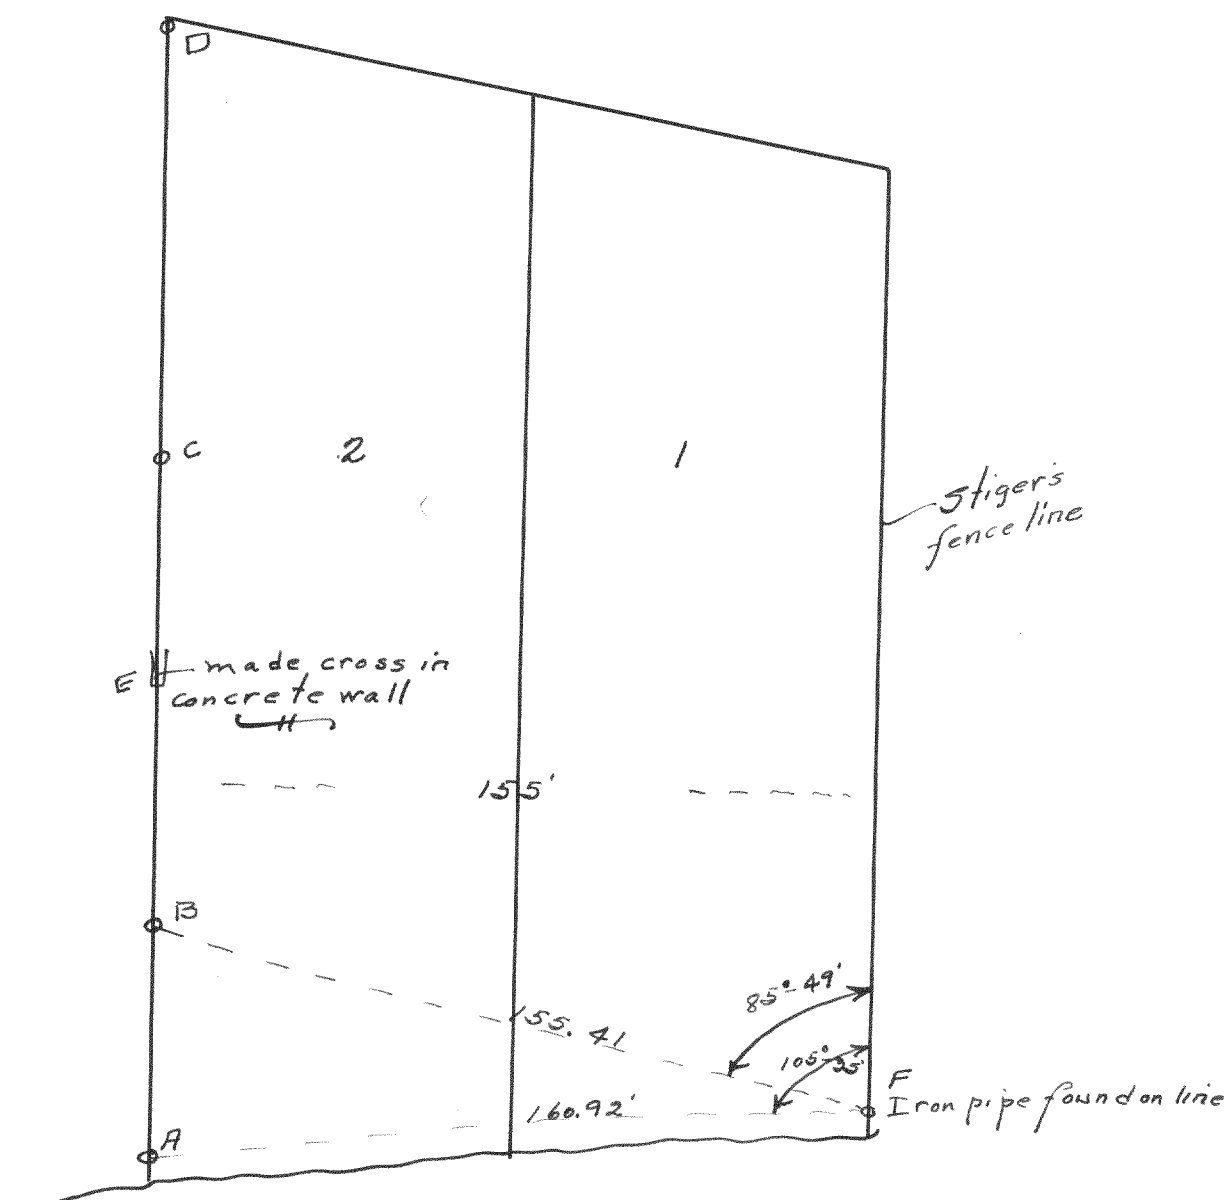

Found pipe on Stigens south line at F.
Turned angle $85^{\circ} 49'$ and measured 155.41 to locate the S. line of lot 2. Turned angle $105^{\circ} 35'$ & measured 160.92 to locate a point on the lake shore. Placed iron pipes at C and D. Put cross in end of concrete wall at E (+). Platted distances in the revised plat were used to relocate the south line of lot 2.

Lloyd S. Jensen
C.S.

Oct. 30, 1933