

Record of Survey.

DESCRIPTION

98

no 306


Township....., North of Range..... of 4 Principal Meridian

as presented by the courses and distances on the following plat, and annexed field-notes of survey:

Established the center of the section at the point of intersection of STRAIGHT quarter lines.

Established all quarter-quarter corners upon the section boundary at proportional distances between known section and quarter section corners, according to the original field-notes of the Government survey.

Established all lost corners at proportionate distances between known corners, according to the original field notes of the Government survey.

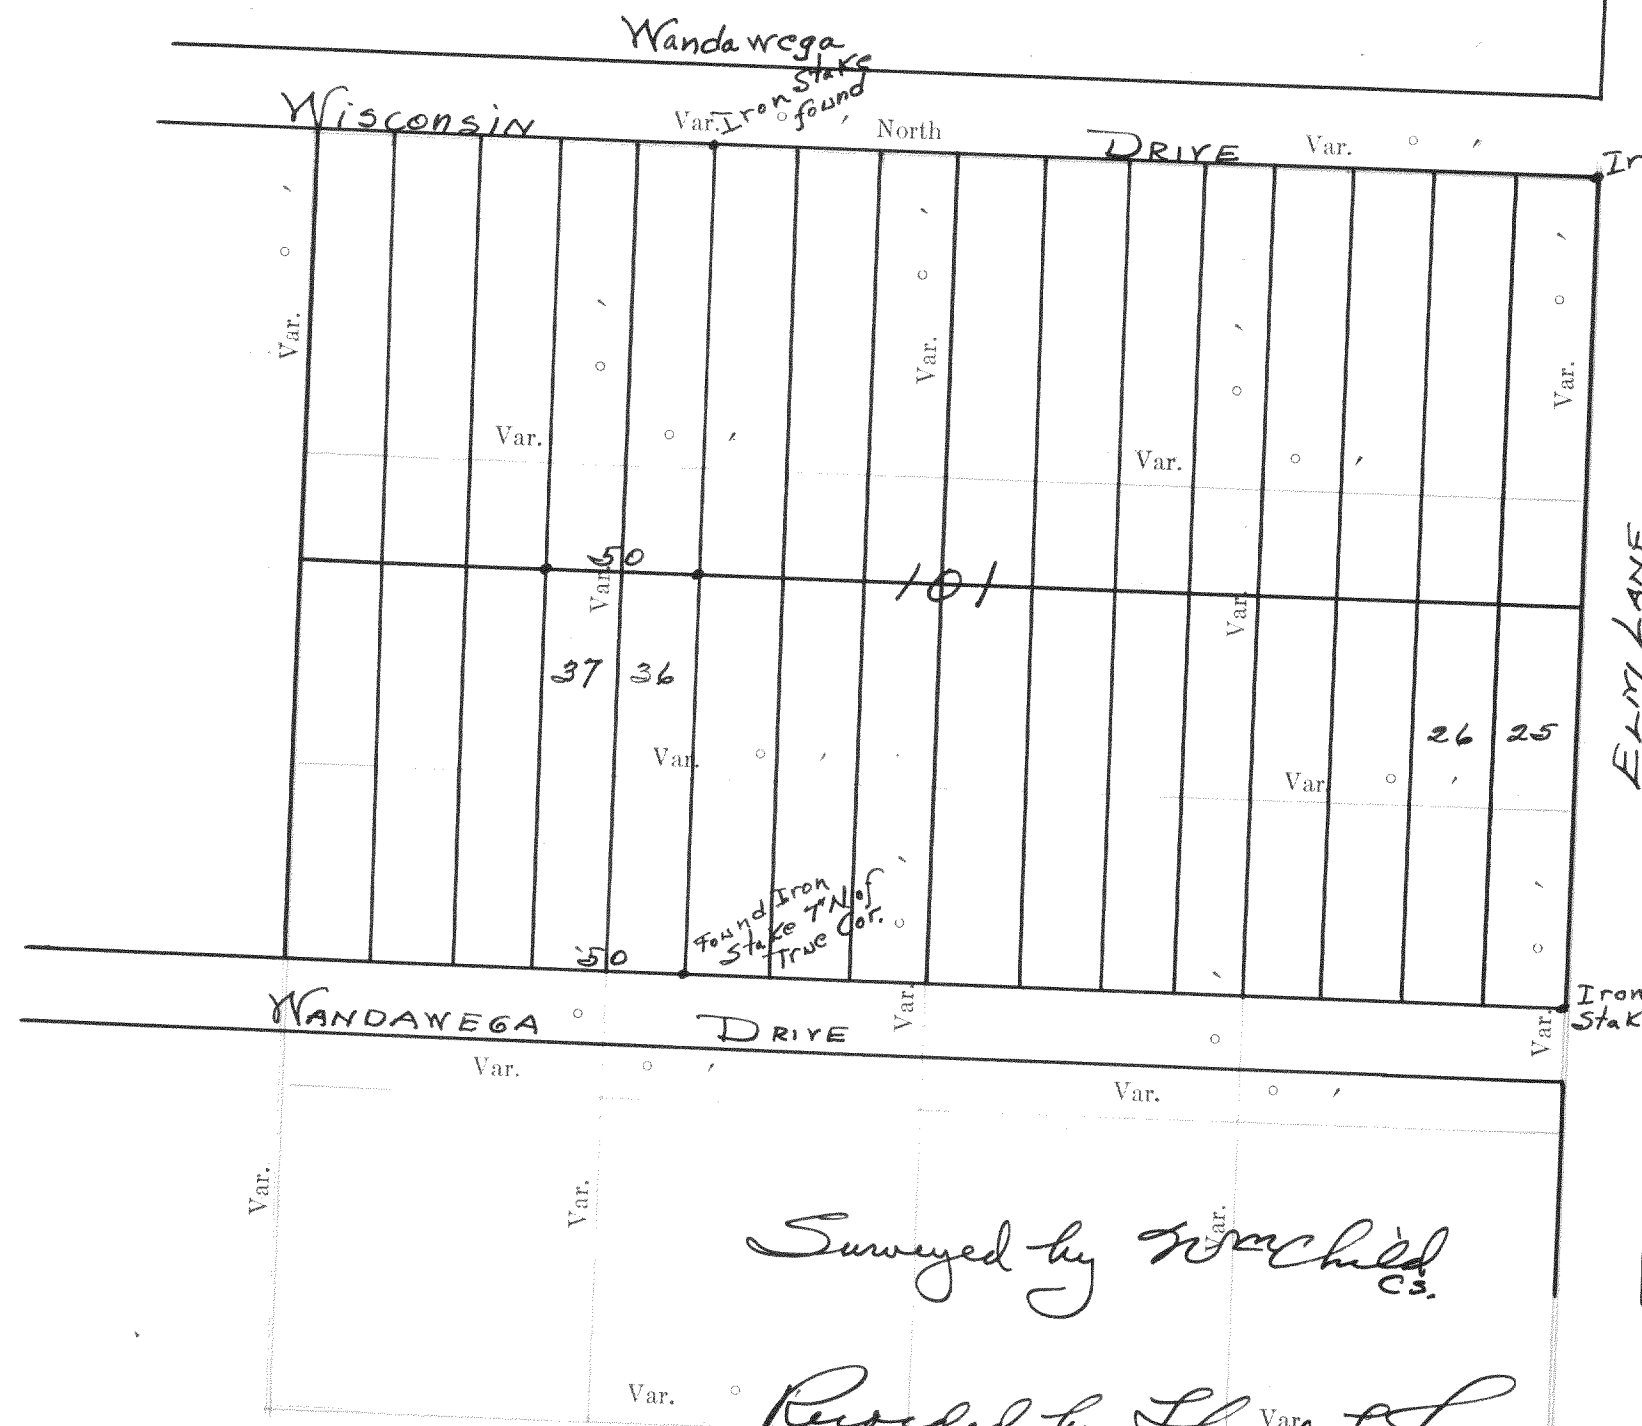


Plat of Section....., Township..... North, Range..... of 4 Principal Meridian Scale 80 chains to 6 inches. The figures in red ink are the lengths of the lines as stated in the field-notes of the Government survey.

Declination of the Magnetic Meridian from the True Meridian..... A. D. 1....., in accordance with the State Laws and Instructions of the Commissioner of the General Land office, and recorded on pages..... of Register in the County Clerk's office.


Witness my hand this..... day of..... A. D. 1..... SURVEYOR.

OF SECTION, QUARTER SECTION AND QUARTER QUARTER SECTION CORNERS

GOVERNMENT CORNERS				N. C. MILLER CO. MFG. STATIONERS, MILWAUKEE WISCONSIN			
No.	Bearing	In. Dia.	Courses they bear	Links Distant	Bearing	In. Dia.	Courses they bear
1. N. W. Sec. Cor. identified,							
2. N. E. Sec. Cor. identified,							
3. S. E. Sec. Cor. identified,							
4. S. W. Sec. Cor. identified,							
5. N. 1/4 Sec. Cor. identified,							
6. E. 1/4 Sec. Cor. identified,							
7. S. 1/4 Sec. Cor. identified,							
8. W. 1/4 Sec. Cor. identified,							
Subdivision Corners							
No.	Bearing	In. Dia.	Courses they bear	Links Distant	Bearing	In. Dia.	Courses they bear
1. Center 1/4 Sec. Cor.							
2. North 1/4-1/4s N. W. qr.,							
3. East 1/4-1/4s N. W. qr.,							
4. South 1/4-1/4s N. W. qr.,							
5. West 1/4-1/4s N. W. qr.,							
6. Center 1/4-1/4s N. W. qr.,							
7. North 1/4-1/4s N. E. qr.,							
8. East 1/4-1/4s N. E. qr.,							
9. South 1/4-1/4s N. E. qr.,							
10. Center 1/4-1/4s N. E. qr.,							
11. East 1/4-1/4s S. E. qr.,							
12. South 1/4-1/4s S. E. qr.,							
13. West 1/4-1/4s S. E. qr.,							
14. Center 1/4-1/4s S. E. qr.,							
15. South 1/4-1/4s S. W. qr.,							
16. West 1/4-1/4s S. W. qr.,							
17. Center 1/4-1/4s S. W. qr.,							

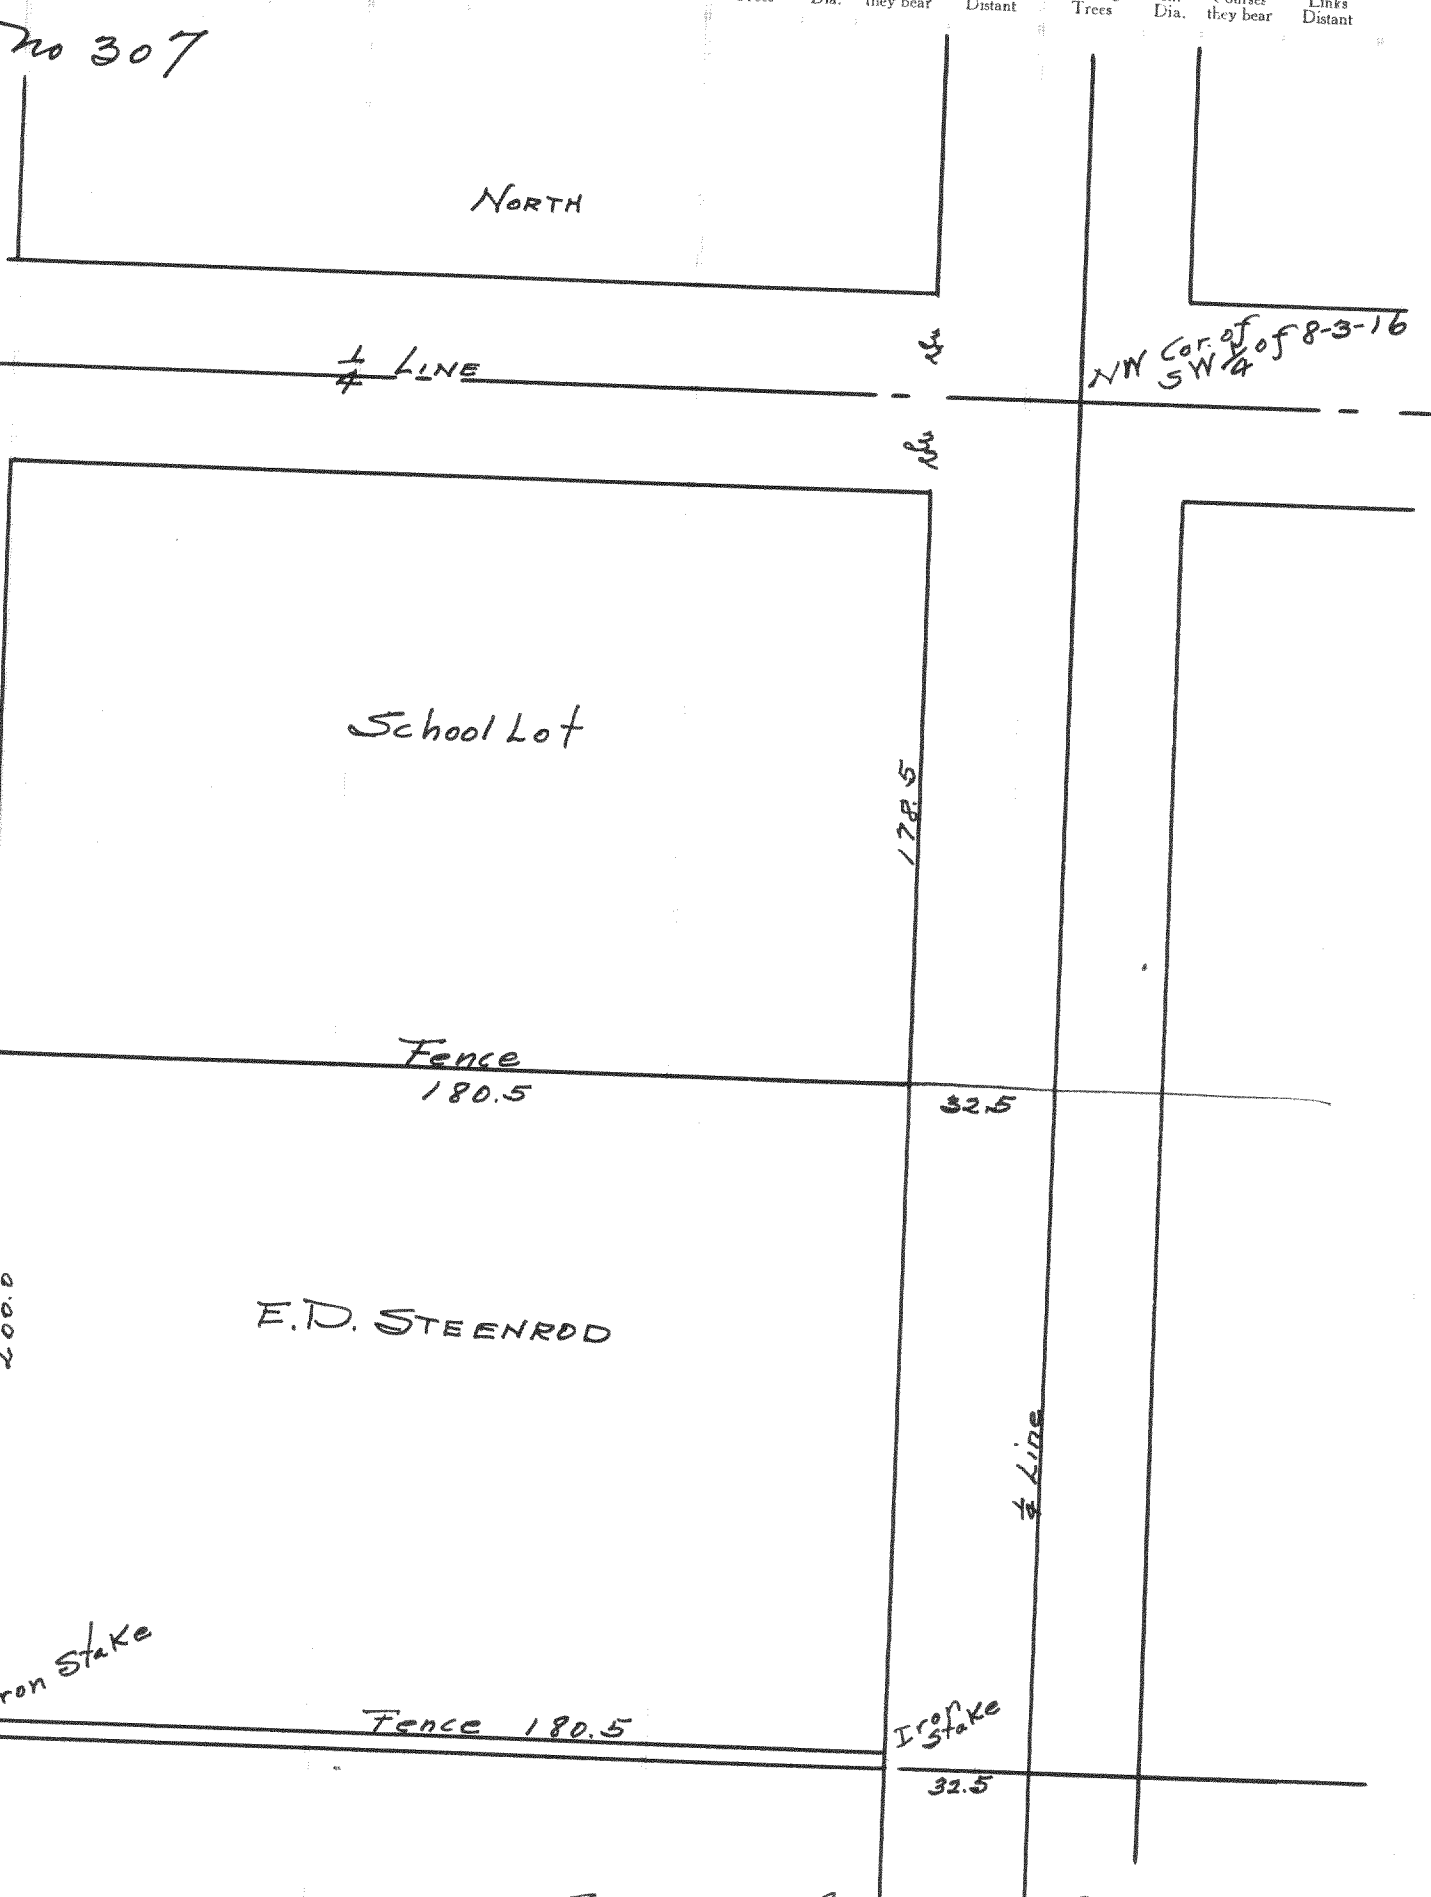

Surveyed by Wm Child Es.
 NAMES OF SWORN ASSISTANTS
 FLAGMEN
 AXMEN
 Recorded by Lloyd S. Jensen Es.
 Feb. 27, 1934

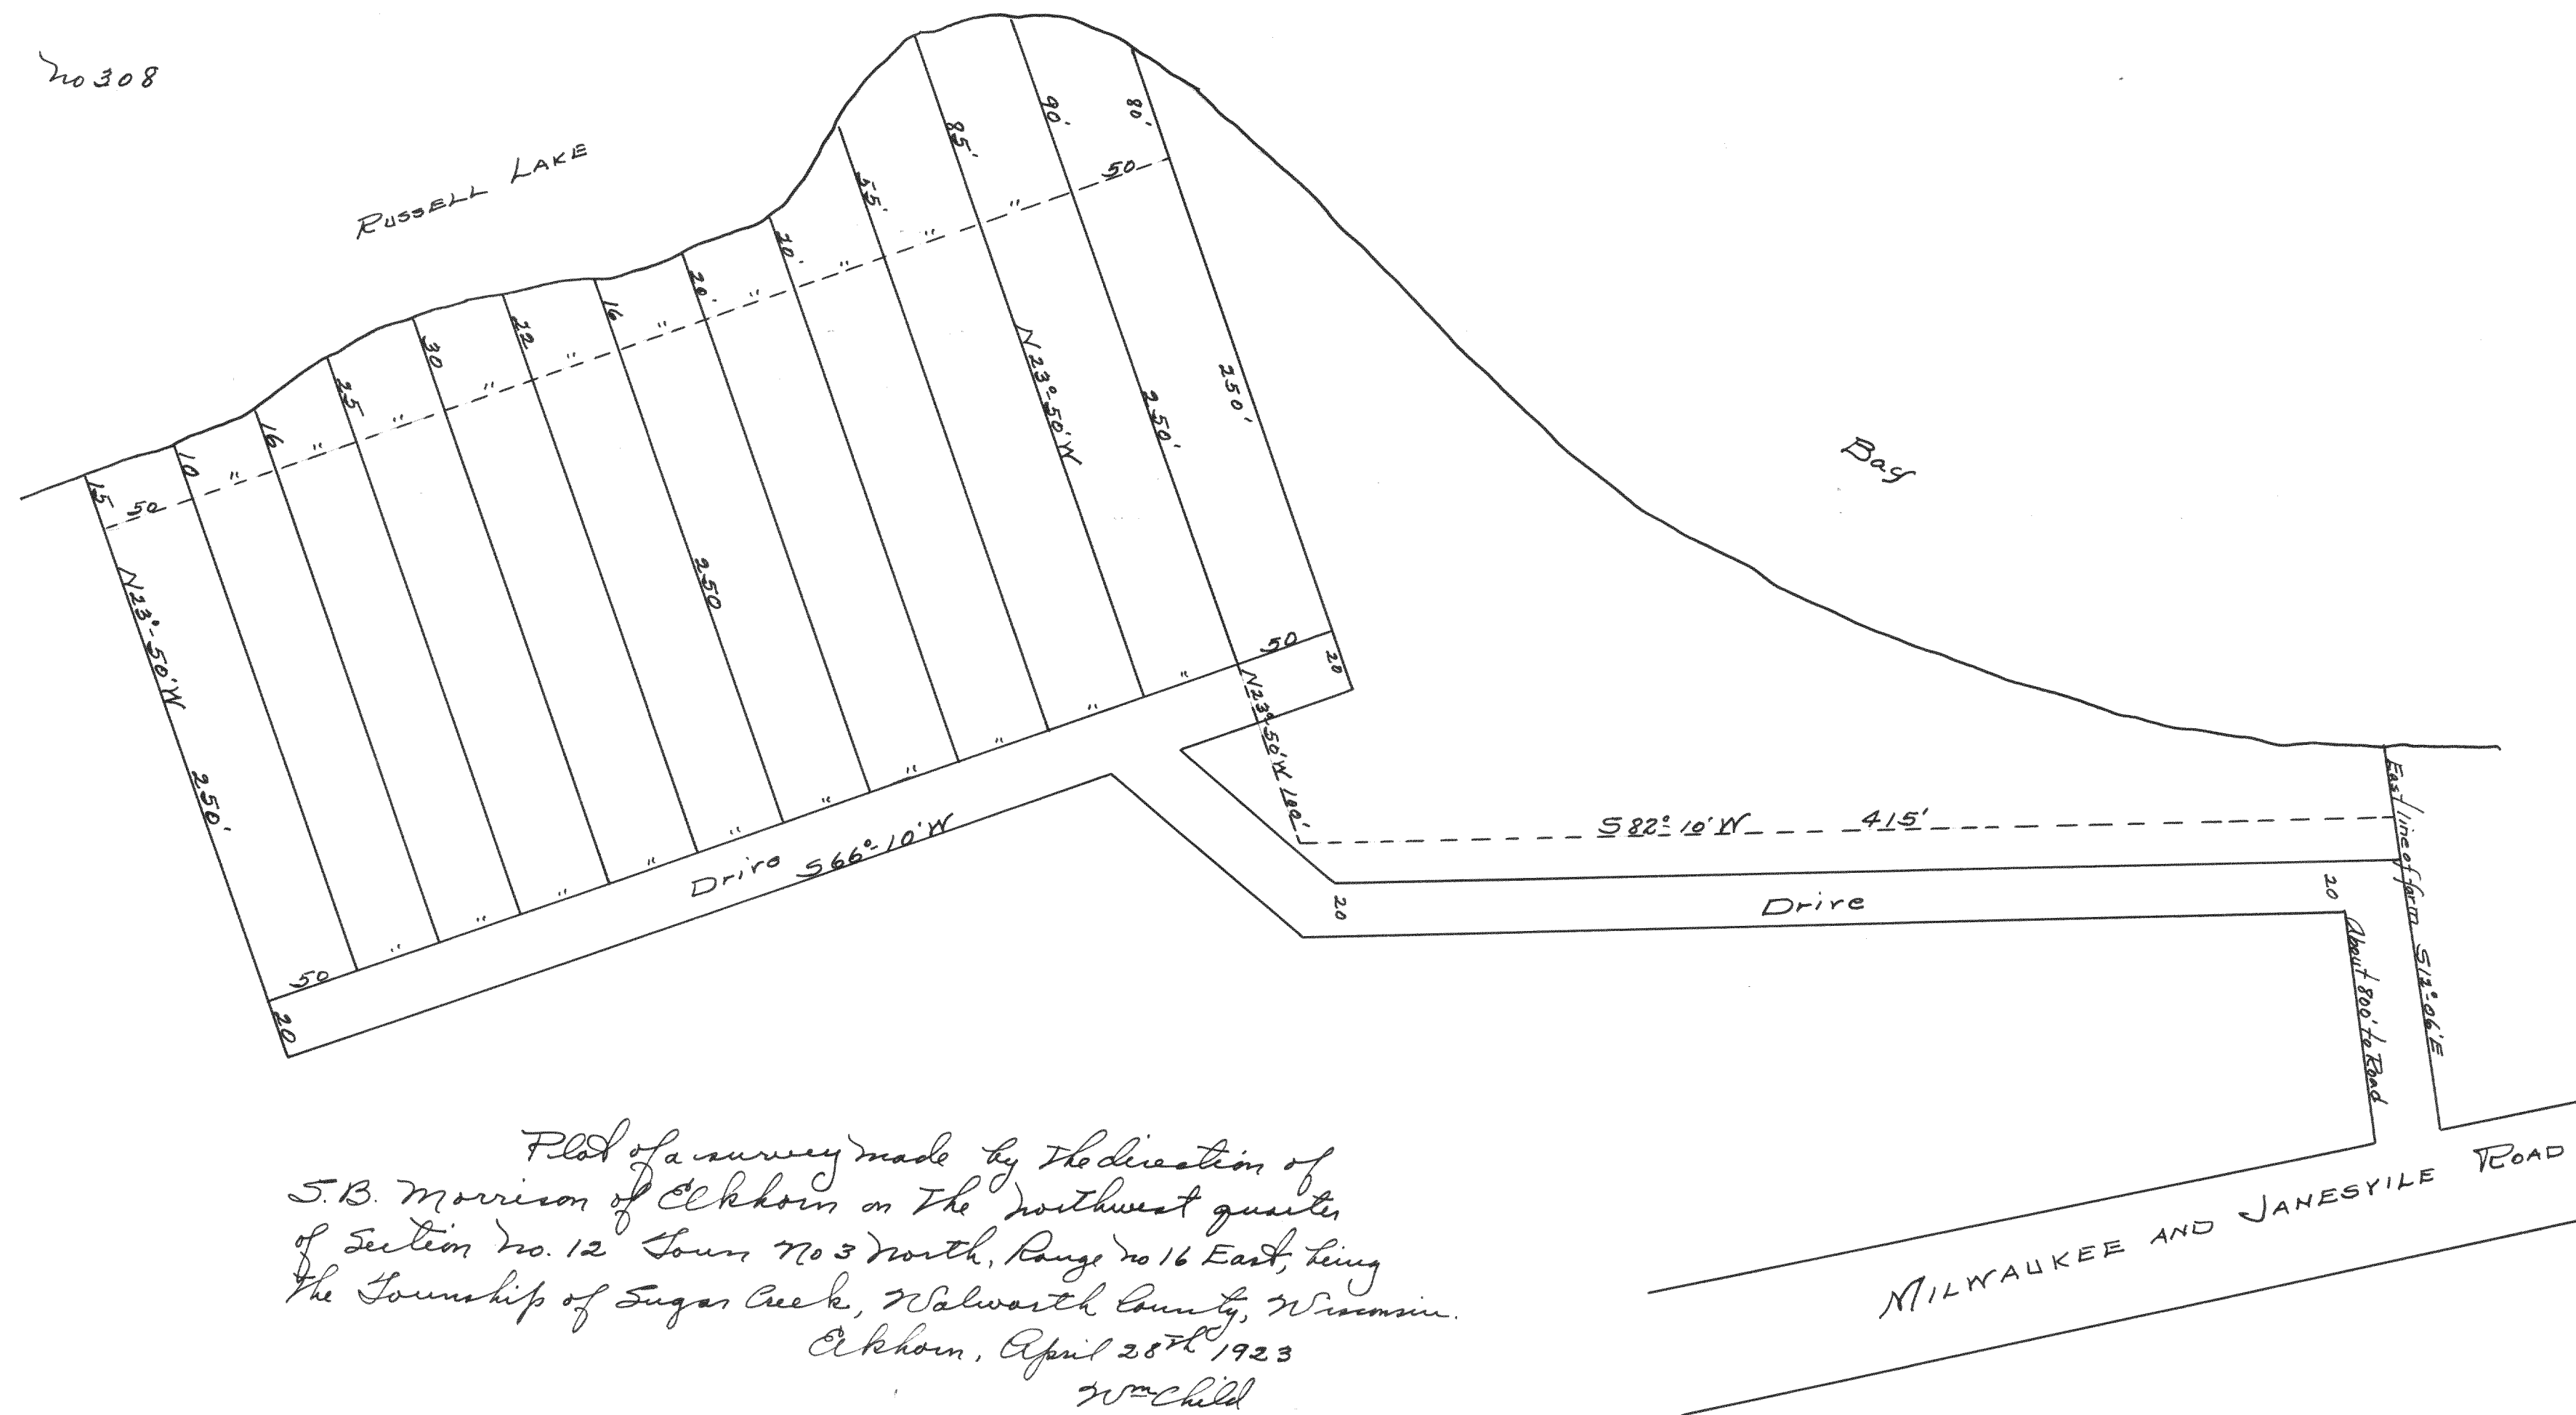

Plot of a survey made by the direction of
S. B. Morrison of Elkhorn on the Northwest quarter
of Section No. 12 Town No 3 North, Range No 16 East, lying
the Township of Sugar Creek, Walworth County, Wisconsin.
Elkhorn, April 28th 1923
Wm Child
County Surveyor.

Recorded by Lloyd S. Jones
Feb. 28, 1934