


Record of Survey.

DESCRIPTION

224


OF SECTION, QUARTER SECTION AND QUARTER QUARTER SECTION CORNERS

Township....., North of Range..... of 4 Principal Meridian as presented by the courses and distances on the following plat, and annexed field-notes of survey:
 Established the center of the section at the point of intersection of STRAIGHT quarter lines.
 Established all quarter-quarter corners upon the section boundary at proportional distances between known section and quarter section corners, according to the original field-notes of the Government survey.
 Established all lost corners at proportionate distances between known corners, according to the original field notes of the Government survey.

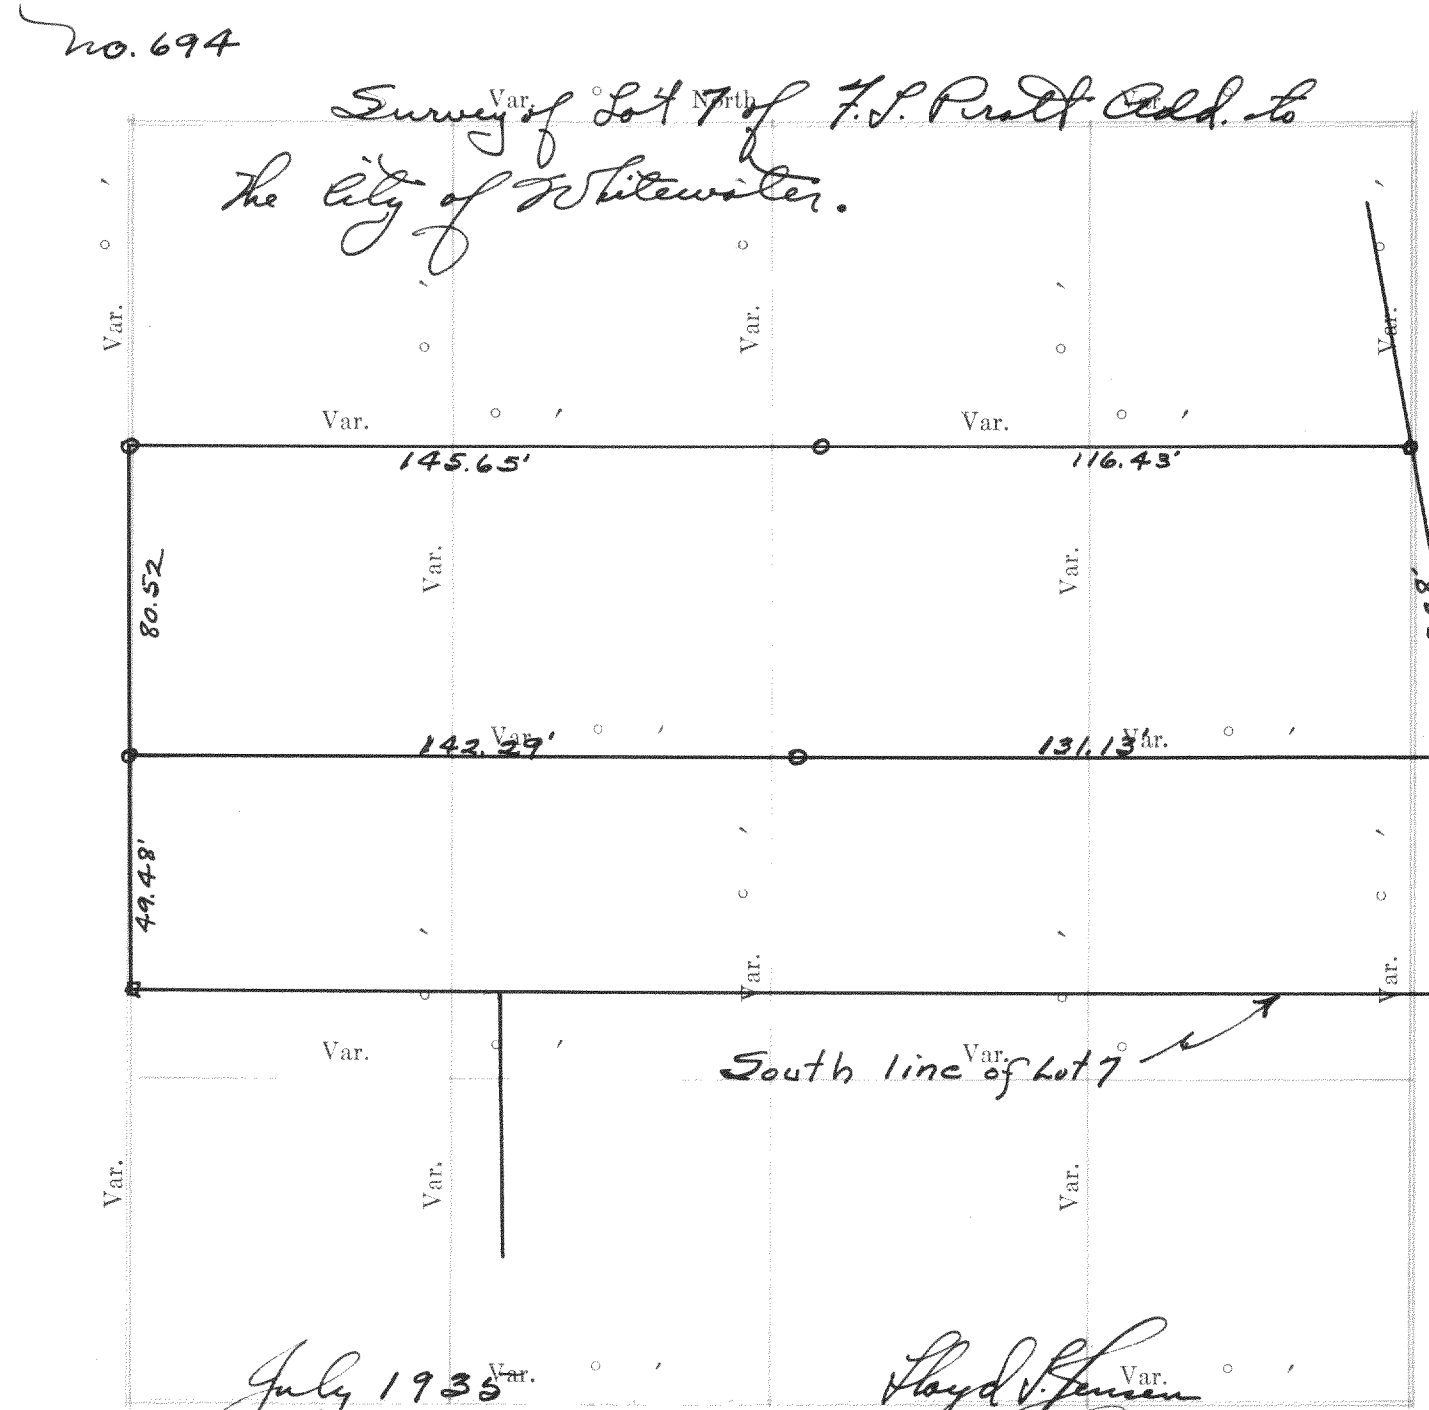

- GOVERNMENT CORNERS
- No. 1. N. W. Sec. Cor. identified,
 2. N. E. Sec. Cor. identified,
 3. S. E. Sec. Cor. identified,
 4. S. W. Sec. Cor. identified,
 5. N. ¼ Sec. Cor. identified,
 6. E. ¼ Sec. Cor. identified,
 7. S. ¼ Sec. Cor. identified,
 8. W. ¼ Sec. Cor. identified,
- Subdivision Corners
- No. 1. Center ¼ Sec. Cor.,
 2. North ¼-¼s N. W. qr.,
 3. East ¼-¼s N. W. qr.,
 4. South ¼-¼s N. W. qr.,
 5. West ¼-¼s N. W. qr.,
 6. Center ¼-¼s N. W. qr.,
 7. North ¼-¼s N. E. qr.,
 8. East ¼-¼s N. E. qr.,
 9. South ¼-¼s N. E. qr.,
 10. Center ¼-¼s N. E. qr.,
 11. East ¼-¼s S. E. qr.,
 12. South ¼-¼s S. E. qr.,
 13. West ¼-¼s S. E. qr.,
 14. Center ¼-¼s S. E. qr.,
 15. South ¼-¼s S. W. qr.,
 16. West ¼-¼s S. W. qr.,
 17. Center ¼-¼s S. W. qr.,

no. 695 Survey in the NW ¼ of NW ¼ of Section 36-4-16

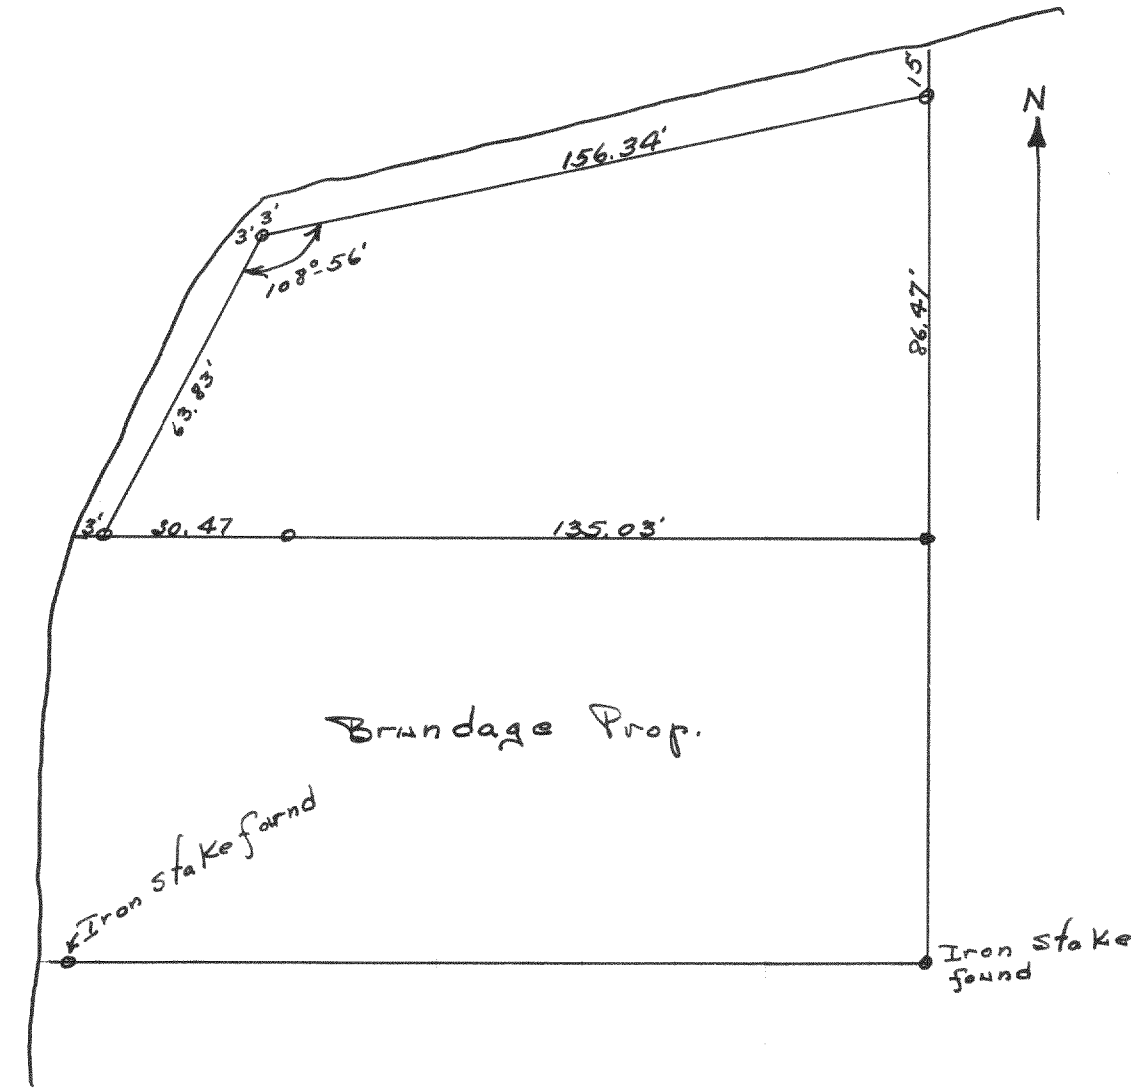


Brundage property laid off and land lying north of this N. line was taken as covered.
 July 1935
 Lloyd V. Jensen
 County Surveyor

Plat of Section....., Township..... North, Range..... of 4 Principal Meridian Scale 80 chains to 6 inches. The figures in red ink are the lengths of the lines as stated in the field-notes of the Government survey.
 Declination of the Magnetic Meridian from the True Meridian.....
 Surveyed and sub-divided..... A. D. 1....., in accordance with the State Laws and Instructions of the Commissioner of the General Land office, and recorded on pages..... of Register in the County Clerk's office.
 Witness my hand this..... day of..... A. D. 1.....
 SURVEYOR.

CHAINMEN	NAMES OF SWORN ASSISTANTS	AXMEN
	FLAGMEN	


Survey of Town hall property for
Richmond Township in Section 17-3-15.

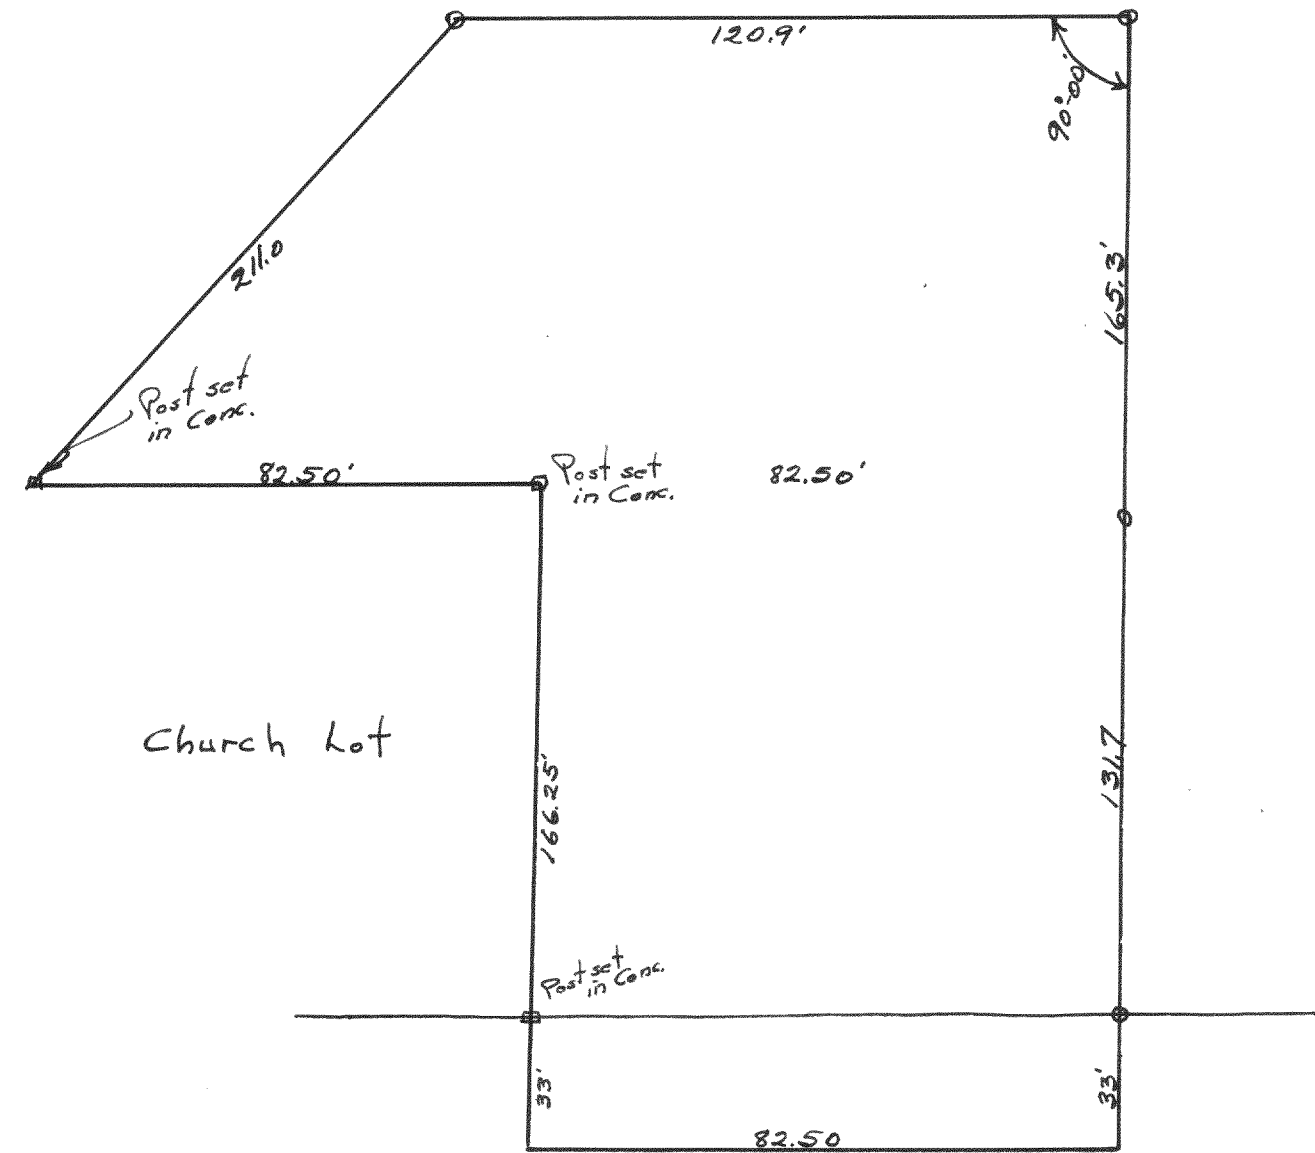

Description is tied into the church lot
and said parcel was used to lay out
the land owned by the Township.

Aug. 1935

Lloyd V. Jensen
County Surveyor.

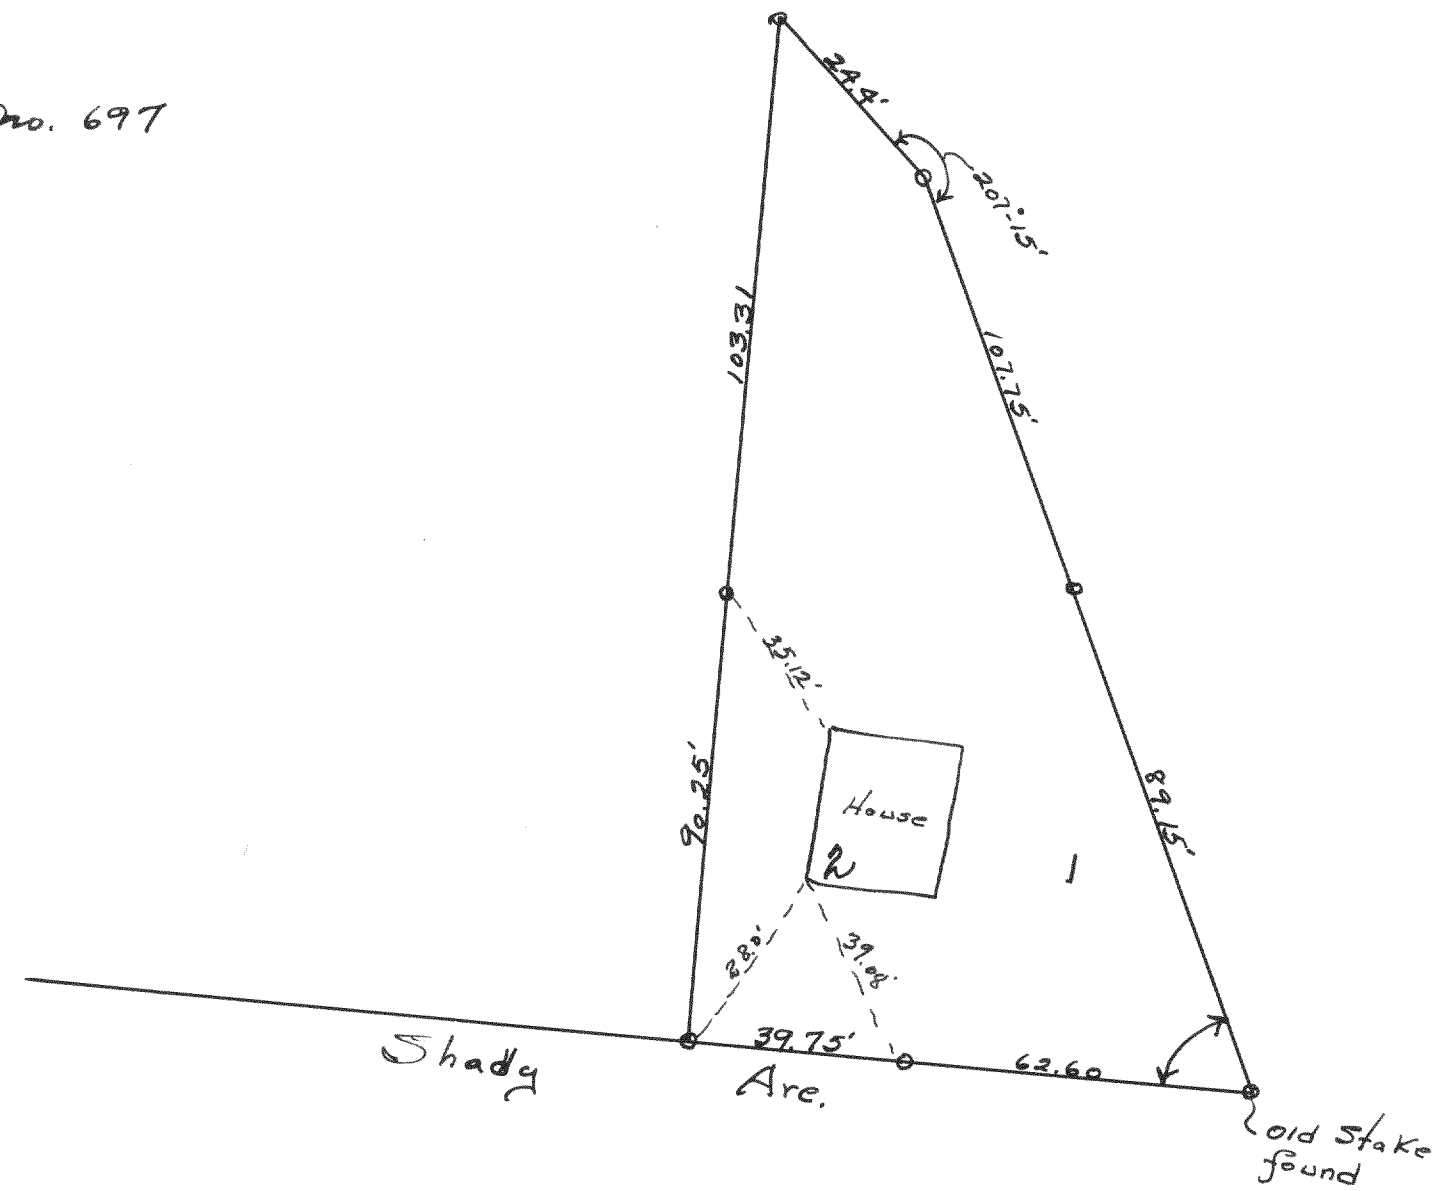

Survey of lots 1 and 2 of Block 3
of Dulit Oaks Subd.

May 17, 1935

Lloyd V. Jensen
Co. Surveyor.