


No. 815

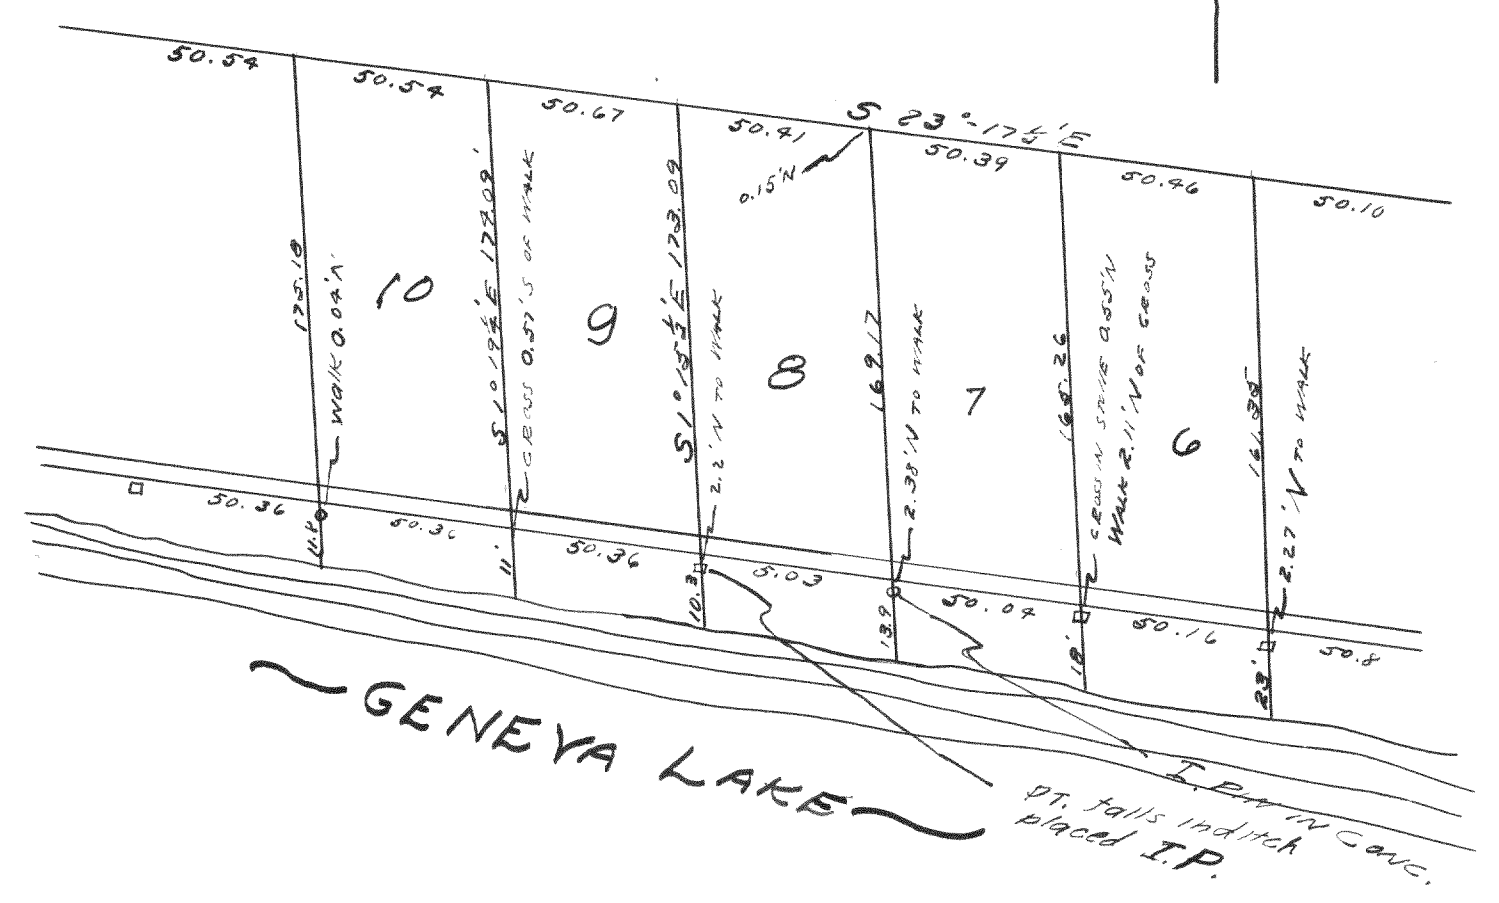


Survey of lot 8 of Elgin Club. - formerly lot 8 of Lake View Park.

May 1937

Lloyd L. Jensen
by H.E.J.

No. 816

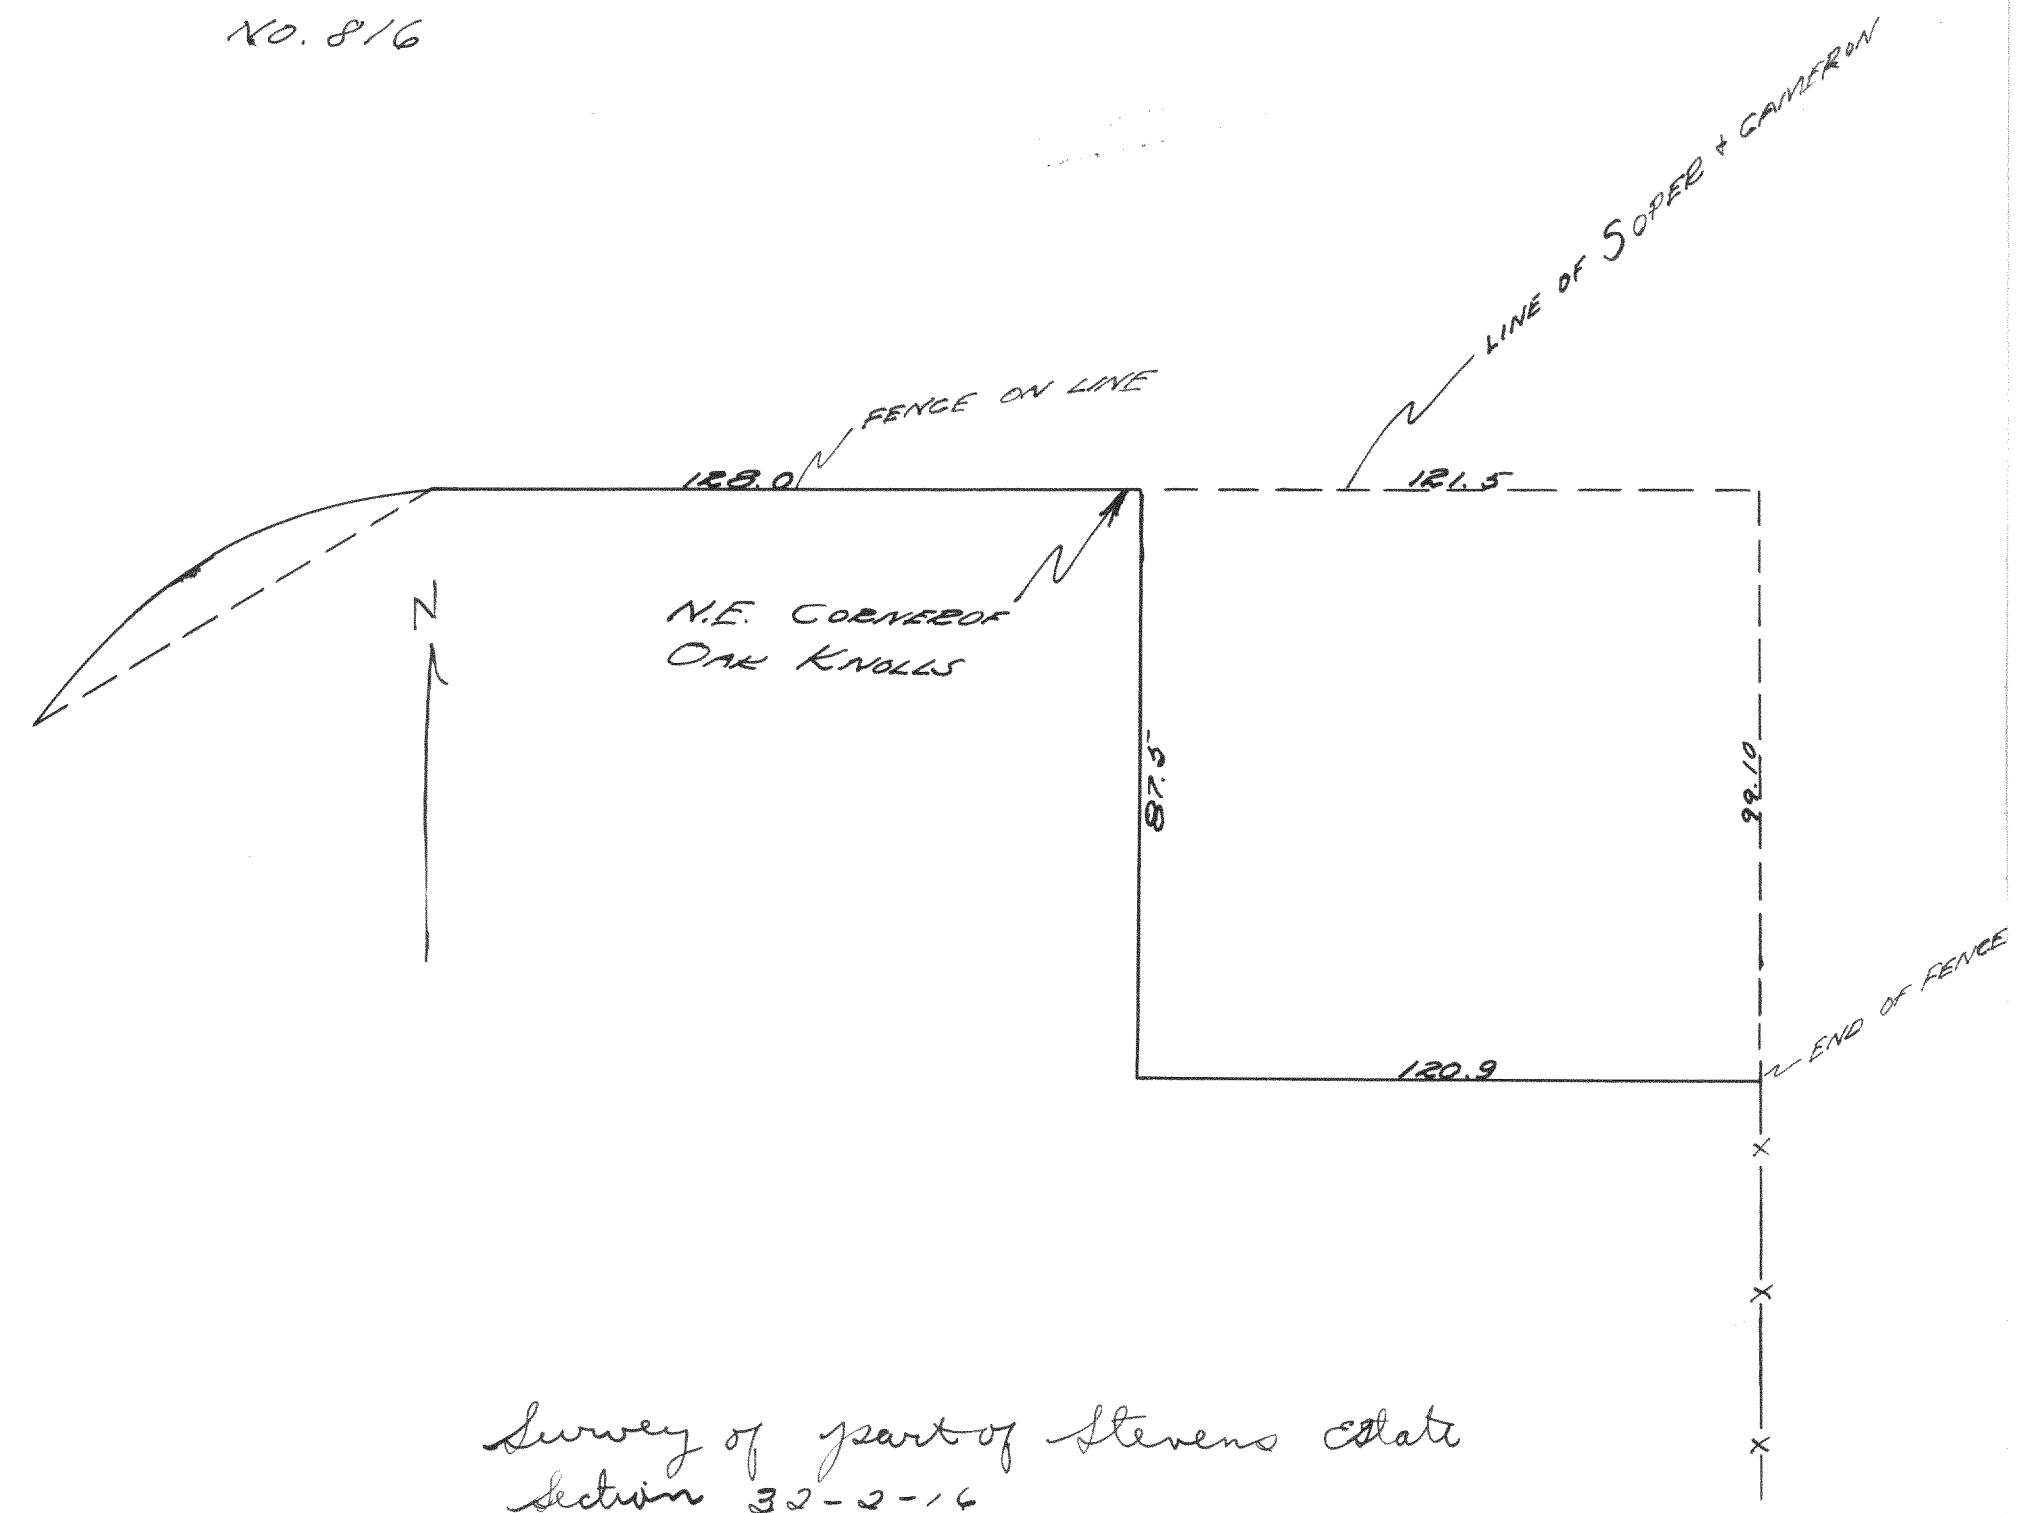

Survey of part of Stevens estate
Section 32-2-16
1937

Lloyd L. Jensen
by H.E.J.