


NO. 924

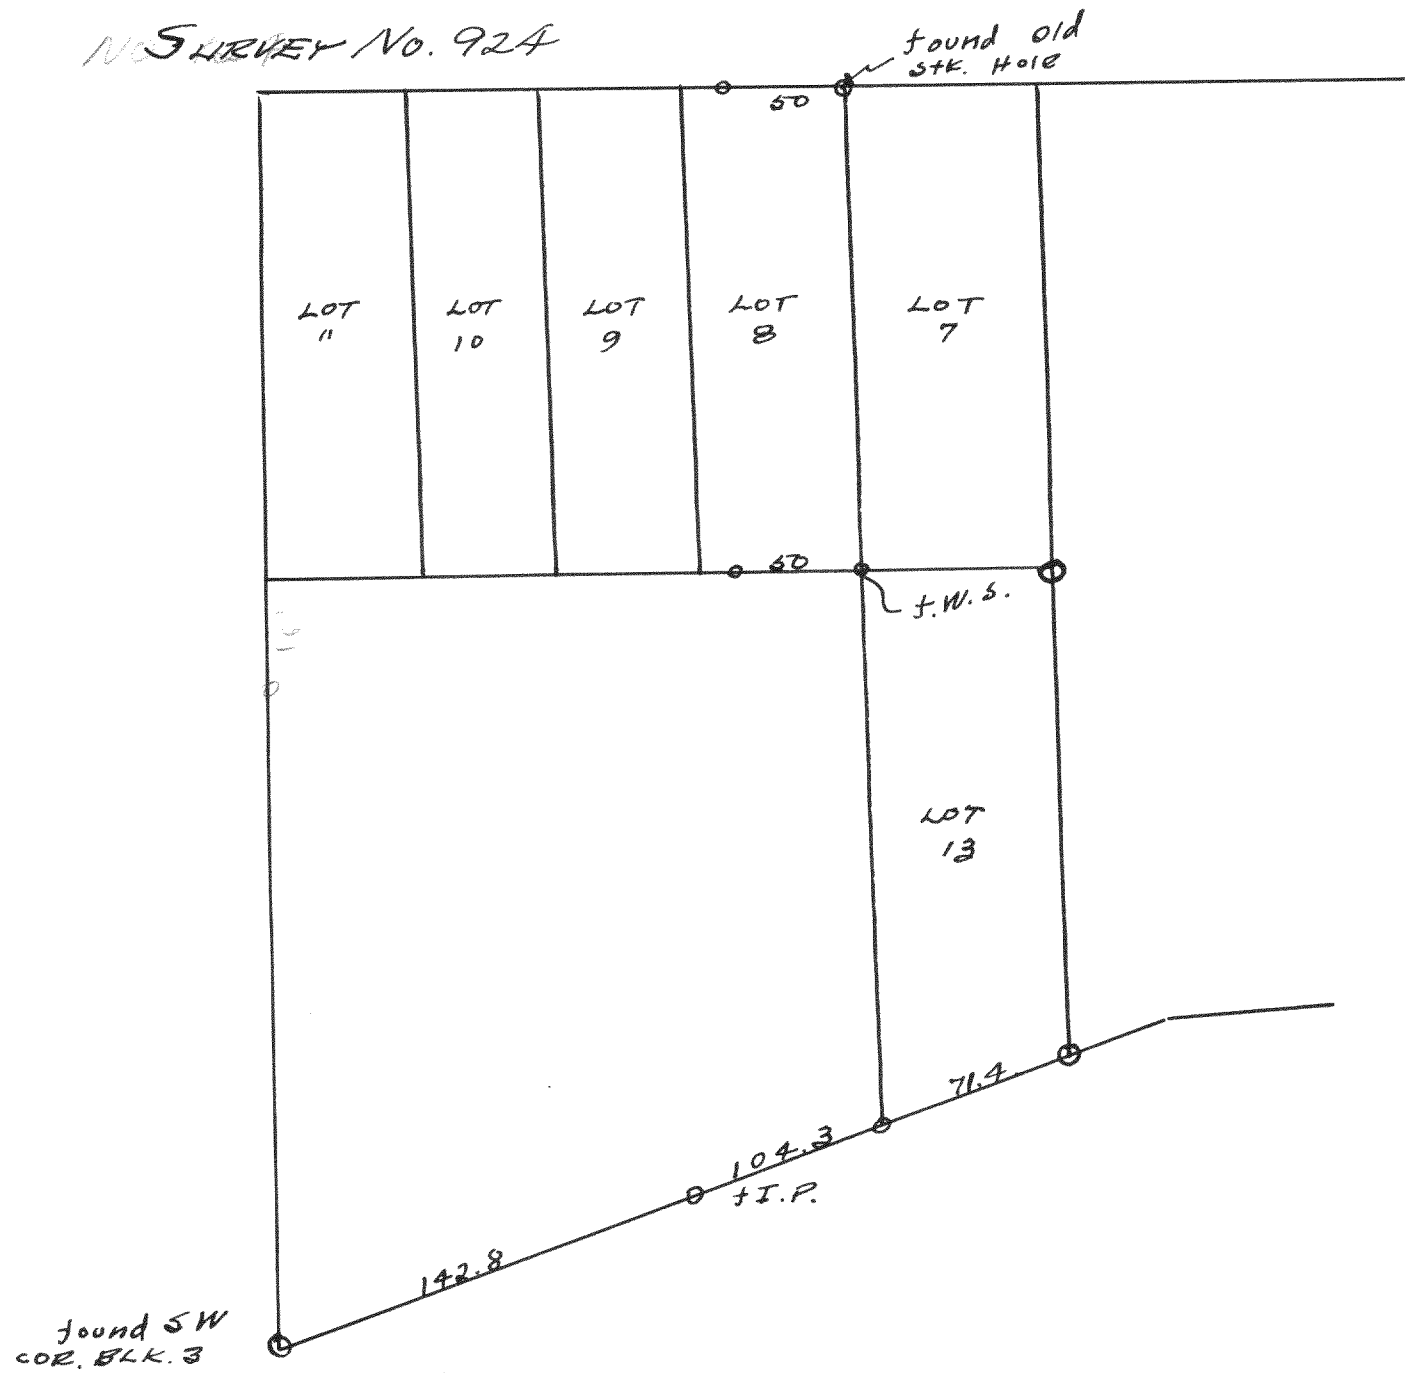


Survey of lot 8, 13 and 12 of
Block 3 of the original
plat of the Village of Thoms. Bay

6-14-16-37

Lloyd L. Jensen
by H. S. J.

925

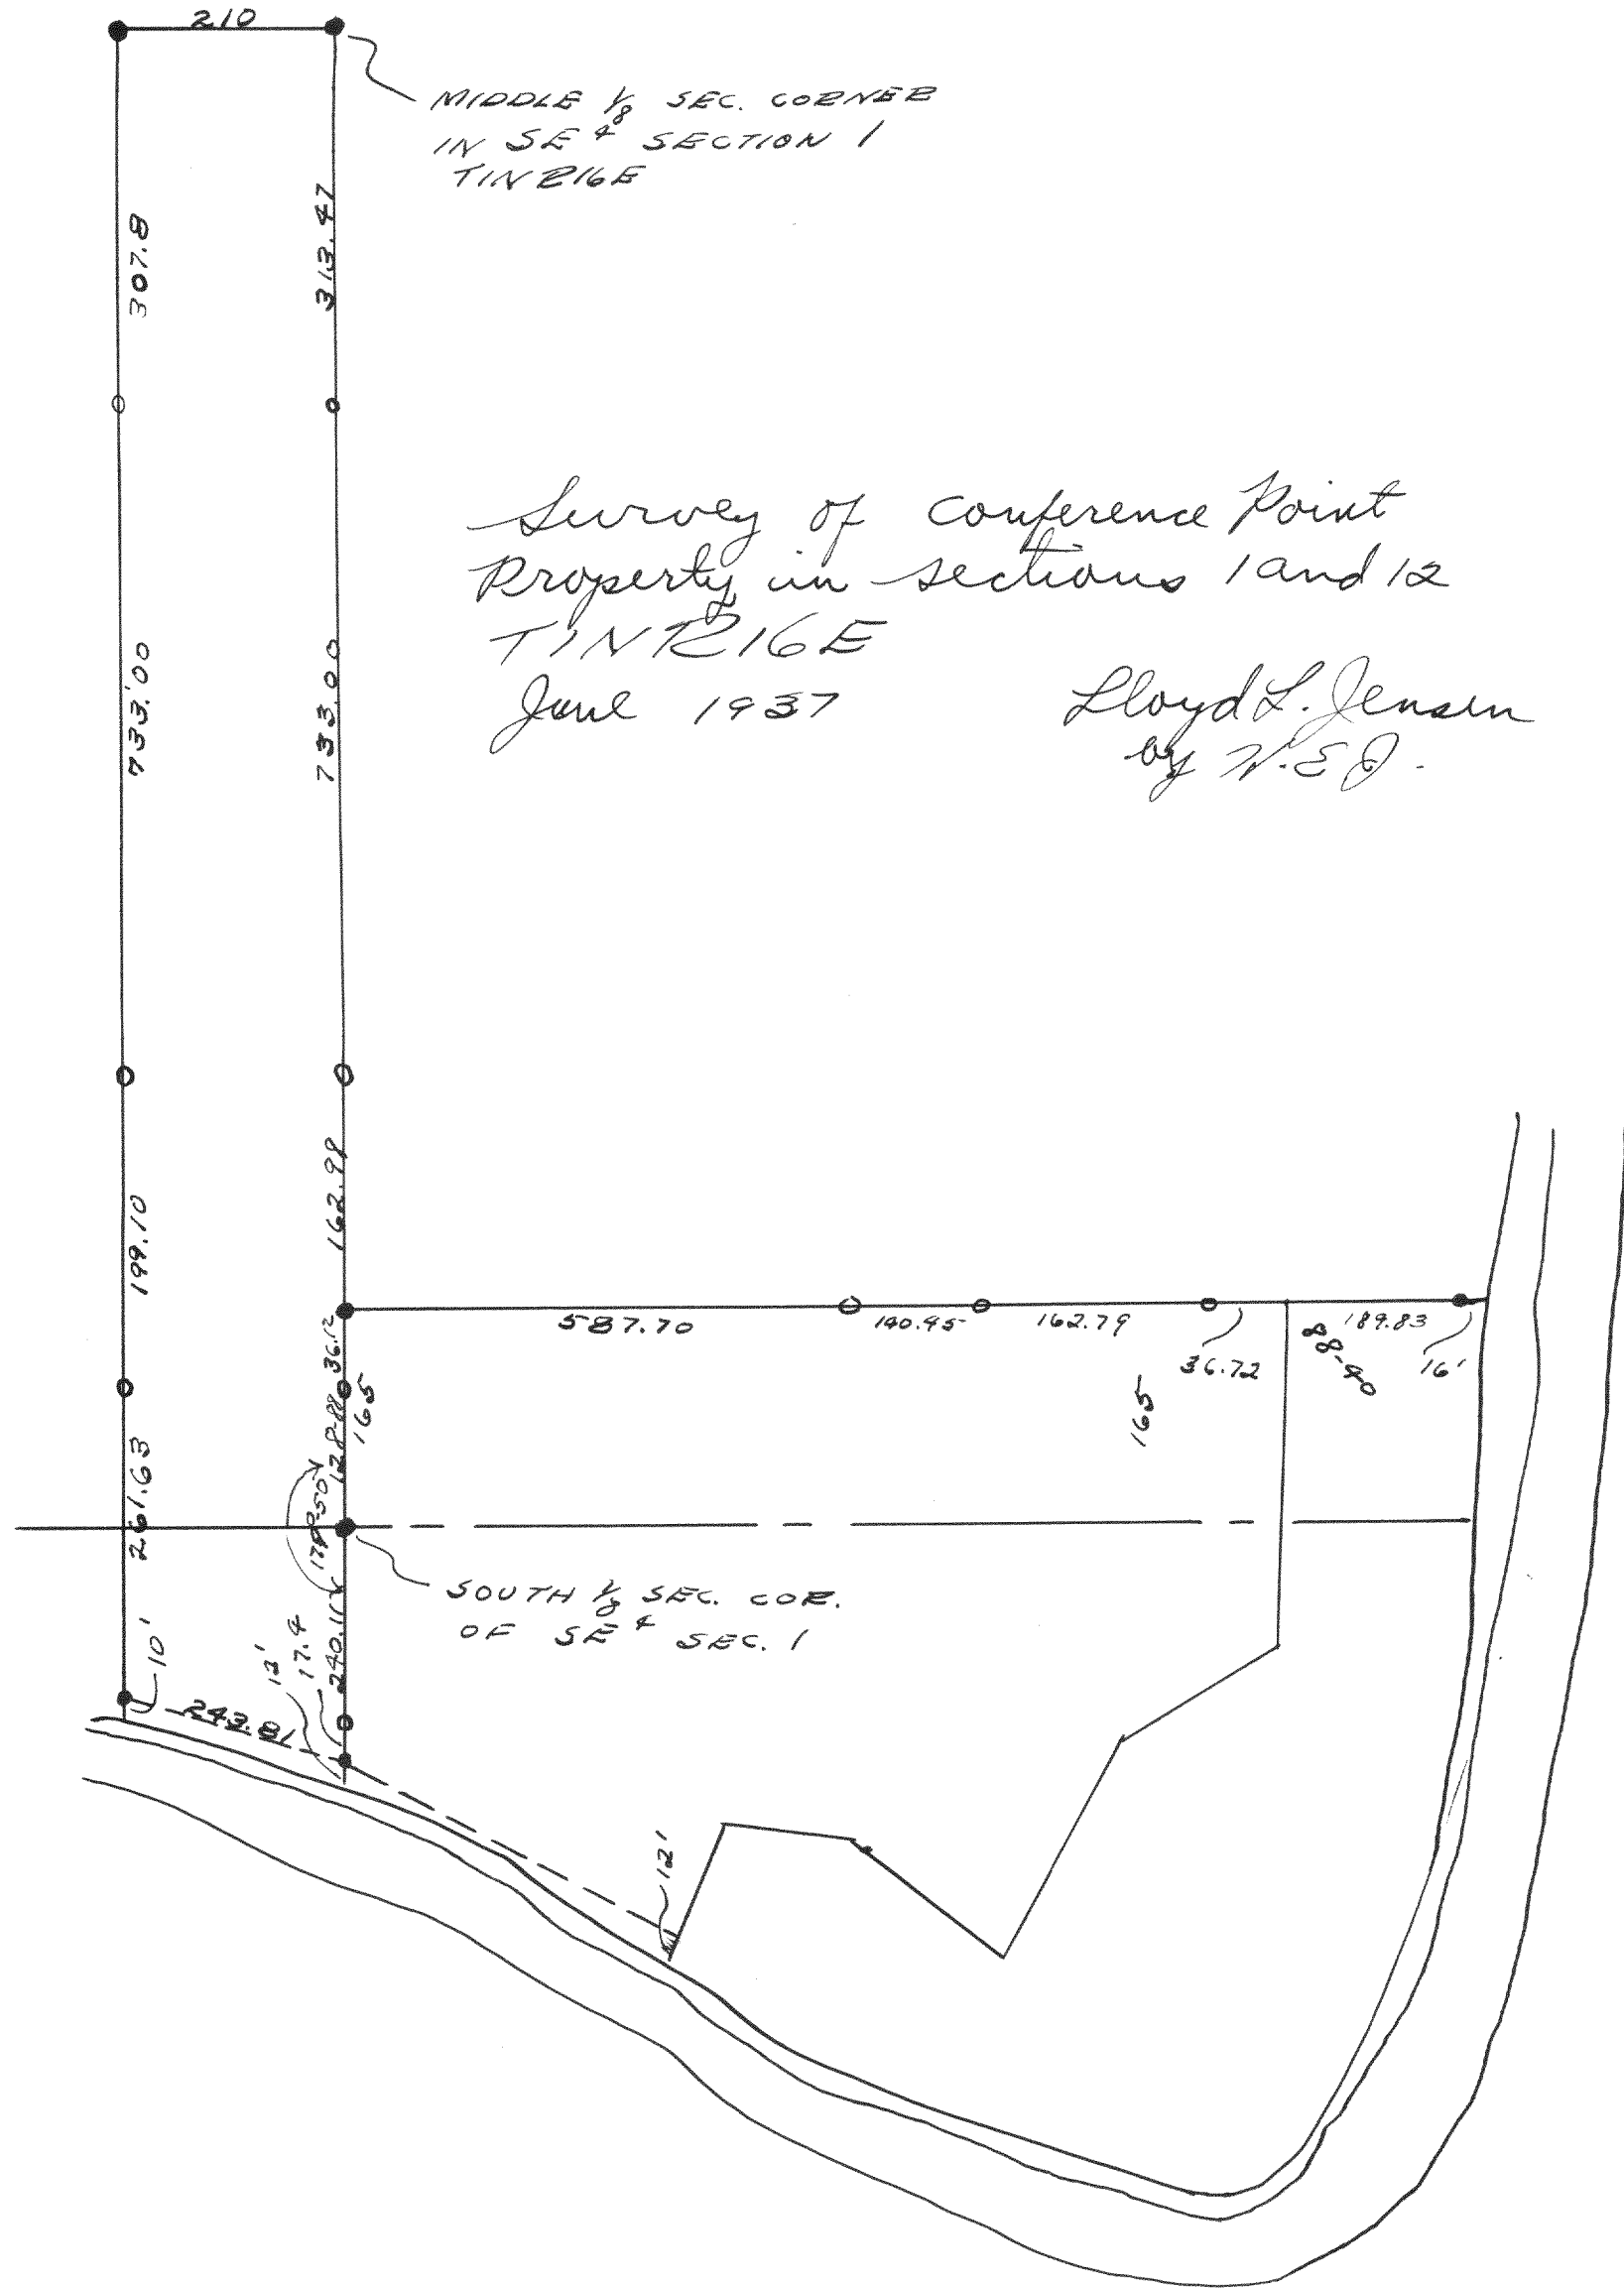

Survey of Conference Point
Property in sections 1 and 12
T1N216E

June 1937

Lloyd L. Jensen
by H. S. J.