



SURVEY NO. 1091

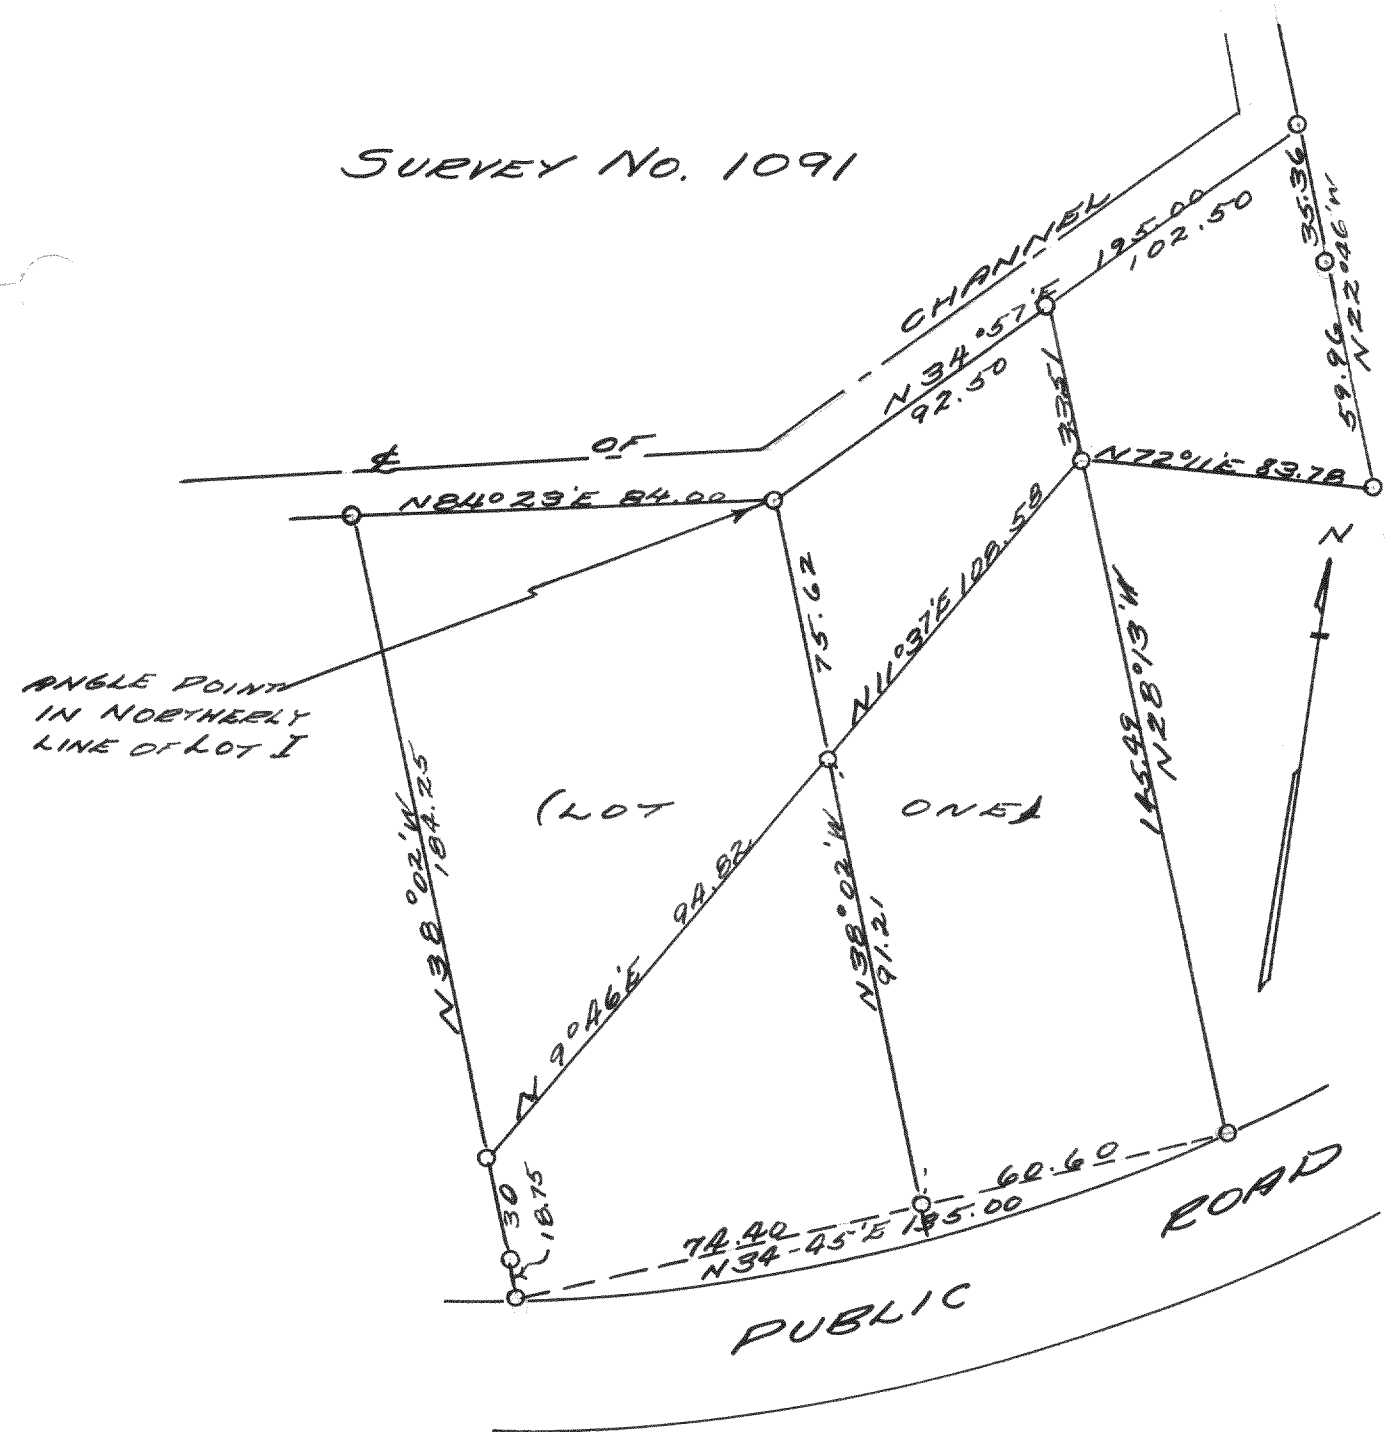

PLAT OF SURVEY OF PART OF LOT I  
AND PART OF "EASEMENT PARK" OF  
UNIT NO. I OF COUNTRY CLUB ESTATES IN  
THE VILLAGE OF FONTANA-ON-GENEVA  
LAKE  
NOV. 1940

Lloyd L. Jensen  
H.E.S.


SURVEY NO. 1092

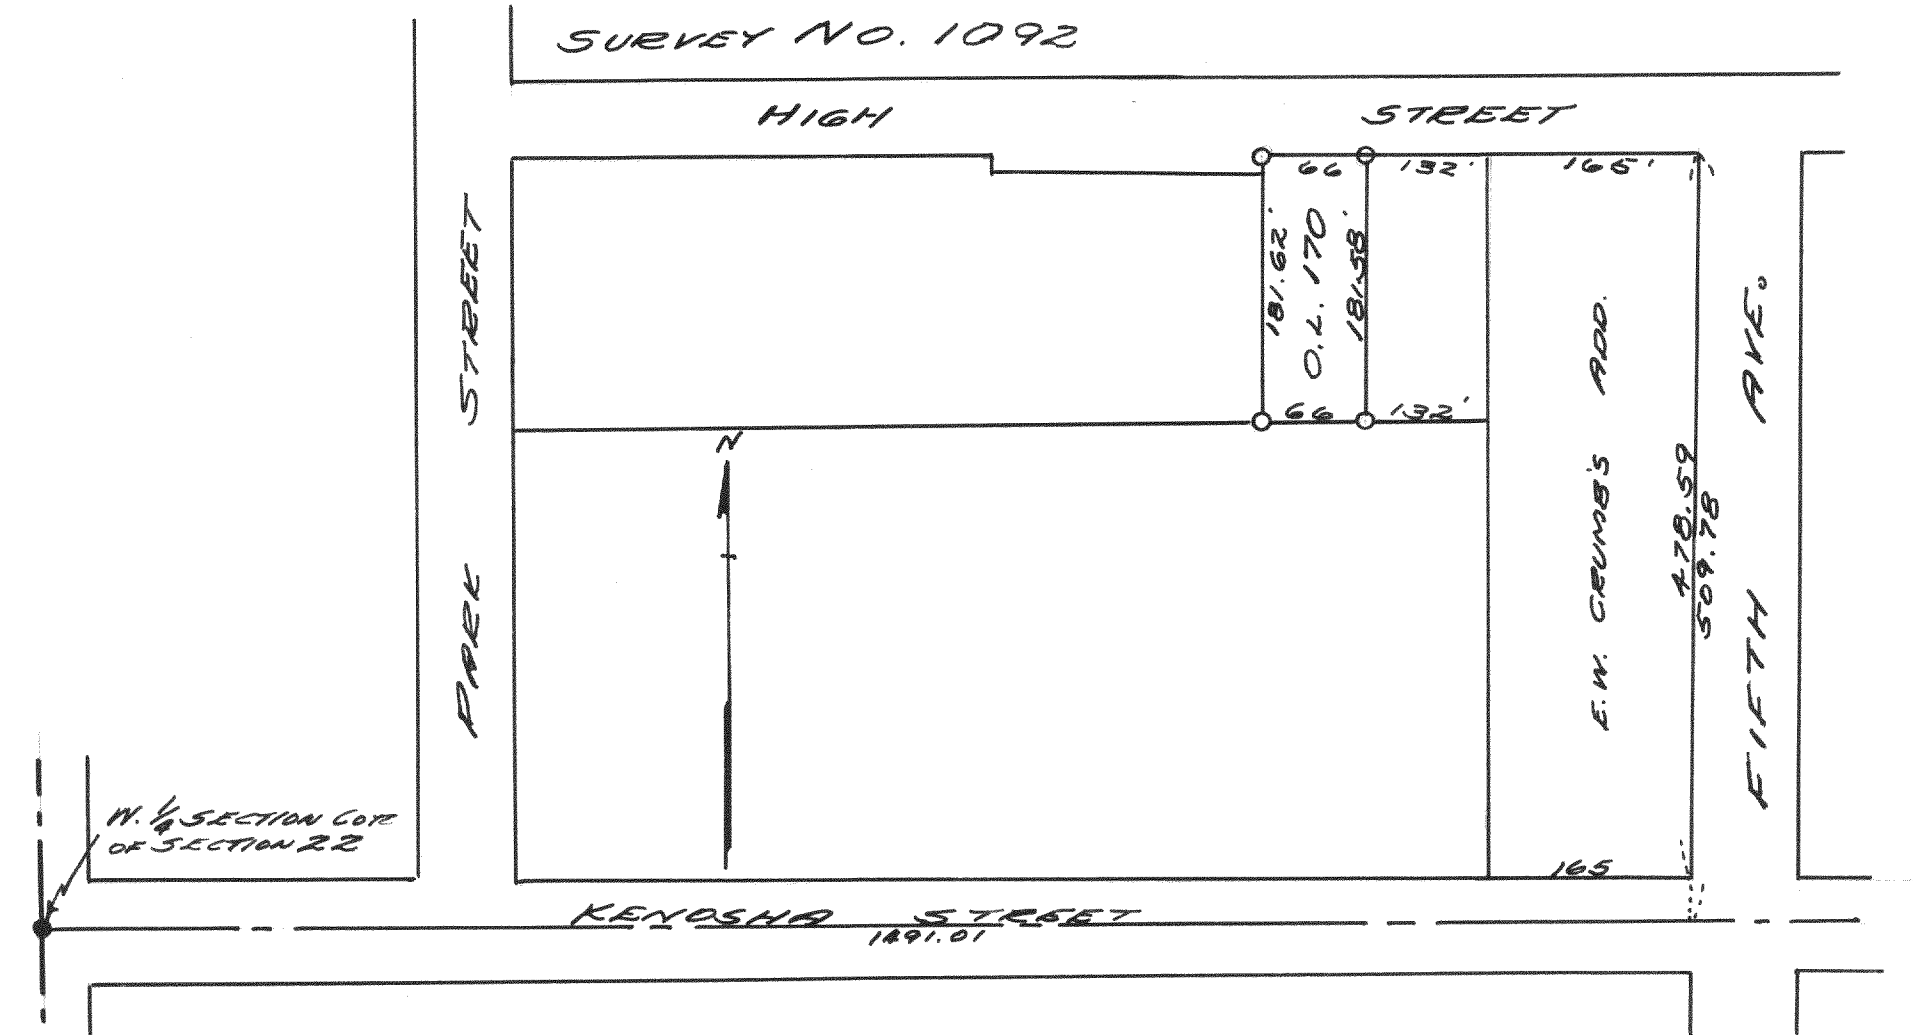

PLAT OF SURVEY OF OUTLOT 170 OF THE VILLAGE OF  
WALWORTH, WALWORTH COUNTY, WISCONSIN  
OCTOBER, 1940

Lloyd L. Jensen  
H.E.S.

SURVEY NO. 1093

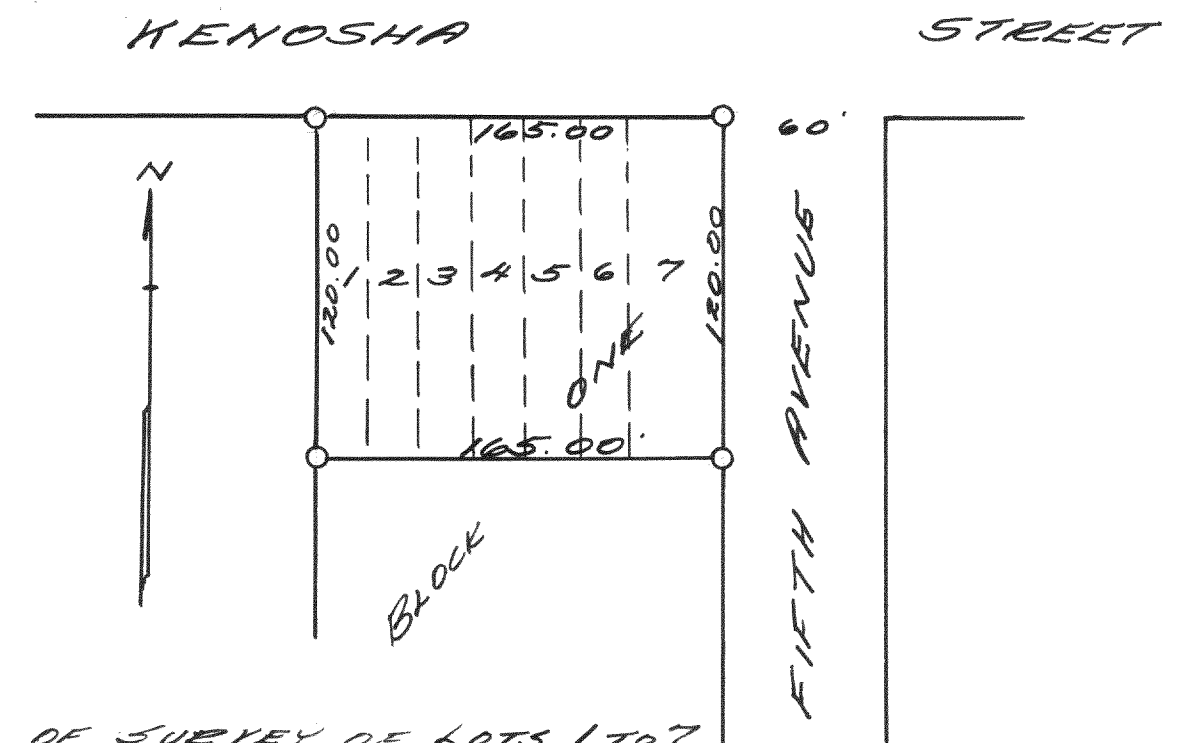

PLAT OF SURVEY OF LOTS 1 TO 7  
OF BLOCK ONE, OF THE EAST  
SIDE ADDITION TO THE VILLAGE  
OF WALWORTH, WALWORTH CO. WISC.  
AUGUST 14, 1940

Lloyd L. Jensen  
H.E.S.