


Record of Survey.

DESCRIPTION

Township..... North of Range..... of 4 Principal Meridian
 as presented by the courses and distances on the following plat, and annexed field-notes of survey:
 Established the center of the section at the point of intersection of STRAIGHT quarter lines.
 Established all quarter-quarter corners upon the section boundary at proportional distances between known section and quarter section corners, according to the original field-notes of the Government survey.
 Established all lost corners at proportionate distances between known corners, according to the original field notes of the Government survey.

OF SECTION, QUARTER SECTION AND QUARTER QUARTER SECTION CORNERS

No. 628

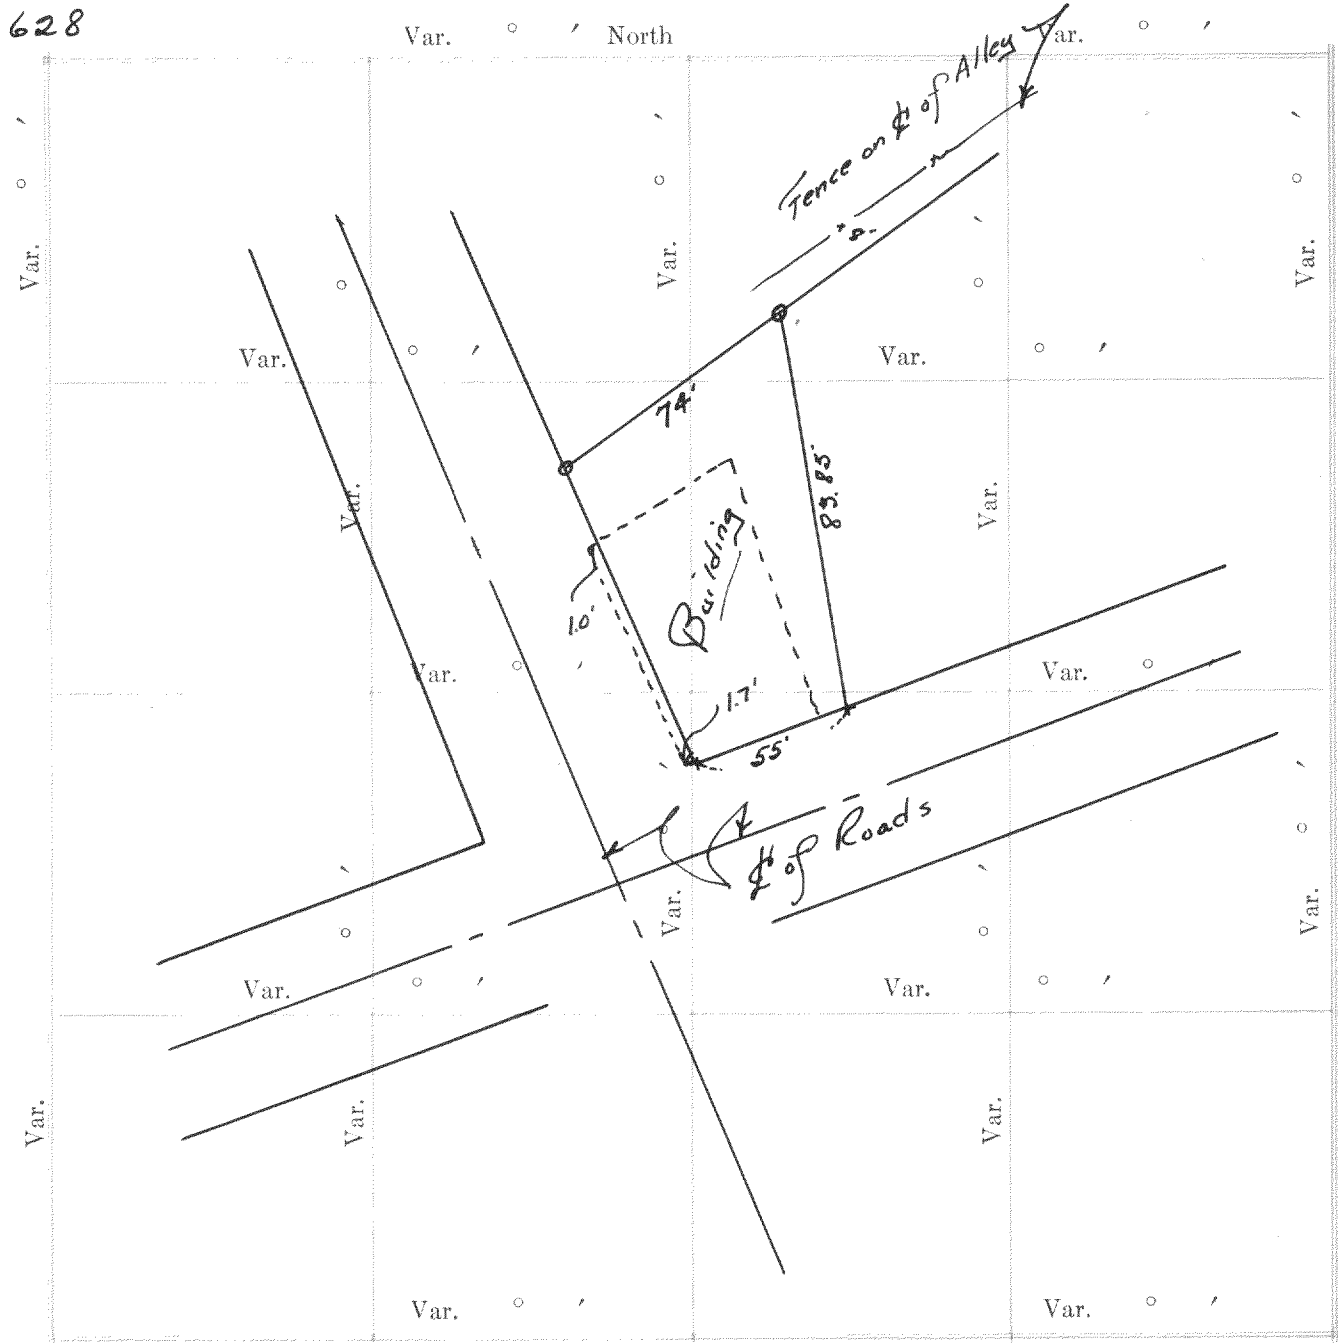

Plat of Section..... Township..... North, Range..... of 4 Principal Meridian Scale
 80 chains to 6 inches. The figures in red ink are the lengths of the lines as stated in the field-notes of the
 Government survey.

Declination of the Magnetic Meridian from the True Meridian.....
 Surveyed and sub-divided..... A. D. 1..... in accordance
 with the State Laws and Instructions of the Commissioner of the General Land office, and recorded on pages
 of Register in the County Clerk's office.

Witness my hand this..... day of..... A. D. 1.....
 SURVEYOR.

No.	GOVERNMENT CORNERS				H. C. MILLER CO. MFG. STATIONERS, MILWAUKEE, WIS. 15000				SUBDIVISION CORNERS			
	Bearing Trees	In. Dia.	Courses they bear	Links Distant	Bearing Trees	In. Dia.	Courses they bear	Links Distant	Bearing Trees	In. Dia.	Courses they bear	Links Distant

- No.
 1. N. W. Sec. Cor. identified,
 2. N. E. Sec. Cor. identified,
 3. S. E. Sec. Cor. identified,
 4. S. W. Sec. Cor. identified,
 5. N. 1/4 Sec. Cor. identified,
 6. E. 1/4 Sec. Cor. identified,
 7. S. 1/4 Sec. Cor. identified,
 8. W. 1/4 Sec. Cor. identified,
 Subdivision Corners
 No.
 1. Center 1/4 Sec. Cor.
 2. North 1/4-1/4 S. N. W. qr.,
 3. East 1/4-1/4 S. N. W. qr.,
 4. South 1/4-1/4 S. N. W. qr.,
 5. West 1/4-1/4 S. N. W. qr.,
 6. Center 1/4-1/4 S. N. W. qr.,
 7. North 1/4-1/4 S. N. E. qr.,
 8. East 1/4-1/4 S. N. E. qr.,
 9. South 1/4-1/4 S. N. E. qr.,
 10. Center 1/4-1/4 S. N. E. qr.,
 11. East 1/4-1/4 S. S. E. qr.,
 12. South 1/4-1/4 S. S. E. qr.,
 13. West 1/4-1/4 S. S. E. qr.,
 14. Center 1/4-1/4 S. S. E. qr.,
 15. South 1/4-1/4 S. S. W. qr.,
 16. West 1/4-1/4 S. S. W. qr.,
 17. Center 1/4-1/4 S. S. W. qr.

*Survey of lot 7 and part of lot 8 of Block 21
 of Frey's Add. to Parisien.
 o - iron stake
 + - cross cut in the concrete
 The building was found to be over onto the street
 a small amount on the West side.
 Feb. 27, 1935
 Floyd V. Jensen
 Co. Sur.*

NAMES OF SWORN ASSISTANTS

CHAINMEN

FLAGMEN

AXMEN

206

No. 629

This was a survey for O. Stenson on the parcel surveyed in No. 627 to determine the elevation of several points on the land.

March 28, 1935


Lloyd S. Jensen
Co. Surveyors.

No. 632

Lot 125 of Lake Melavan Highlands

No. 630


- o - Pipes found
- - Pipes placed

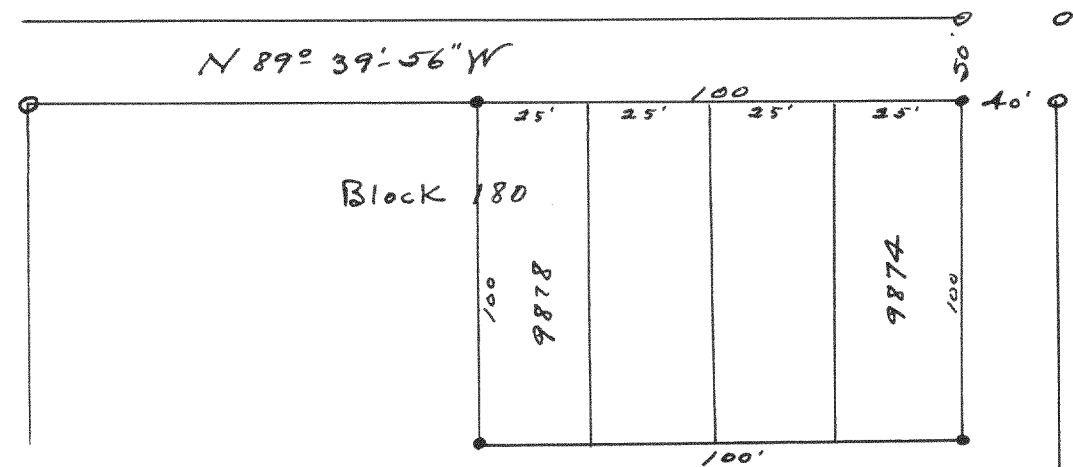

Survey of lots 9874-9878 for Albert Davis in the 5th map of Lake Como Beach.

March 29, 1935

Lloyd S. Jensen
Co. Surveyors.

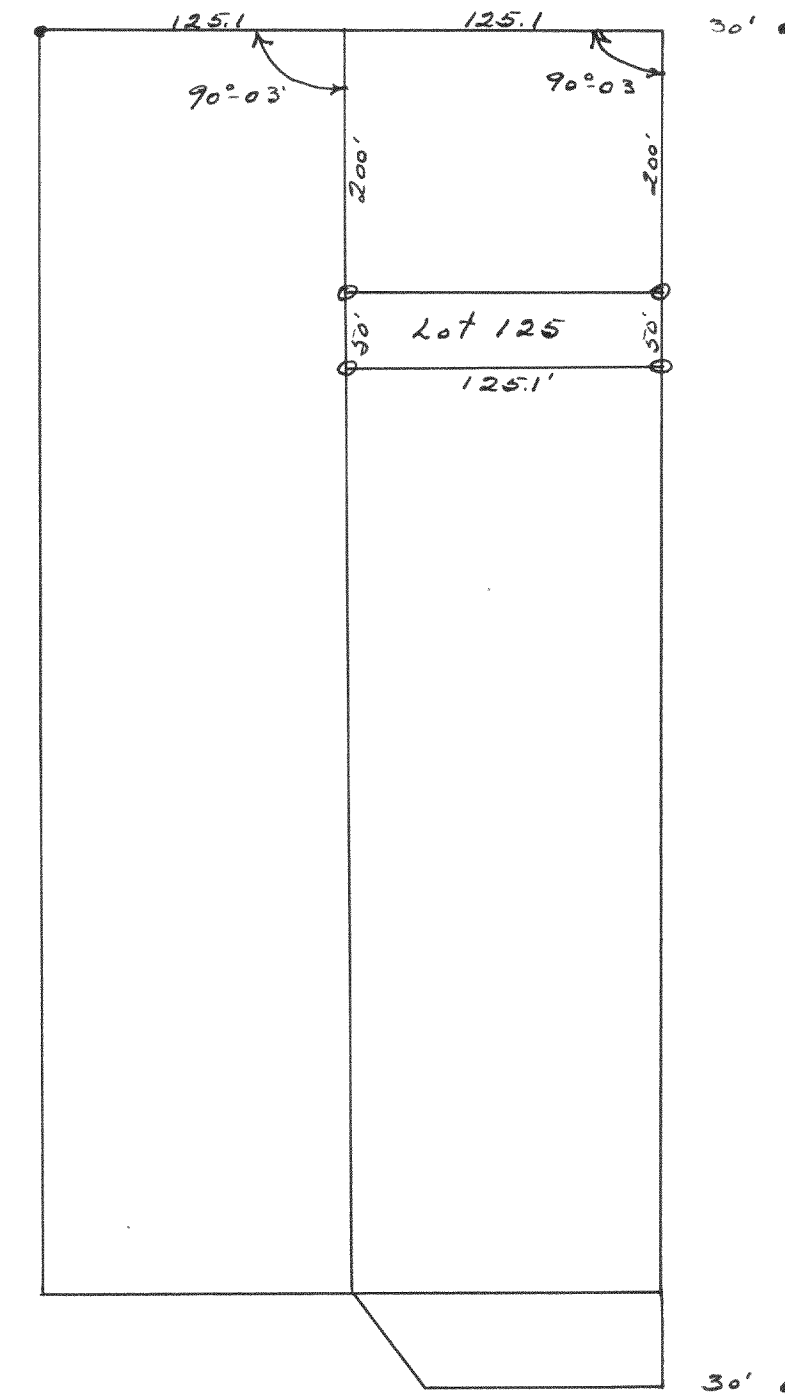


- - Wood stake found.
- o - drum stake placed

April 17, 1935

Lloyd S. Jensen
Co. Surveyors.

No. 631

Sec. 4-2-15

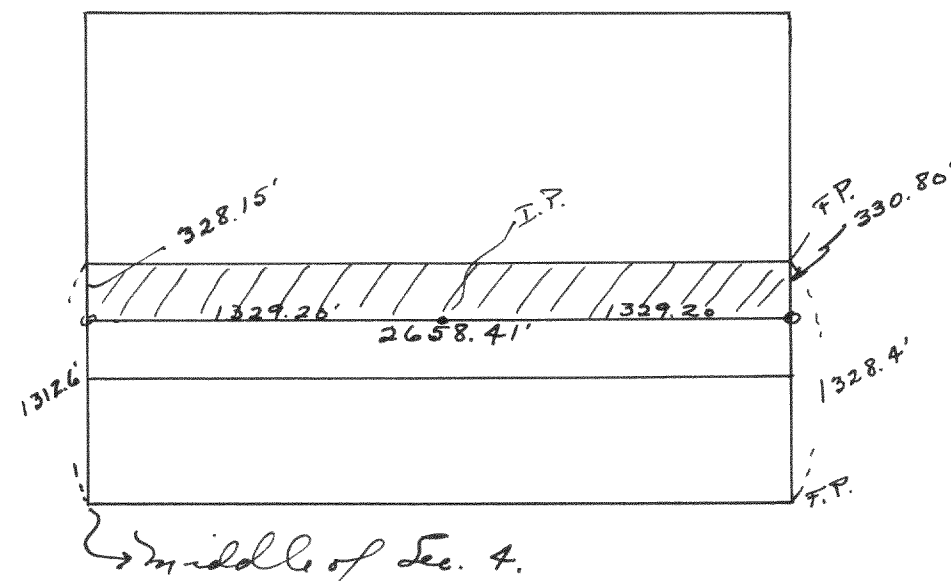

Fence line survey of the $\frac{1}{2} \cdot \frac{1}{2}$ of $S\frac{1}{2}$ of $NE\frac{1}{4}$ of 4-2-15 for Arthur Stewart.

April 1935

Lloyd S. Jensen
Co. Surveyors