## Record of Survey.

presented by the cours							
	er of the section at the er-quarter corners upor					hatween 1	kne
etion and quarter section							15.2.3 (.
Established all lost of	corners at proportionat	e distances betwe	en known eor	ners, acc	cording to t	he origina	1 fi
otes of the Government	survey.			2 .	40		
0.687	Survey of	Lot 11, -	Block	e G	ofa	een	
0.687 3 Park Du	Rl val	P. Softh.	5. 8.	/	VIII P	1011	
yarve and				7 % (4			
	ot with the property of the state of the sta	white the state of		de montante de l'includ			^
		O		REPLANTAGE AND TAKES			0
	A (Consociality) of	, , , , , , , , , , , , , , , , , , ,		•			
Var.	O Tradesia	Var.	1	0			¥
Var.	O /		Val				
The control of the co				ter same and a surrey construe		j.,	Automore
if well my Keepland (in the control of the control		4	3	2	-		
	Var.			ar.			
Charles and Annual Contracts		30		30'	B		POENNANA.
	A 30 30	9 30'					
	Var.	,		and the second second	var. °	,	
					and an exercise of the second	, ,	
	10 3	12					•
		Ü					C
		enapapanananinan 6 -					
	d	Var		0			£ 3
Var.	0,	<b>6</b>	Var		0 /		
						to a state and the foliate the field to be the first the first terminal	~rc-cameran
<b>.</b>	ş						
V al.	Var			Var			
	THE STATE OF THE S						
				endergraftsprachuse			
	Var.	,		an control	Var.	,	
	a a mille management of the same see see see see		gol <sub>aran ya</sub> aragan a argan ya gama golara (ili, a a asandi	aniji i i i i i i i i i i i i i i i i i i	nturrangi surpusus si surpugisti di Silini tetah di		
Plat of Section	Township	North,	Range	oi	4 Principal	l Meridian	S

	Declination of the Magnetic Meridian from the True Meridian.				*1		
	Surveyed and sub-divided		A. ]	D. 1	, in a	ccordan	c€
ith	the State Laws and Instructions of the Commissioner of the General	Land	office,	and	recorded	on pag	es
	of Register in the County Clerk's office.						
	Witness my hand this day of	A T	) 1				

OF SECTIO	IN,	QUA	.17.1.	ck sc	CLIOI	N WIN	D	SONKI	EK	QUAR	LEF	SEC	LION	CORN	IEK	5	
de proprieta de proprieta de la compansión de proprieta de proprieta de la compansión de la	- 87	a r										н, с	MILLER CO	: MFG, STATI	ONERS,	MILWAUKEE	X15000
GOVERNMENT CORNERS		Bearing Trees	In. Dia.	Courses they bear	Links Distant	Bearing Trees	In. Dia,	Courses they bear	Links Distant	Bearing Trees	In. Dia.	Courses they bear	Links Distant	Bearing Trees	In. Dia.	Courses they bear	Links Distant

- 1. N. W. Sec. Cor. indentified,
- 2. N. E. Sec. Cor. indentified,
- 3. S. E. Sec. Cor. indentified,
- 4. S. W. Sec. Cor. indentified,
- 5. N. 1/4 Sec. Cor. indentified,
- 6. E. 1/4 Sec. Cor. indentified,

## Subdivision Corners

- 1. Center ¼ Sec. Cor.
- 2. North 1/4-1/4s N. W. qr.,
- 3. East ¼-¼s N. W. qr.,
- 4. South ¼-¼s N. W. qr.,
- 5. West ¼-¼s N. W. qr.,
- 6. Center ¼-¼s N. W. qr.,
- 7. North ¼-¼s N. E. qr.,
- 8. East 1/4-1/48 N. E. qr.,
- 9. South 1/4-1/4s N. E. qr.,
- 10. Center ¼-¼s N. E. qr.,
- 11. East ¼-¼s S. E. qr.,
- 12. South ¼-¼s 8. E. qr.,
- 13. West ¼-¼s S. E. qr.,
- 14. Center ¼-¼s S. E. qr.,
- 15. South ¼-¼s S. W. qr.,
- 16. West ¼-¼s S. W. qr.,
- 17. Center 1/4-1/4s S. W. qr.

..Surveyor.


CHAINMEN

at The corner of the 4-lats.	V
If The corner of the 4-lats.  B''-lun pipe at corner he tween lats 142.	
Placed iron pipes at The corners of lat 11, de Letween point 174B checks with the destar given in the Plat.	? Lave
given in the Plat.	
Survey for mr. Ulban, 2021 Fullin Stre Chicago, All.	e

NAMES OF SWORN ASSISTANTS

AXMEN

FLAGMEN

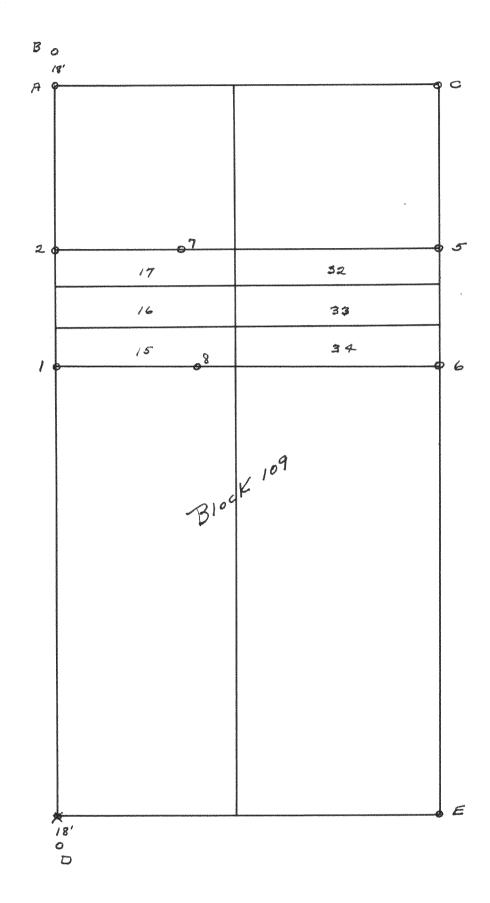

Survey of Black 109 of take Wandawega Subd. Family iron pripes at a, B, C, D & E. Placed iron pripes at 1, 2, 5, 6, 748. Stakes at 748 were placed at the crest of the hilf. Distances from 2-7 and 1-8 were not measured.

may 11, 1935

Hoya V. Jensen Courty Suveyor