


Record of Survey.

No. 756

Township....., North of Range..... of 4 Principal Meridian as presented by the courses and distances on the following plat, and annexed field-notes of survey:

- Established the center of the section at the point of intersection of STRAIGHT quarter lines.
- Established all quarter-quarter corners upon the section boundary at proportional distances between known section and quarter section corners, according to the original field-notes of the Government survey.
- Established all lost corners at proportionate distances between known corners, according to the original field notes of the Government survey.

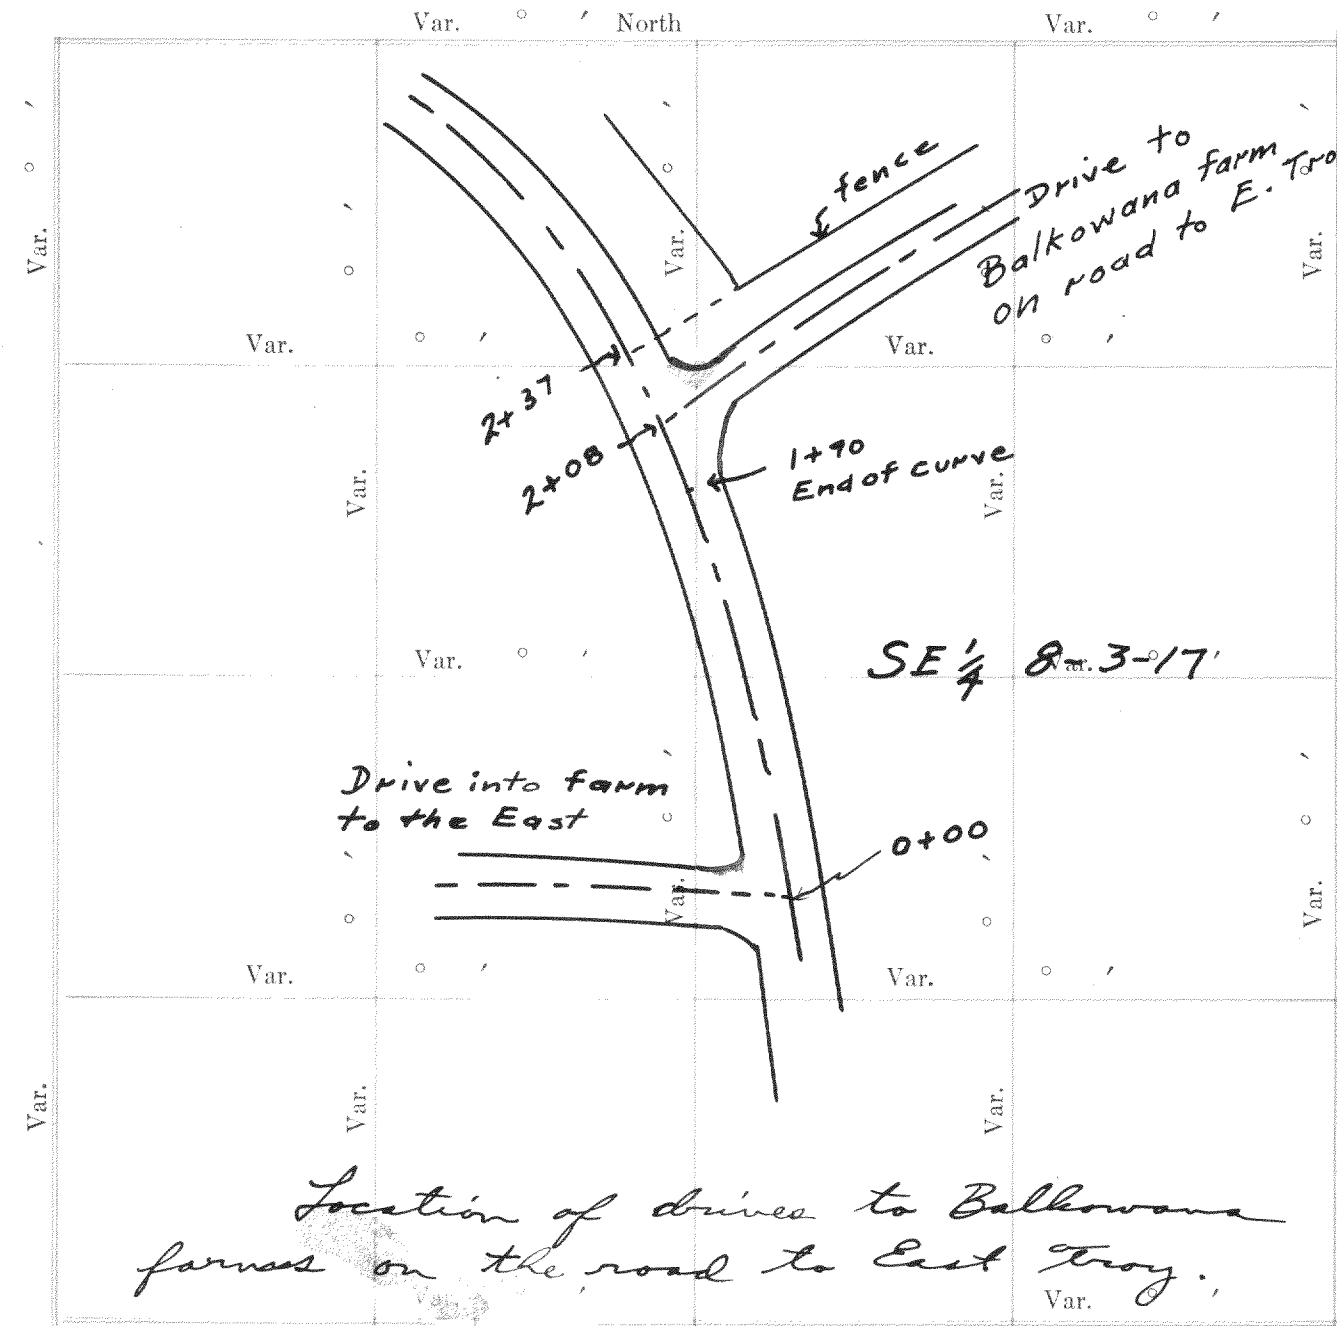

Plat of Section....., Township..... North, Range..... of 4 Principal Meridian Scale 80 chains to 6 inches. The figures in red ink are the lengths of the lines as stated in the field notes of the Government survey.

Declination of the Magnetic Meridian from the True Meridian.....
 Surveyed and sub-divided..... A. D. 1....., in accordance with the State Laws and Instructions of the Commissioner of the General Land office, and recorded on pages..... of Register in the County Clerk's office.

Witness my hand this..... day of..... A. D. 1.....
 SURVEYOR.

Lloyd L. Jensen
 County Surveyor
 By *W. E. H.*

DESCRIPTION


241

OF SECTION, QUARTER SECTION AND QUARTER QUARTER SECTION CORNERS

| GOVERNMENT CORNERS | | | | M. C. MILLER CO. MFG. STATIONERS. MILWAUKEE WISCONSIN | | | | | | | |
|--------------------|-----|-----------|---------|---|-----|-----------|---------|---------|-----|-----------|---------|
| Bearing | In. | Courses | Links | Bearing | In. | Courses | Links | Bearing | In. | Courses | Links |
| Trees | Di. | they bear | Distant | Trees | Di. | they bear | Distant | Trees | Di. | they bear | Distant |

No. 757

- No.
- N. W. Sec. Cor. identified,
 - N. E. Sec. Cor. identified,
 - S. E. Sec. Cor. identified,
 - S. W. Sec. Cor. identified,
 - N. 1/4 Sec. Cor. identified,
 - E. 1/4 Sec. Cor. identified,
 - S. 1/4 Sec. Cor. identified,
 - W. 1/4 Sec. Cor. identified,
- Subdivision Corners
- No.
- Center 1/4 Sec. Cor.
 - North 1/4-1/4s N. W. qr.,
 - East 1/4-1/4s N. W. qr.,
 - South 1/4-1/4s N. W. qr.,
 - West 1/4-1/4s N. W. qr.,
 - Center 1/4-1/4s N. W. qr.,
 - North 1/4-1/4s N. E. qr.,
 - East 1/4-1/4s N. E. qr.,
 - South 1/4-1/4s N. E. qr.,
 - Center 1/4-1/4s N. E. qr.,
 - East 1/4-1/4s S. E. qr.,
 - South 1/4-1/4s S. E. qr.,
 - West 1/4-1/4s S. E. qr.,
 - Center 1/4-1/4s S. E. qr.,
 - South 1/4-1/4s S. W. qr.,
 - West 1/4-1/4s S. W. qr.,
 - Center 1/4-1/4s S. W. qr.

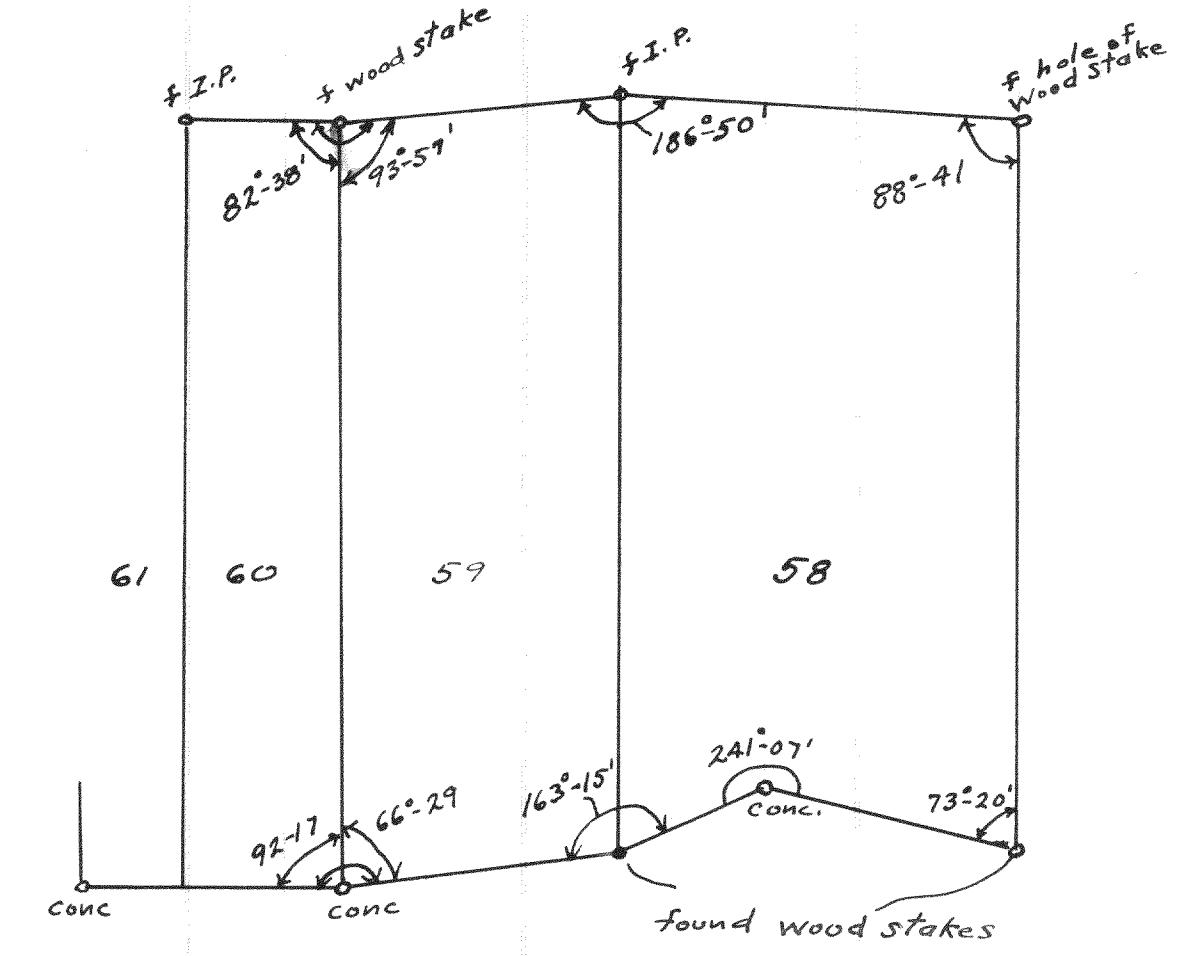



Found lines given in recorded plat.

Survey of Lots 58 & 59 of 1st add to
 Cedar Pt. Park Subd.
 July 9, 1936

Lloyd L. Jensen
 County Surveyor
 By *W. E. H.*


NAMES OF SWORN ASSISTANTS

| CHAINMEN | FLAGMEN | AXMEN |
|----------|---------|-------|
| | | |

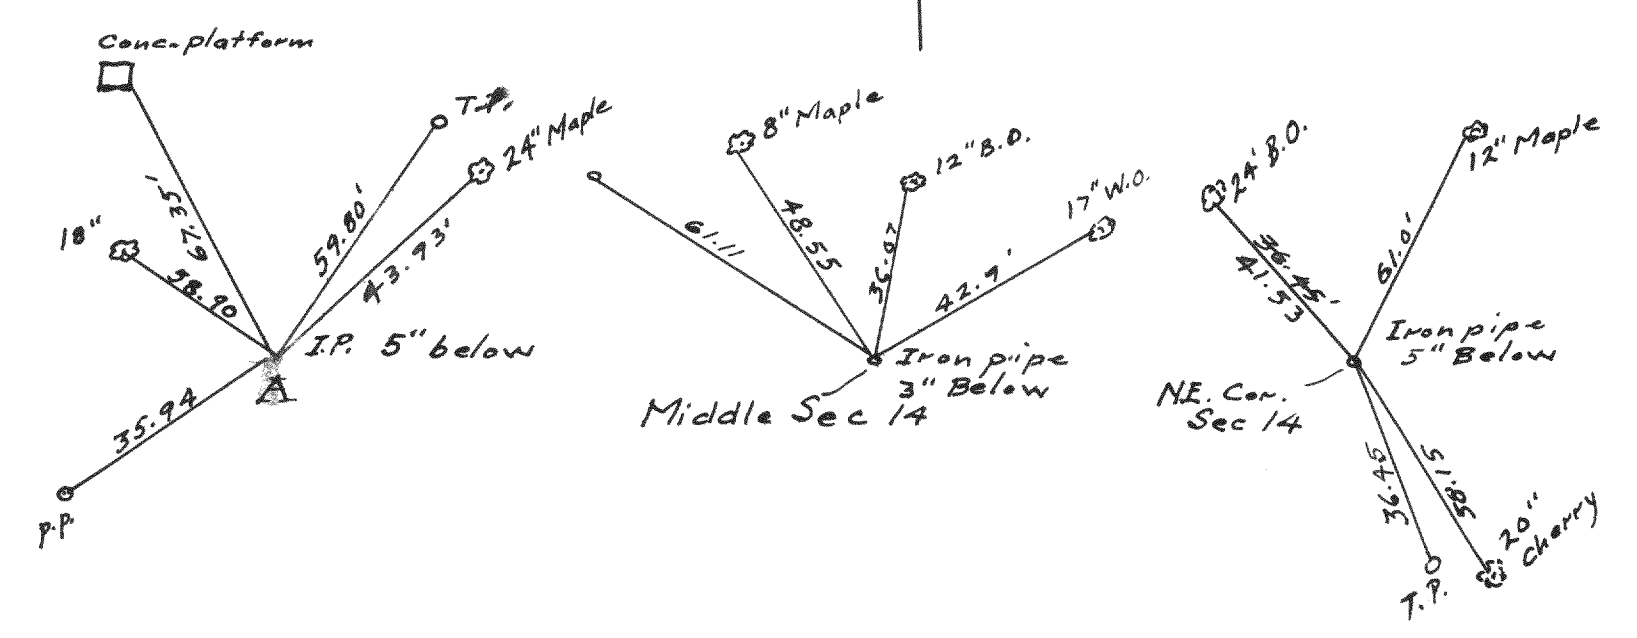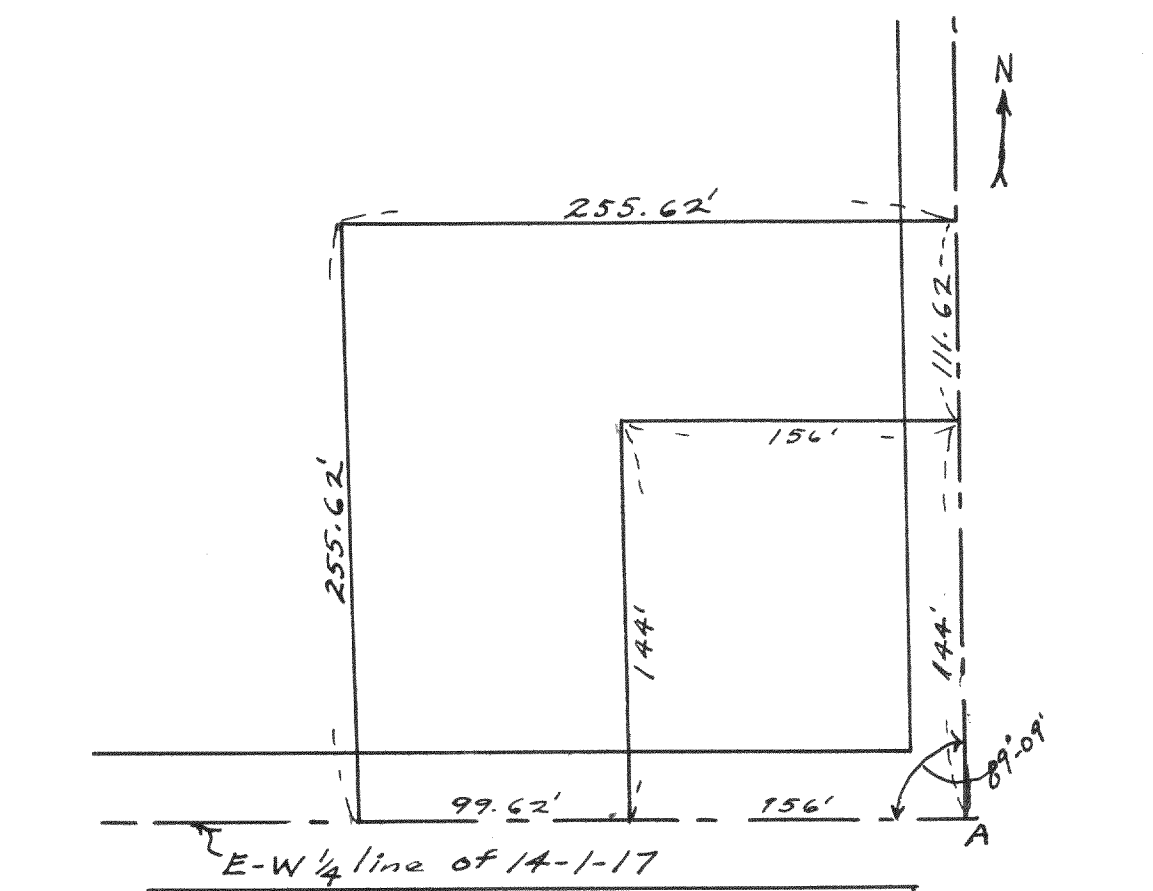

Survey of Faust Grove School District 143

Lloyd L. Jensen
County Surveyor
By W. E. D.

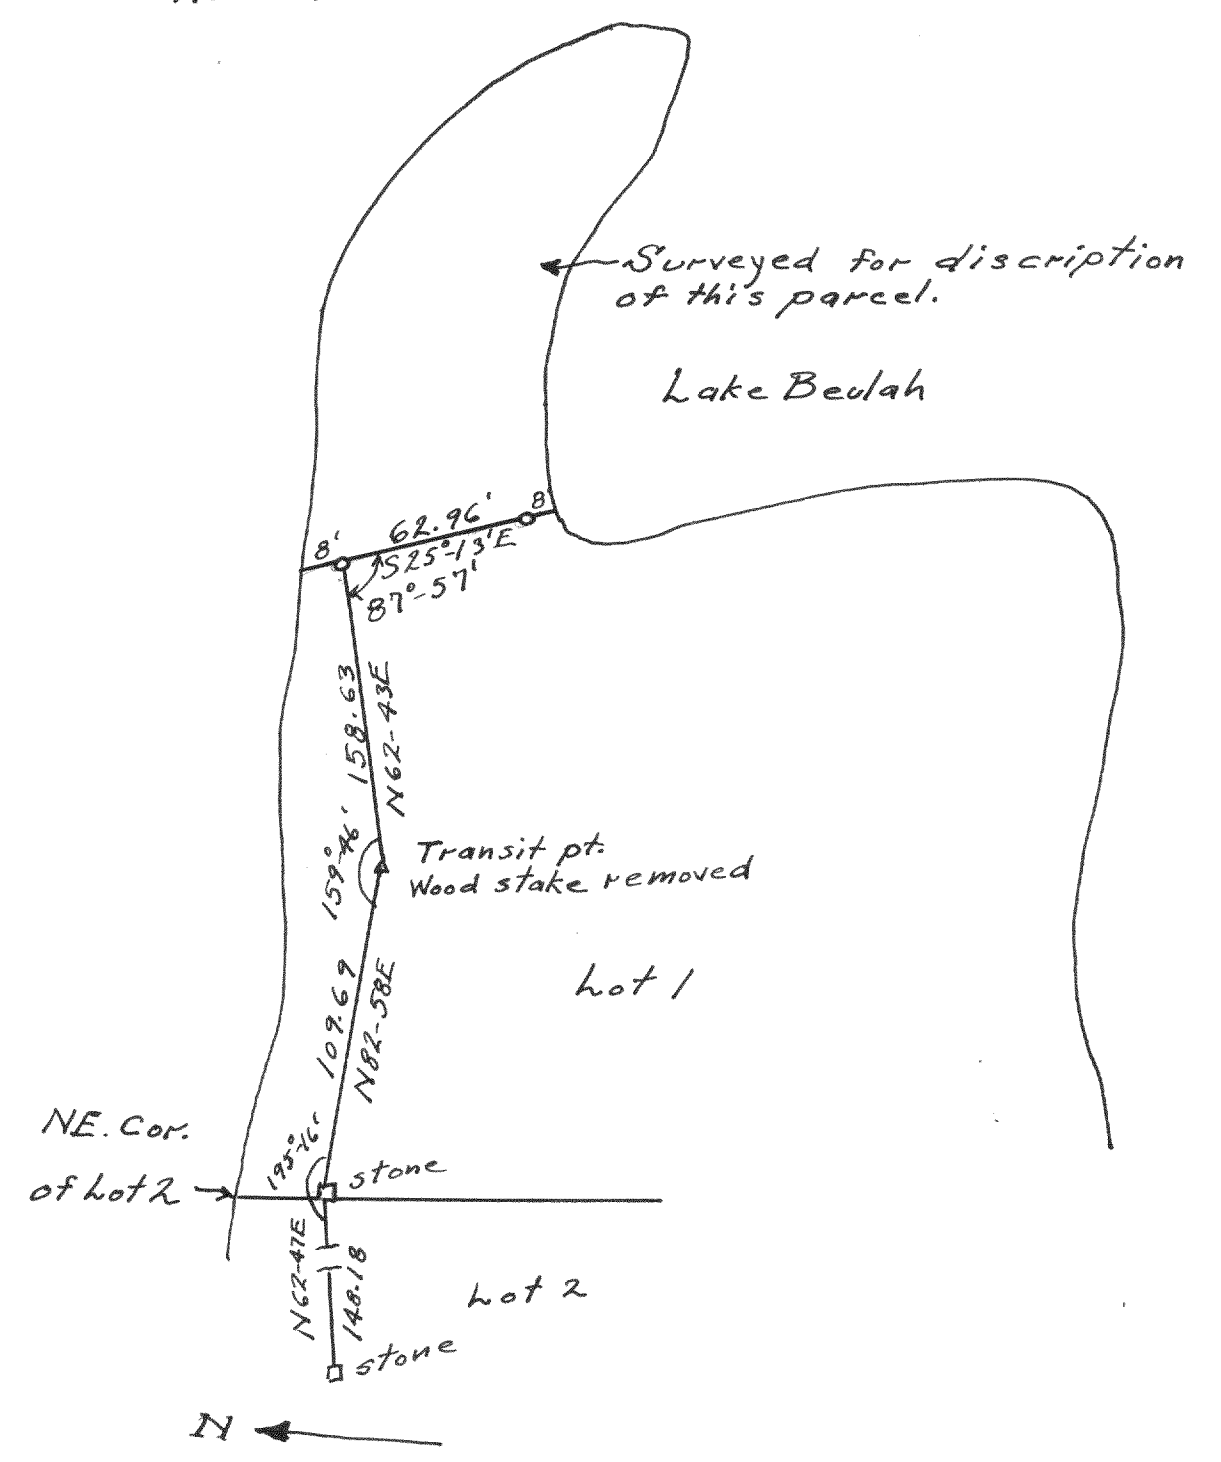

Survey of parcel of Lot 1 of Chamberlains Subd. for S. C. Brown of Milwaukee.
July 18, 1936

Lloyd L. Jensen
County Surveyor
By W. E. D.