


No 881

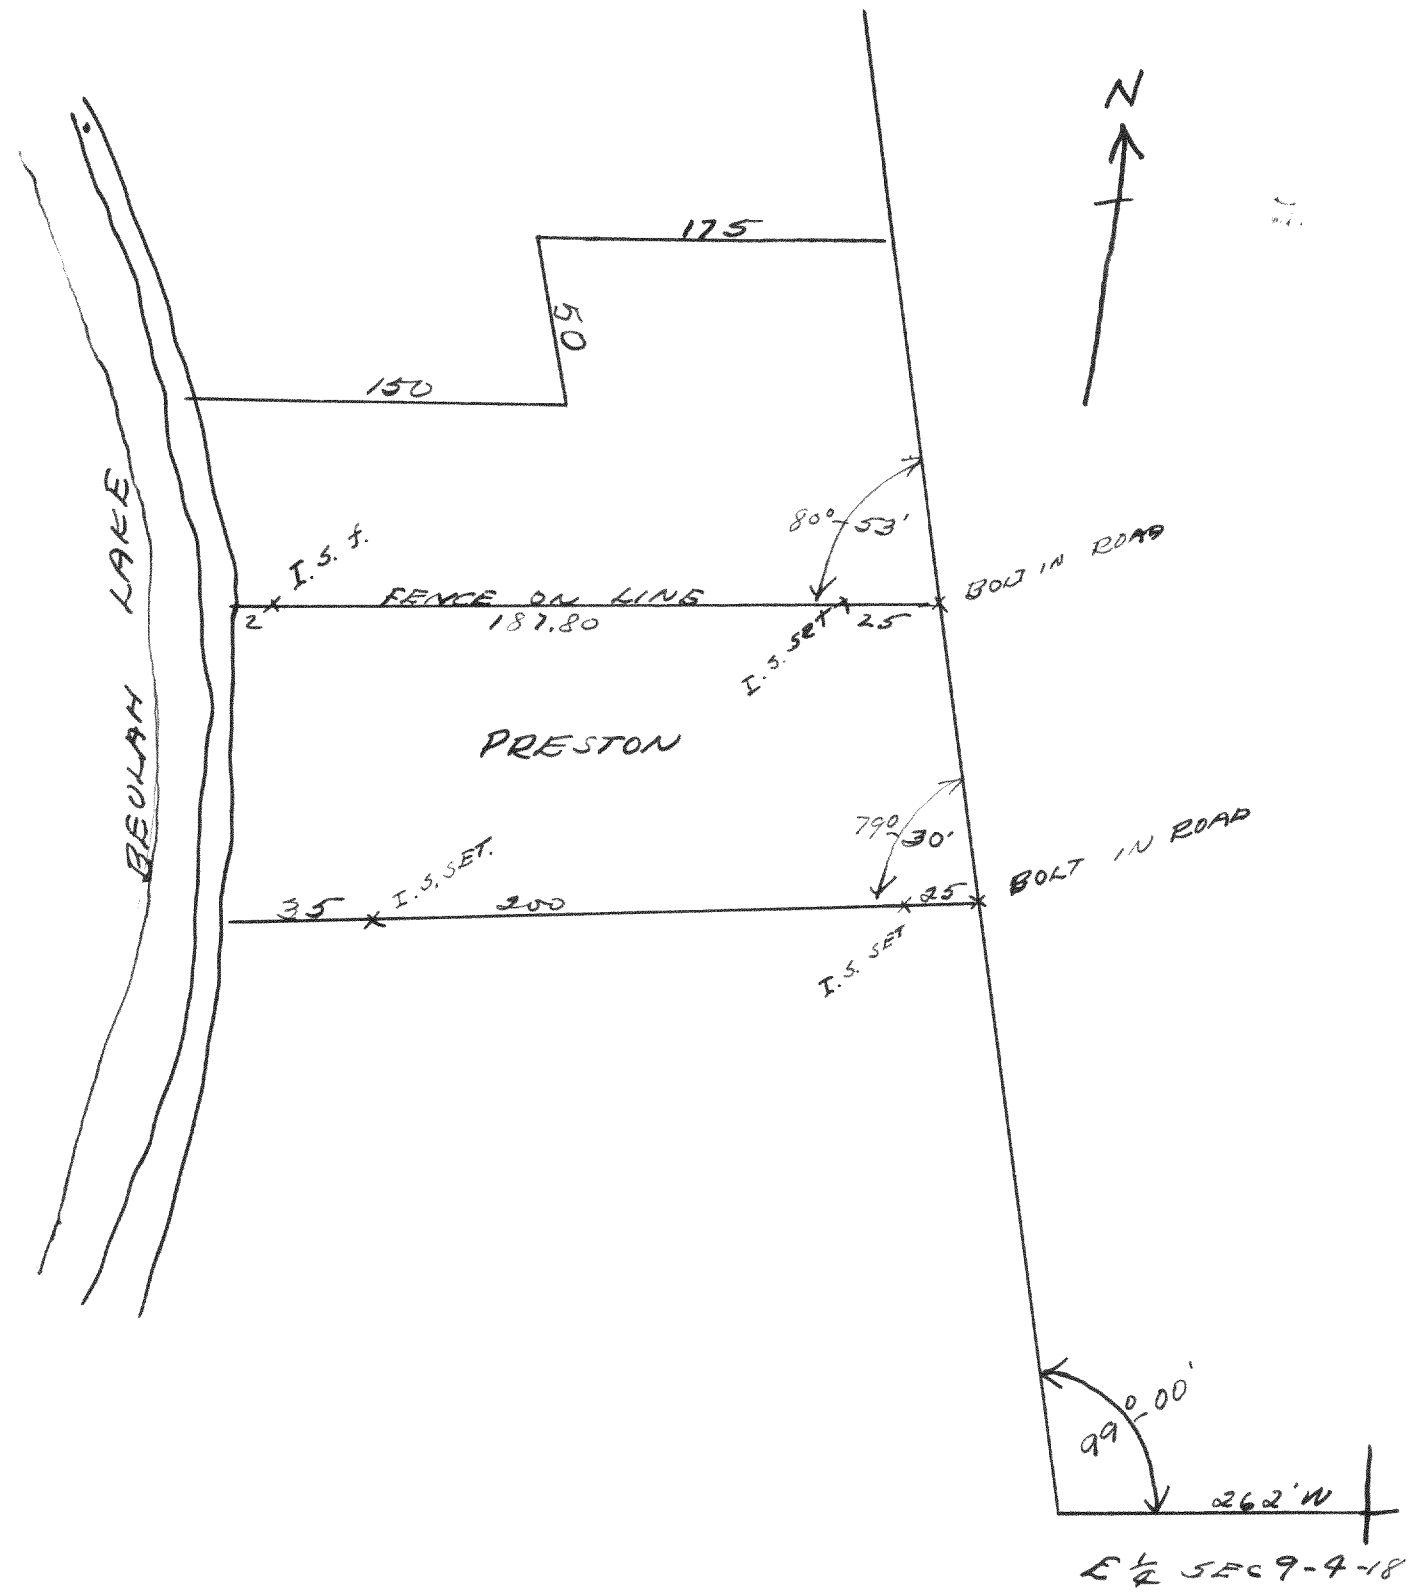


Survey of land in NE 1/4 sec 9-4-18

4-12-38

Lloyd Jensen  
by K.E.J.

No. 882

No. 883

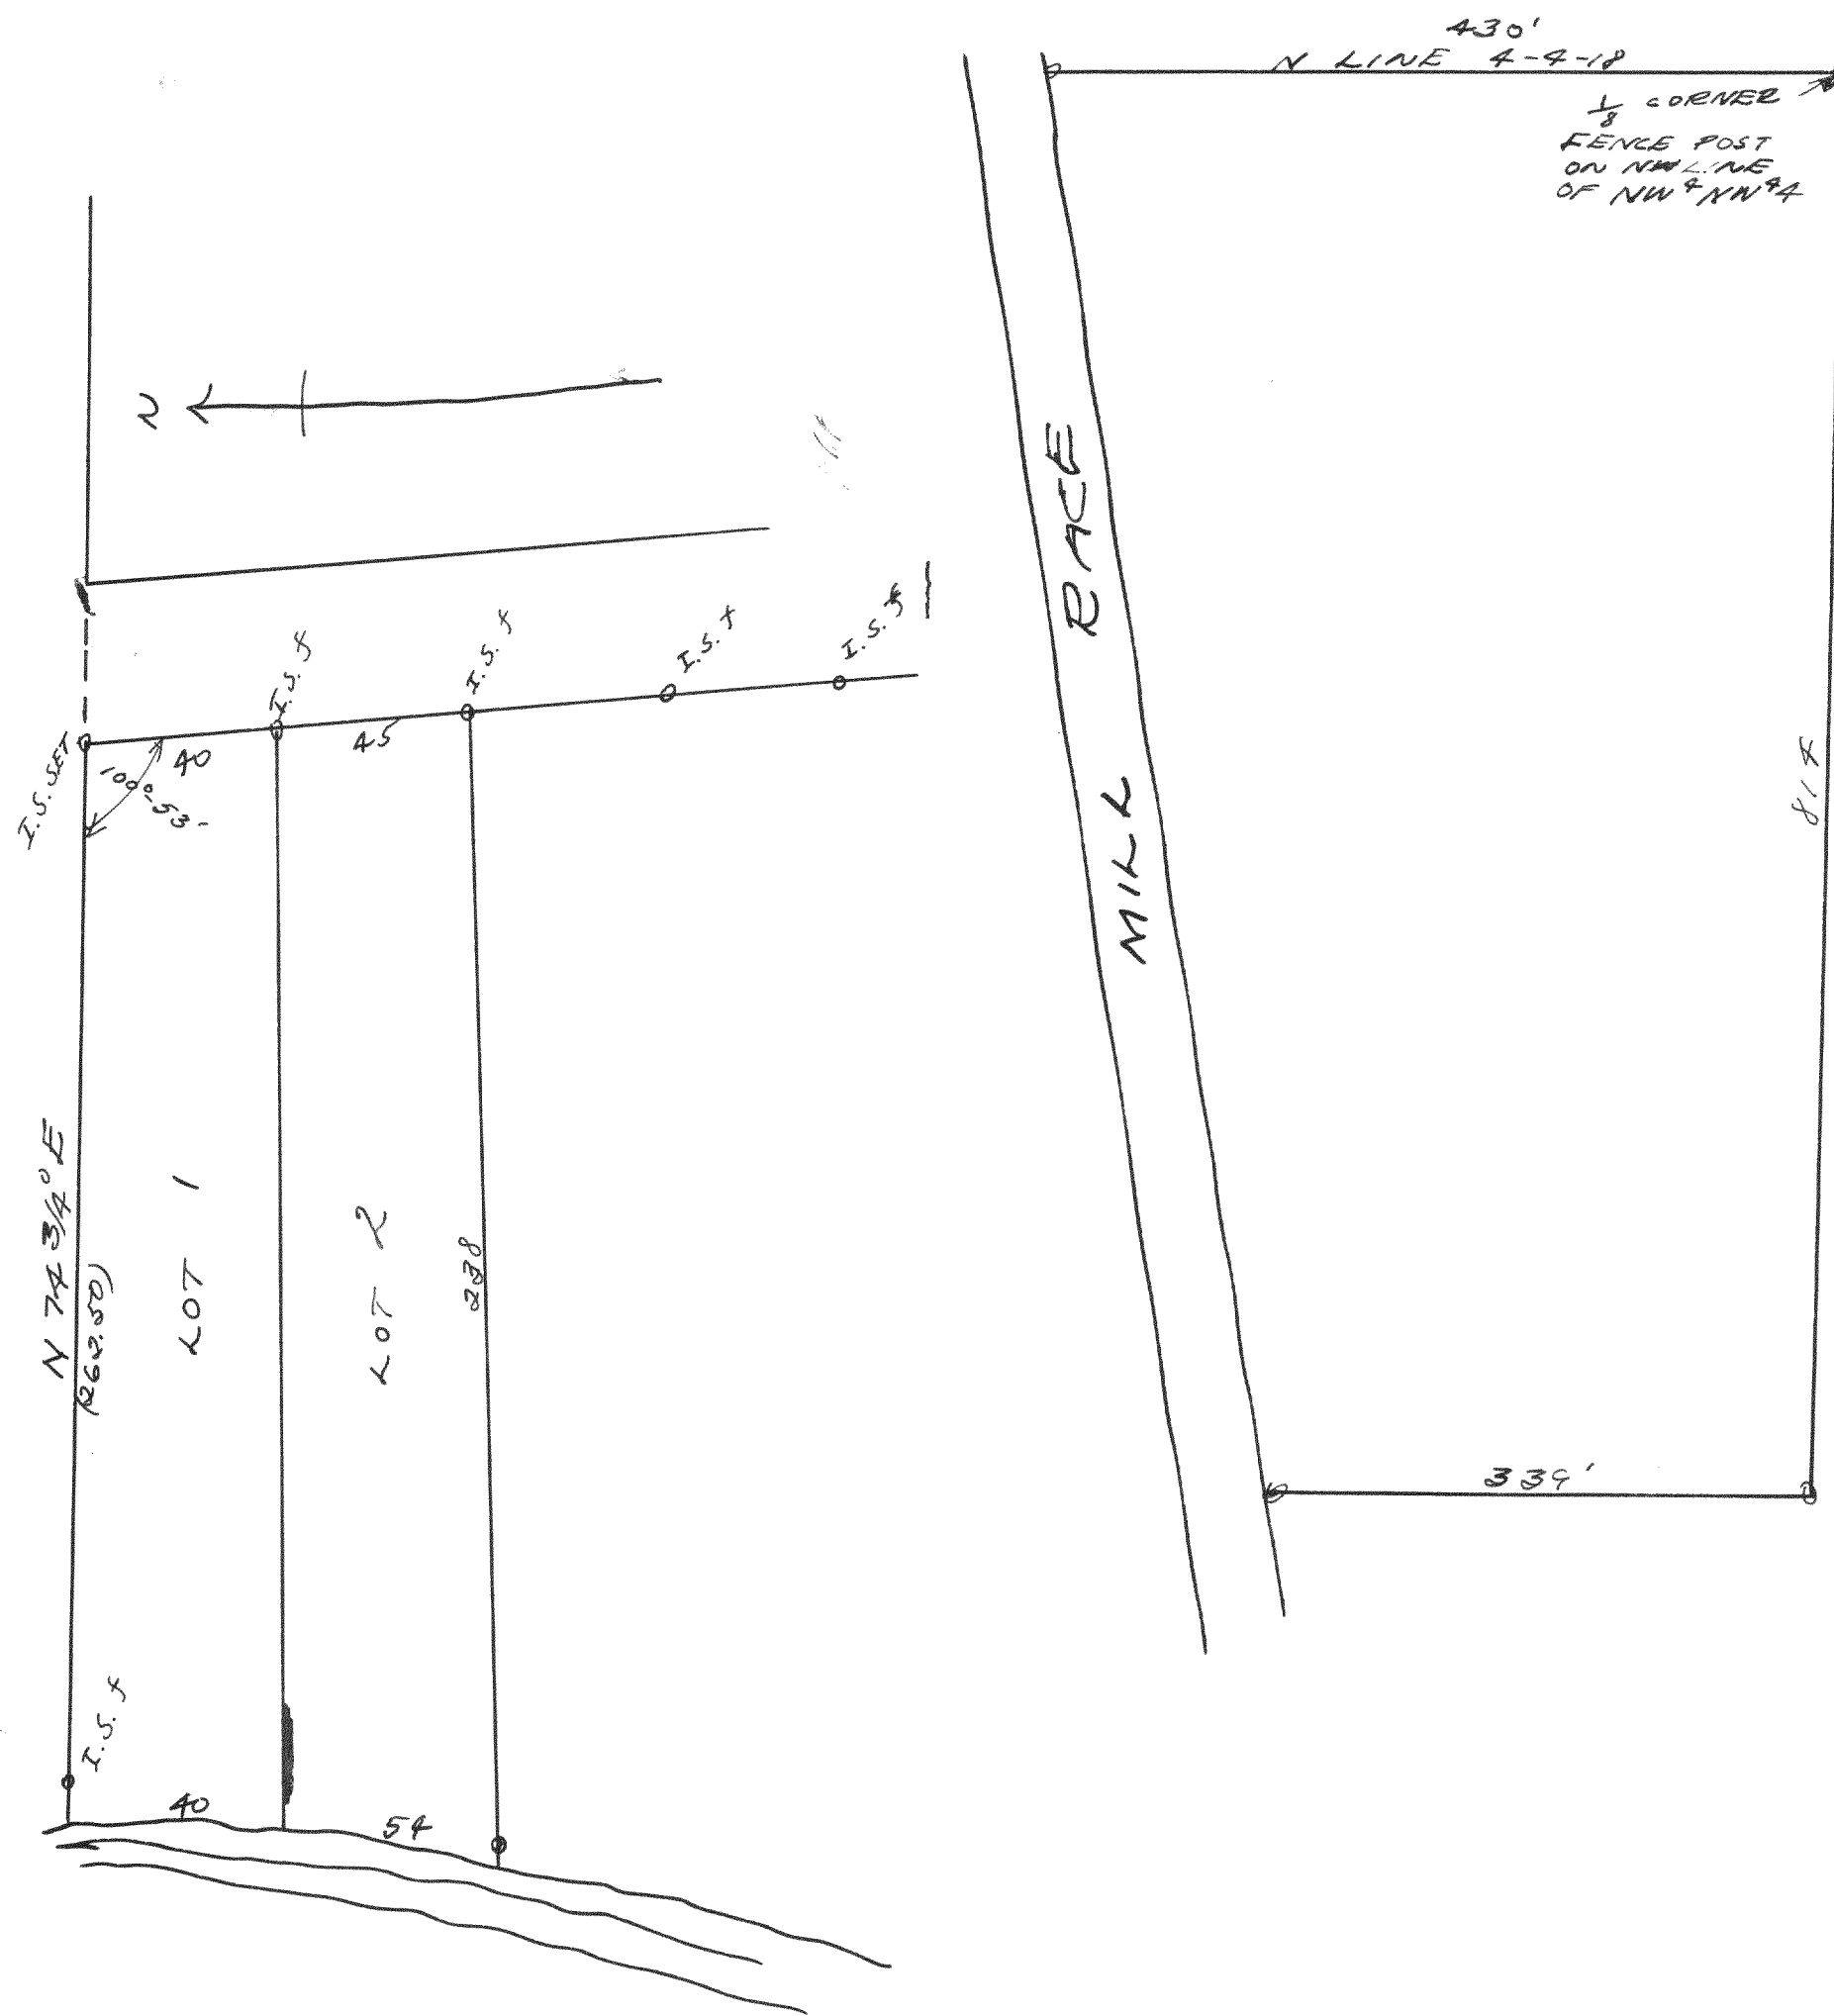

Survey of lots 1 & 2 of subd of lot  
10 Beulah Lake Park T4N R18E

June 1938

Lloyd Jensen by K.E.J.