


No. 887

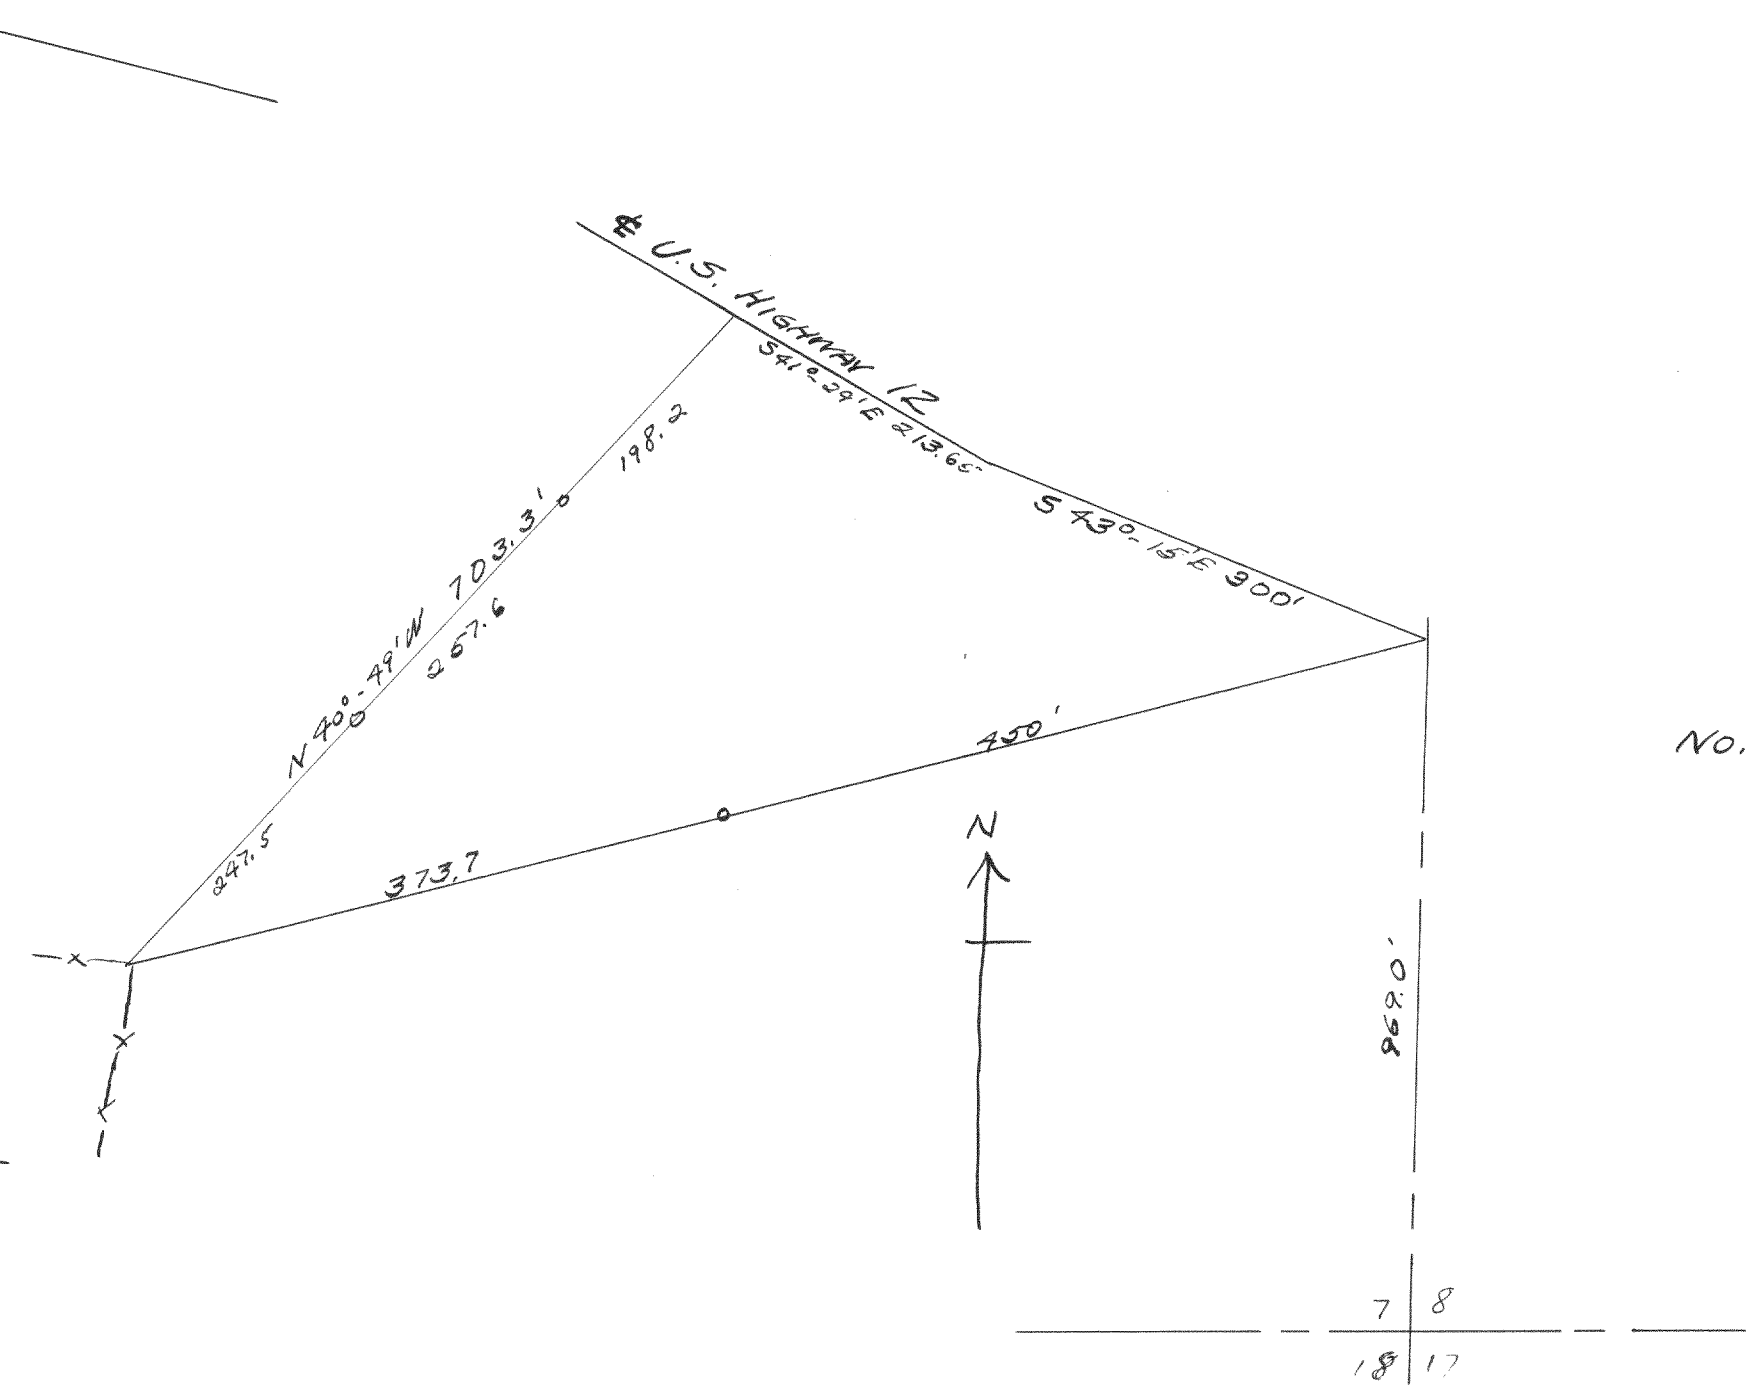


Survey of land in sec. 7-1-18

July 1938

Lloyd L. Jensen  
by H.E.J.


No. 888-

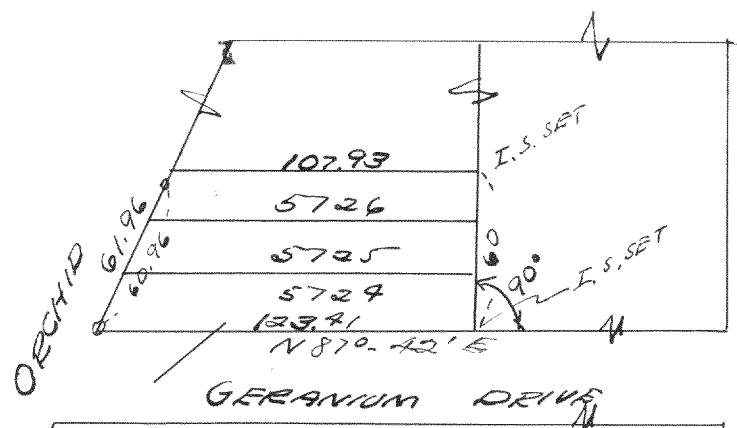

Survey of lots 5724 to 5726  
of Pills Lake -  
April 2, 1938

Lloyd L. Jensen  
by H.E.J.

No. 889

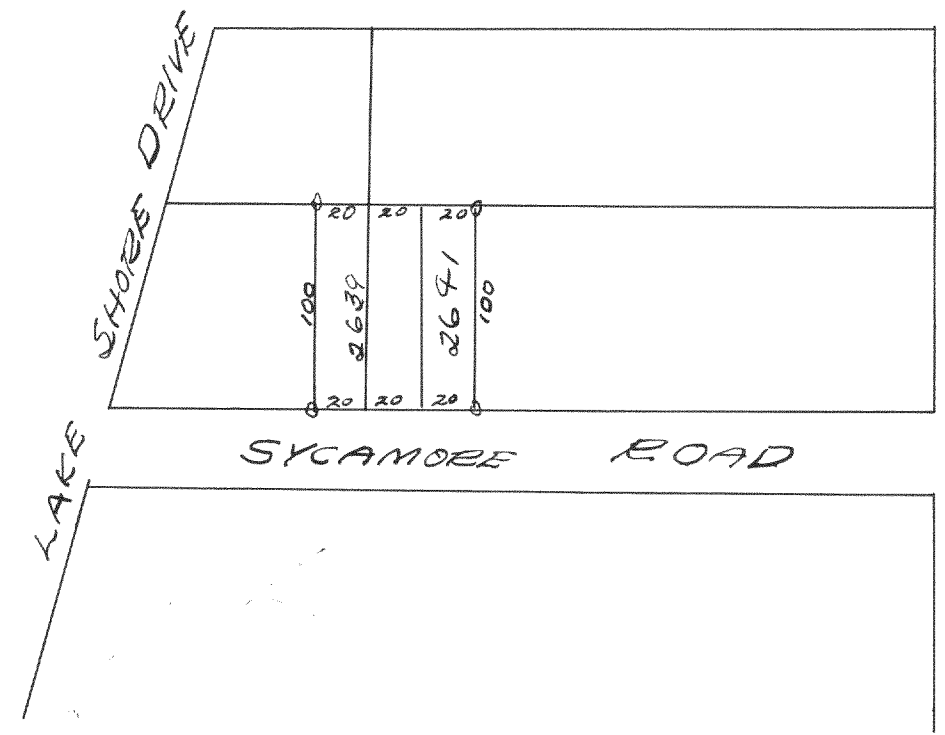

Survey of lots 2639 to 2641 of  
Pills Lake TIN RISE

Aug. 13, 1937

Lloyd L. Jensen  
by H.E.J.

Survey of lots 2556 and 2557  
of Pills Lake - TIN RISE

July 1938

Lloyd L. Jensen  
by H.E.J.