


No. SURVEY No. 950

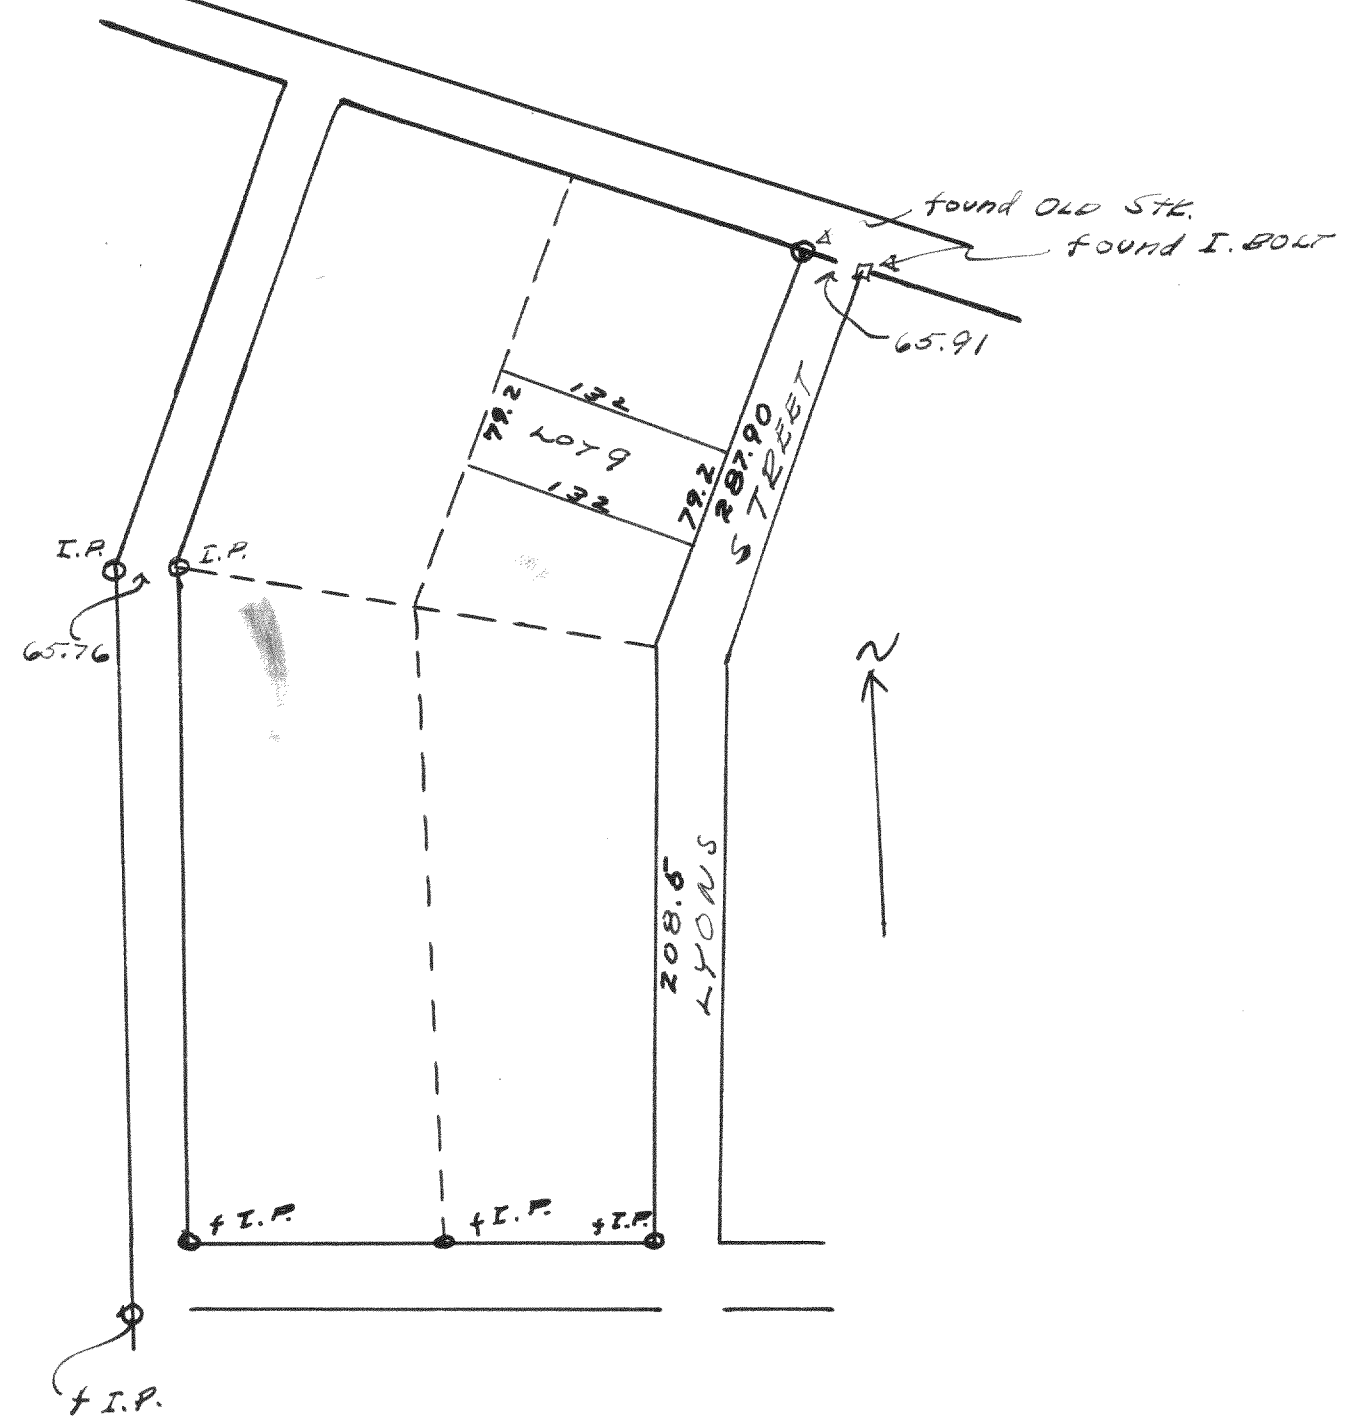


Survey of Lot 9 of  
Burkes Addition to  
the Village of Lyons

9-3-38

Lloyd L. Jensen  
by K. E. J.

SURVEY No. 951

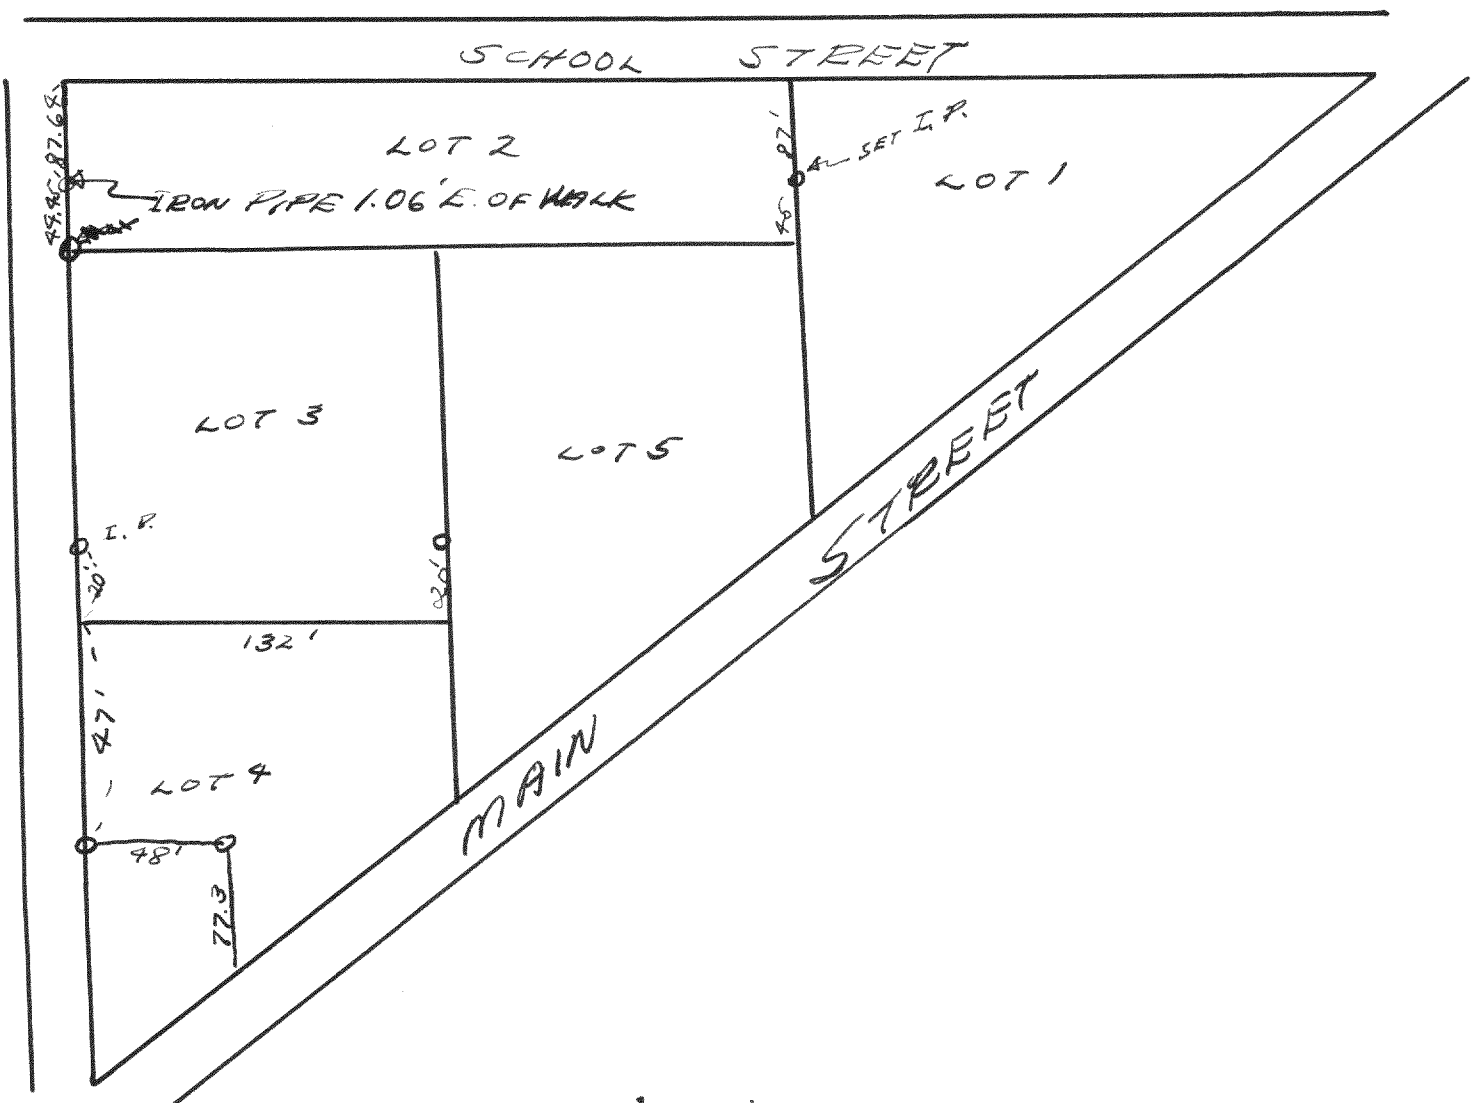

Survey of Block 50 of the  
original town of East  
Troy

NO DATE

Lloyd L. Jensen  
by K. E. J.