


SURVEY No. 954

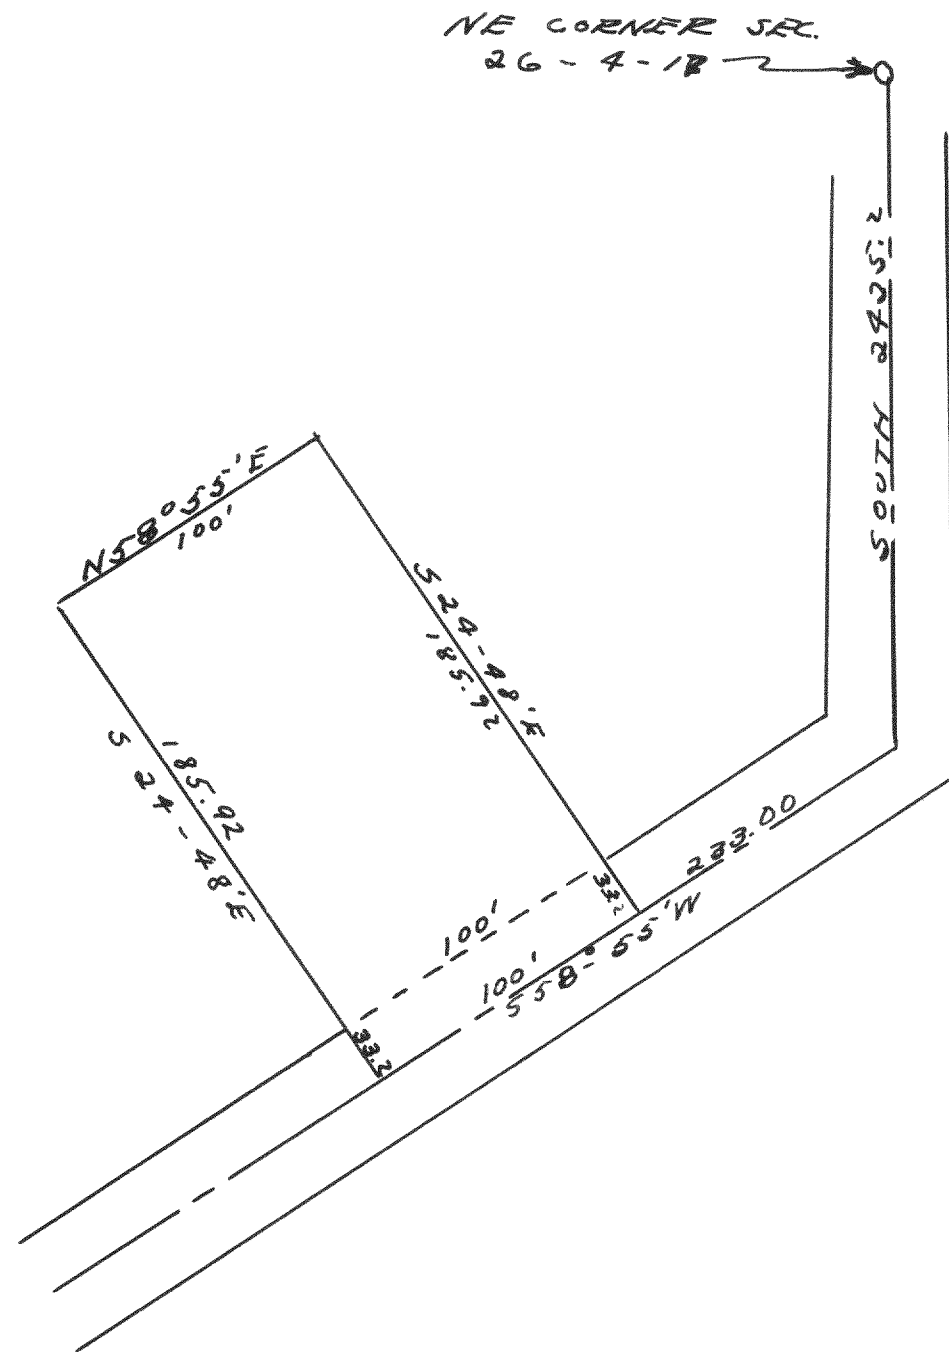


Survey of a parcel of land in the E 1/2 26-4-16

12-15-38


Lloyd L. Jensen by N.E.J.

SURVEY No. 955

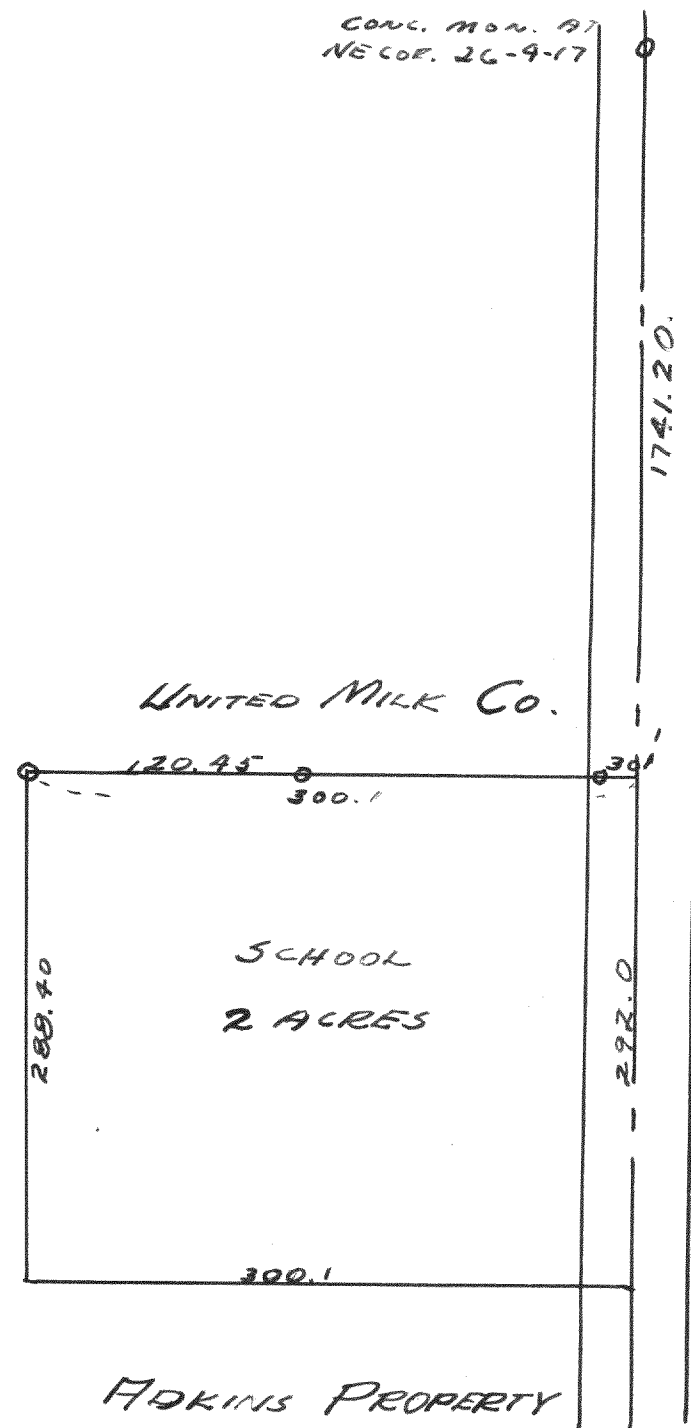

Survey of a parcel of land in the East half of 26-4-17

SURVEY No. 956

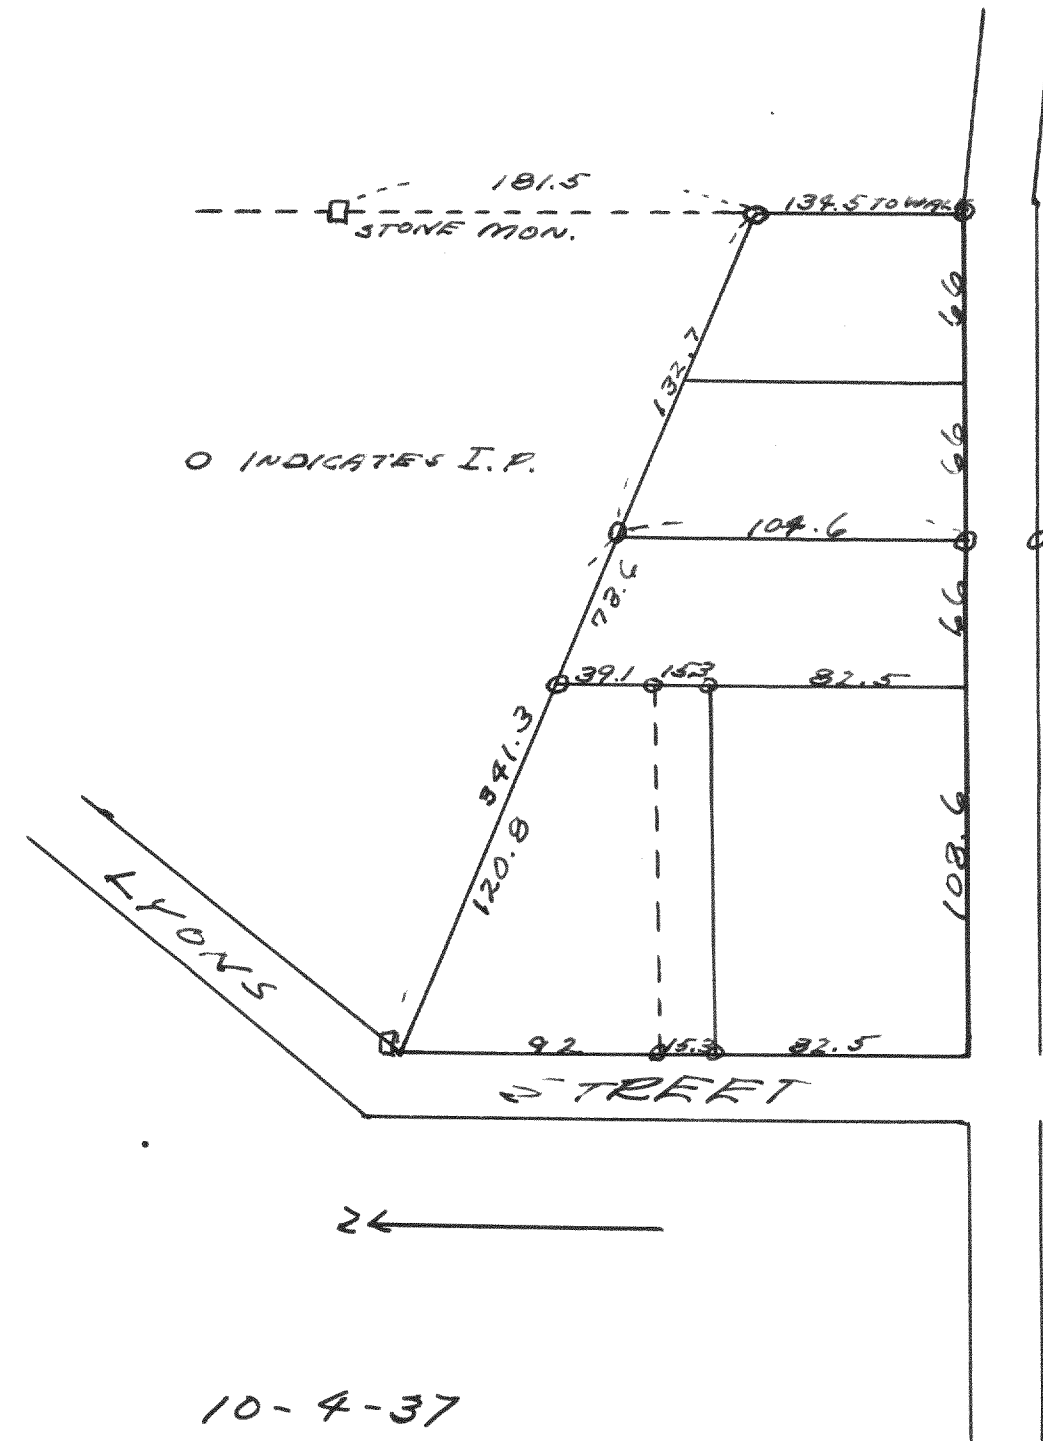

Survey of lots 1, 2, 3, 4, 5 of Purke's Add to the Village of Lyons.

Lloyd L. Jensen by N.E.J.