


SURVEY NO. 1040

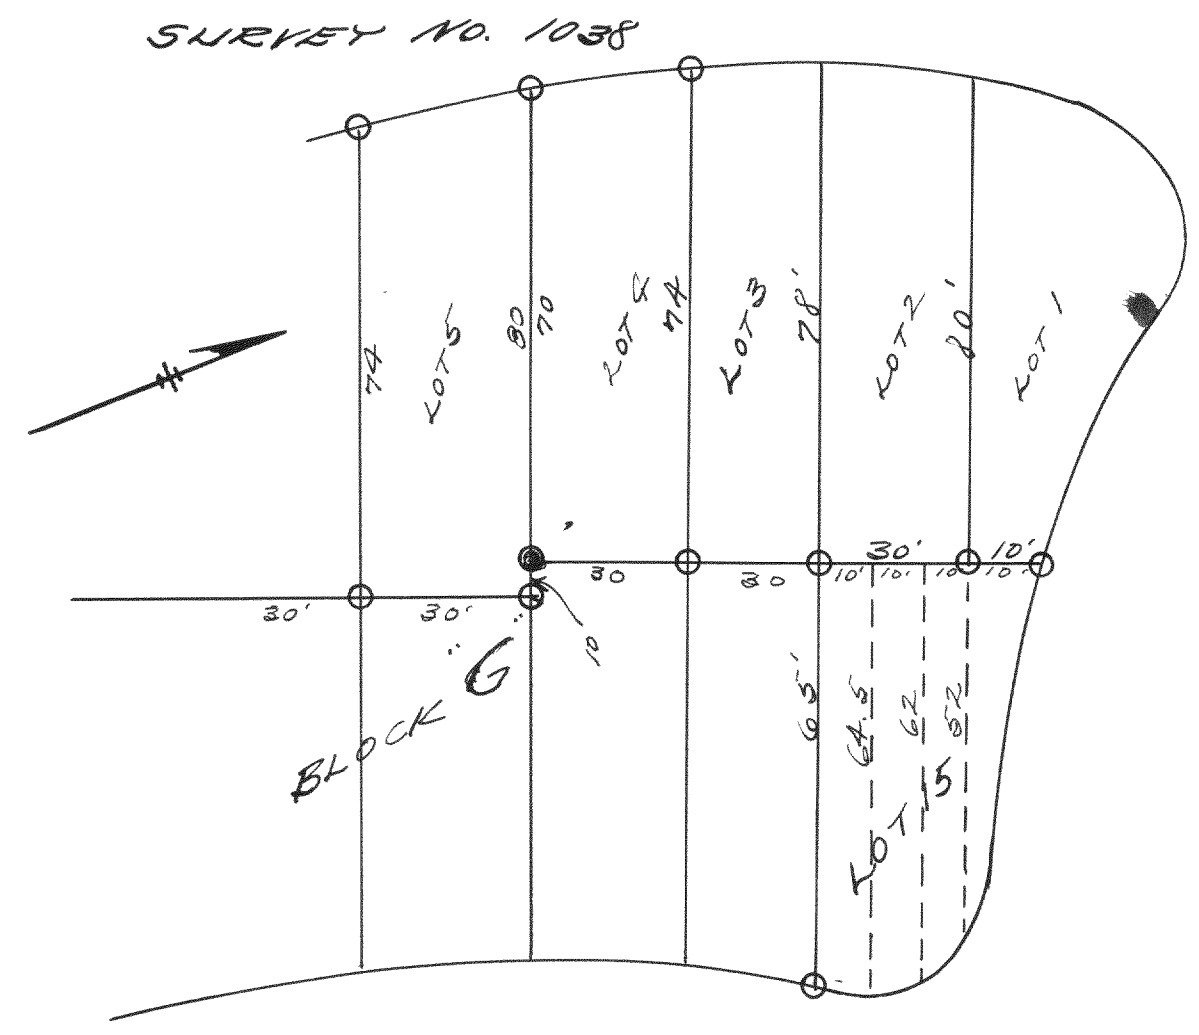


Survey of lots 4, 5 & 15 of Block G of Delavan Lake Assembly Grounds T2N R16E, Walworth County, Wisconsin Aug. 2, 1939

Lloyd L. Jensen by K.E.J.

SURVEY NO. 1039

See Vol. page for complete drawing of Deakin Isle as re-subdivided. October, 1939

Lloyd L. Jensen by K.E.J.

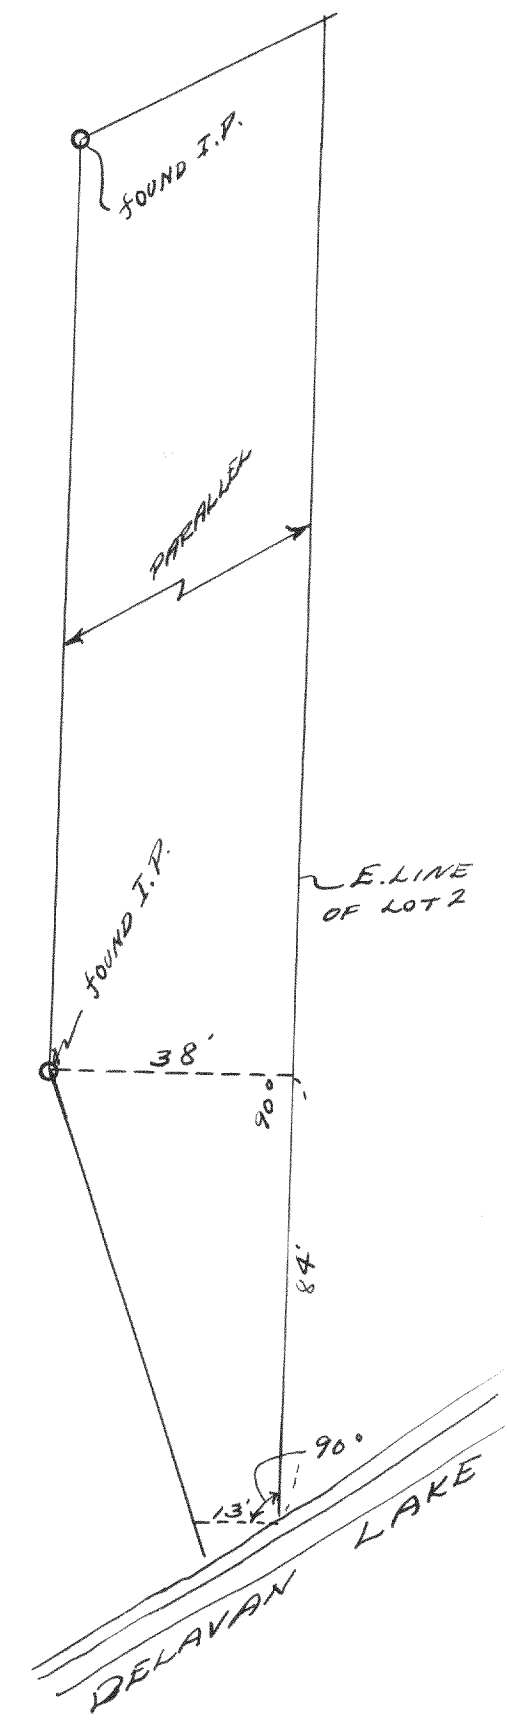


NOTE: SURVEY WAS BASED UPON TWO I. STAKES FOUND WHICH WERE NOT CHECKED.

Survey of part of lot 2 of the plat of Adron located in T2N R16E of Walworth County Wisconsin. Nov. 1939

Lloyd L. Jensen by K.E.J.

SURVEY NO. 1041

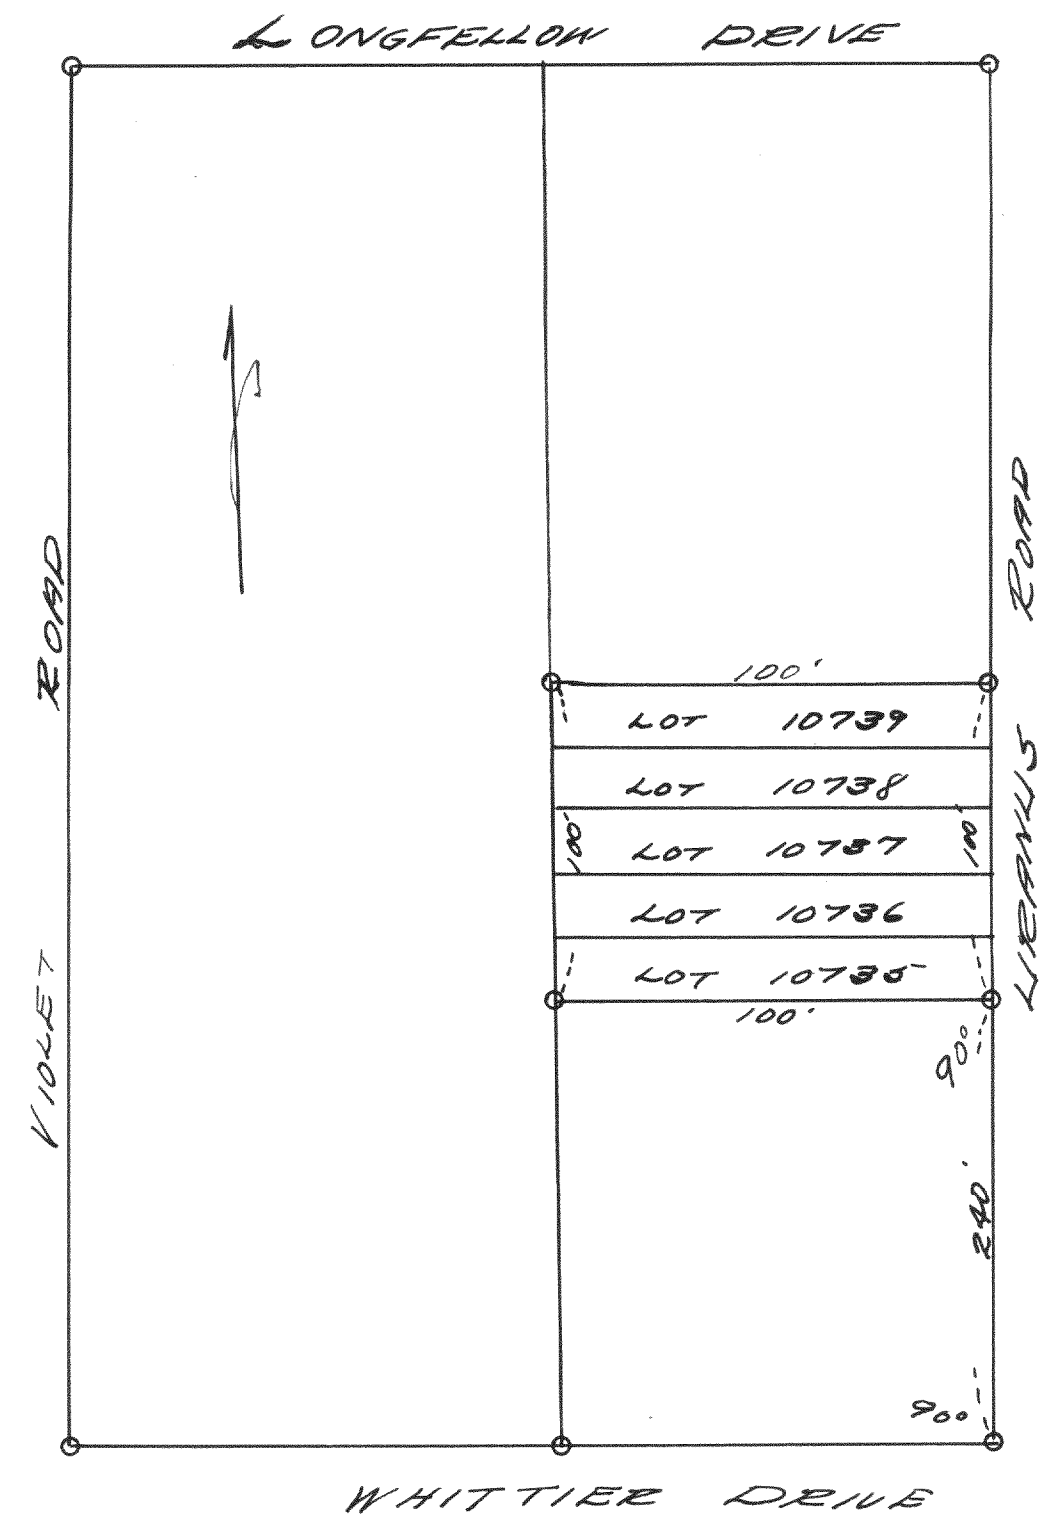

Survey of lots 10739 to 10735 inc. of Lake Como Beach T2N R17E, Walworth County, Wisconsin Nov. 9, 1939

Lloyd L. Jensen by K.E.J.