



SURVEY NO. 1158

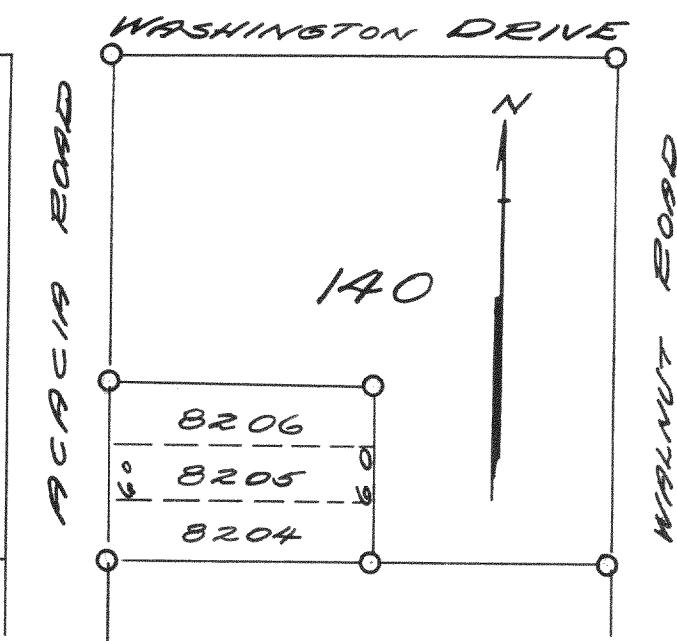

PLAT OF SURVEY OF LOTS
8204 TO 8206 OF LAKE
COMO BEACH SUBD.

JULY, 1940 *Lloyd L. Jensen*
K.E.S.

SURVEY NO. 1159

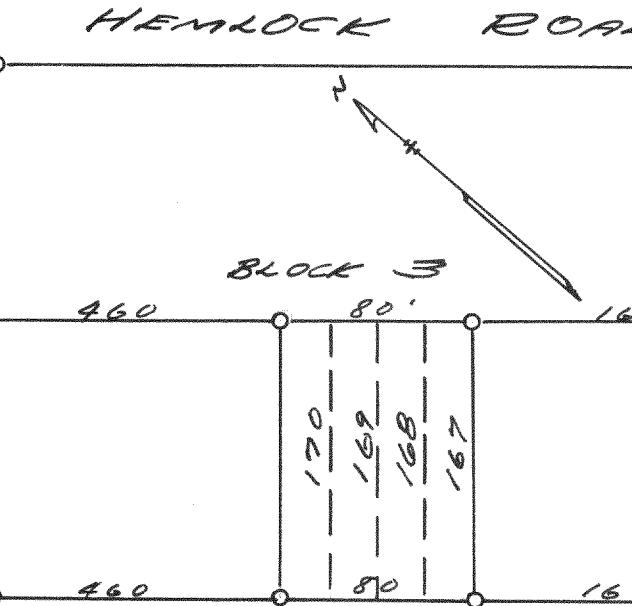


U. S. HIGHWAY NO. 12.

PLAT OF SURVEY OF LOTS 167, 168,
169 & 170 OF BLOCK 3 OF SECTION
ONE OF PELL LAKE SUBDIVISION
NOV. 1939

Lloyd L. Jensen
K.E.S.


SURVEY NO 1160

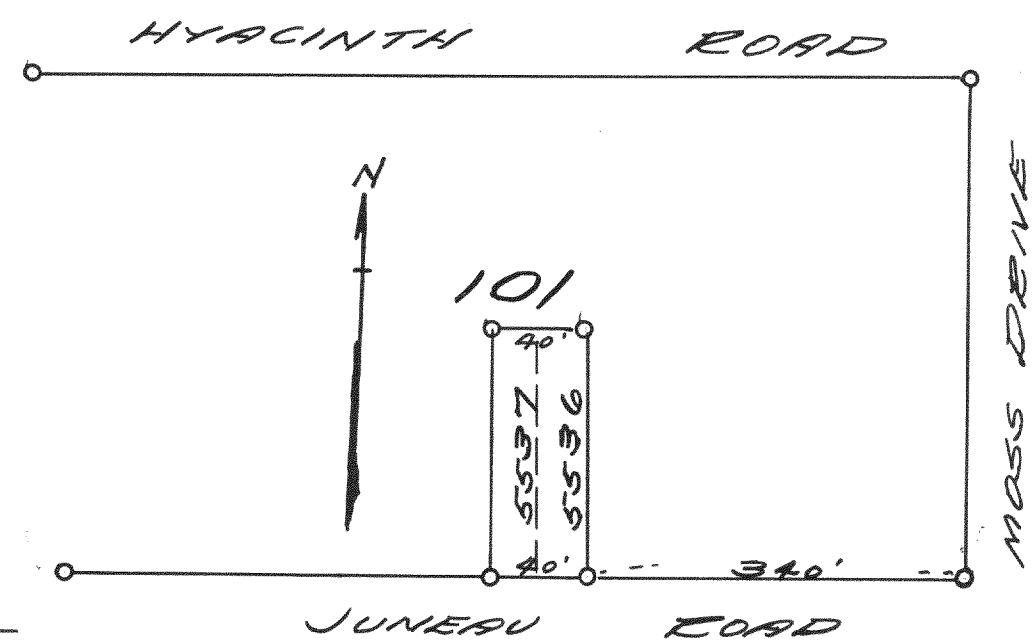

PLAT OF SURVEY OF LOTS
5236 & 5237 OF BLOCK 101
OF PELL LAKE SUBD.

JULY 1940 *Lloyd L. Jensen*
K.E.S.

SURVEY NO. 1161

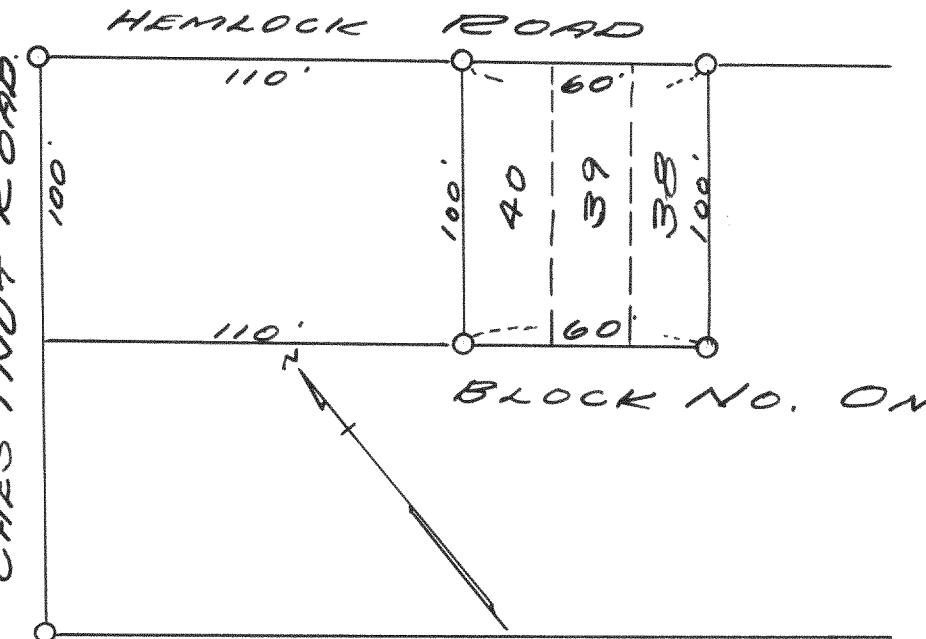


U. S. HIGHWAY NO. 12

PLAT OF SURVEY OF LOTS 38, 39
& 40 OF BLOCK 1 OF SECTION 1 OF
PELL LAKE SUBDIVISION, WIS. CO. WIS.

NOV. 1939 *Lloyd L. Jensen*
K.E.S.


SURVEY NO. 1162

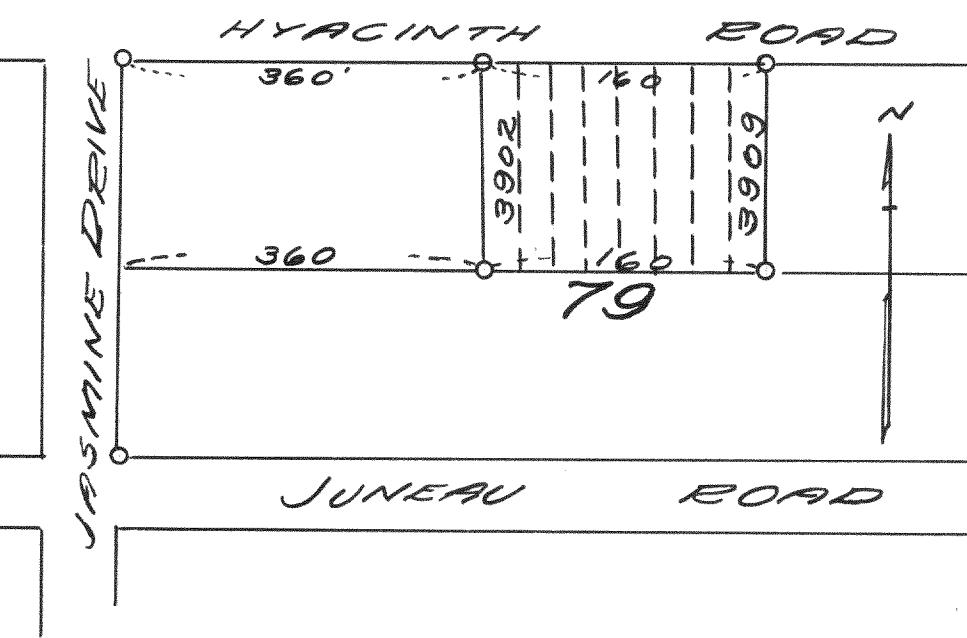

PLAT OF SURVEY OF LOTS 3902 TO
3909 OF SECTION 3 OF PELL LAKE
SUBDIVISION, WISCONSIN COUNTY, WIS.

JULY 2, 1940 *Lloyd L. Jensen*
K.E.S.

SURVEY NO. 1163

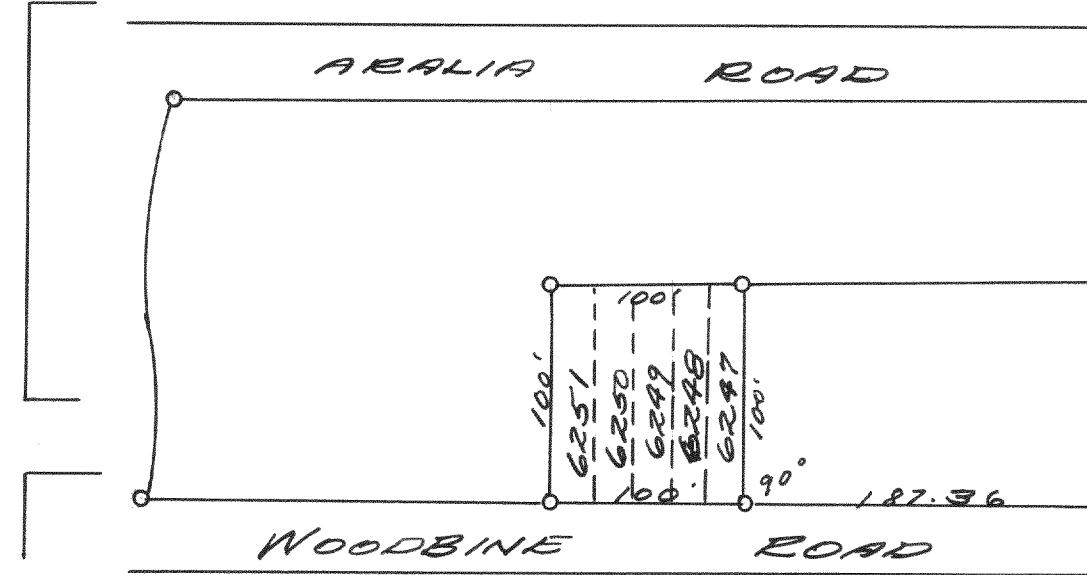

PLAT OF SURVEY OF LOTS 6247
TO 6251 OF SECTION 4 OF PELL
LAKE SUBDIVISION

JULY, 1940 *Lloyd L. Jensen*
K.E.S.