



PLAT OF SURVEY OF LOTS 9051 TO 9055
OF LAKE COMO BEACH SUBDIVISION, WALWORTH
COUNTY, WISCONSIN
AUG. 12, 1940
Lloyd L. Jensen
H.E.J.

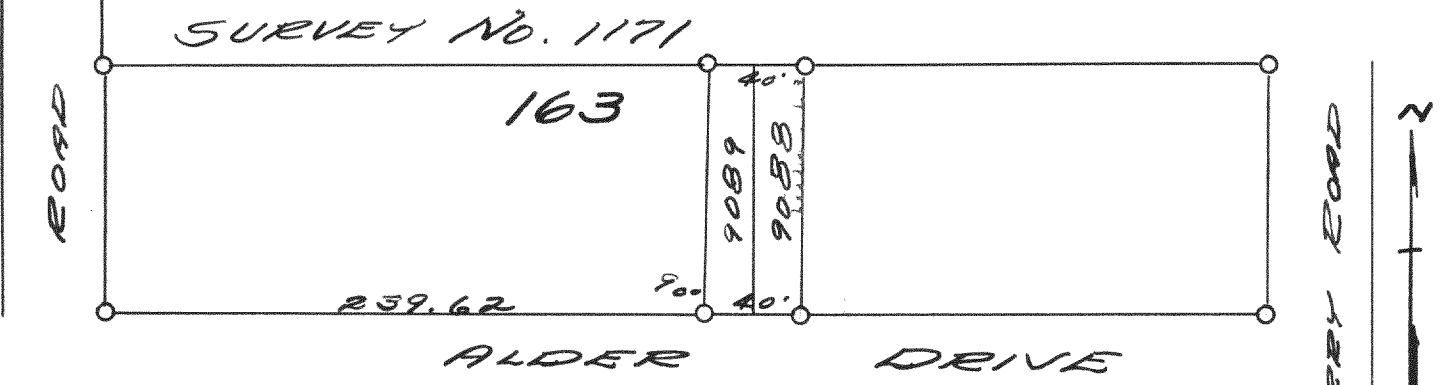


PLAT OF SURVEY OF LOTS 9088 AND
9089 OF LAKE COMO BEACH SUBDIVISION
WALWORTH COUNTY, WISCONSIN
AUG. 12, 1940
Lloyd L. Jensen
H.E.J.

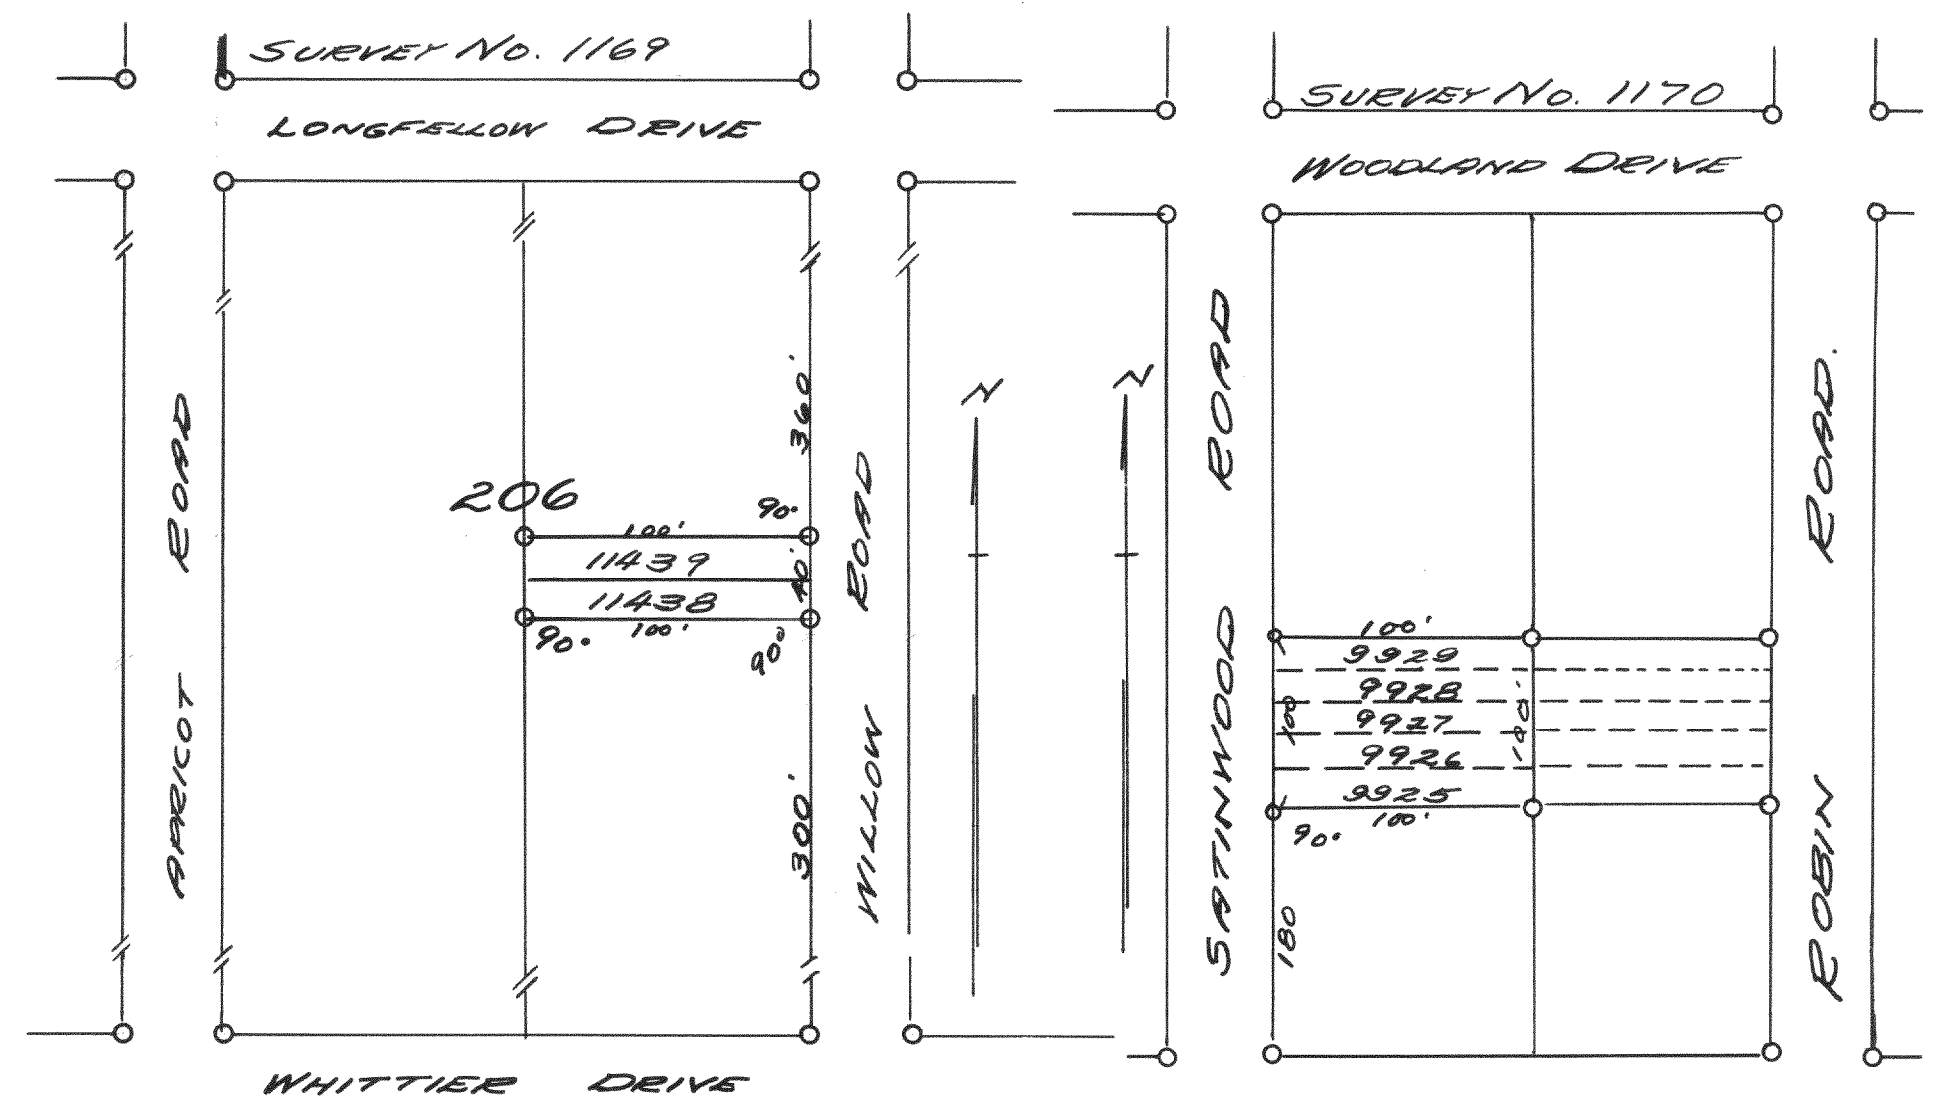

PLAT OF SURVEY OF LOTS
11438 AND 11439 OF LAKE
COMO BEACH SUBDIVISION.
JULY 3, 1940
Lloyd L. Jensen
H.E.J.

PLAT OF SURVEY OF
LOTS 9925 TO 9929 OF
LAKE COMO BEACH
1940
Lloyd Jensen
H.E.J.

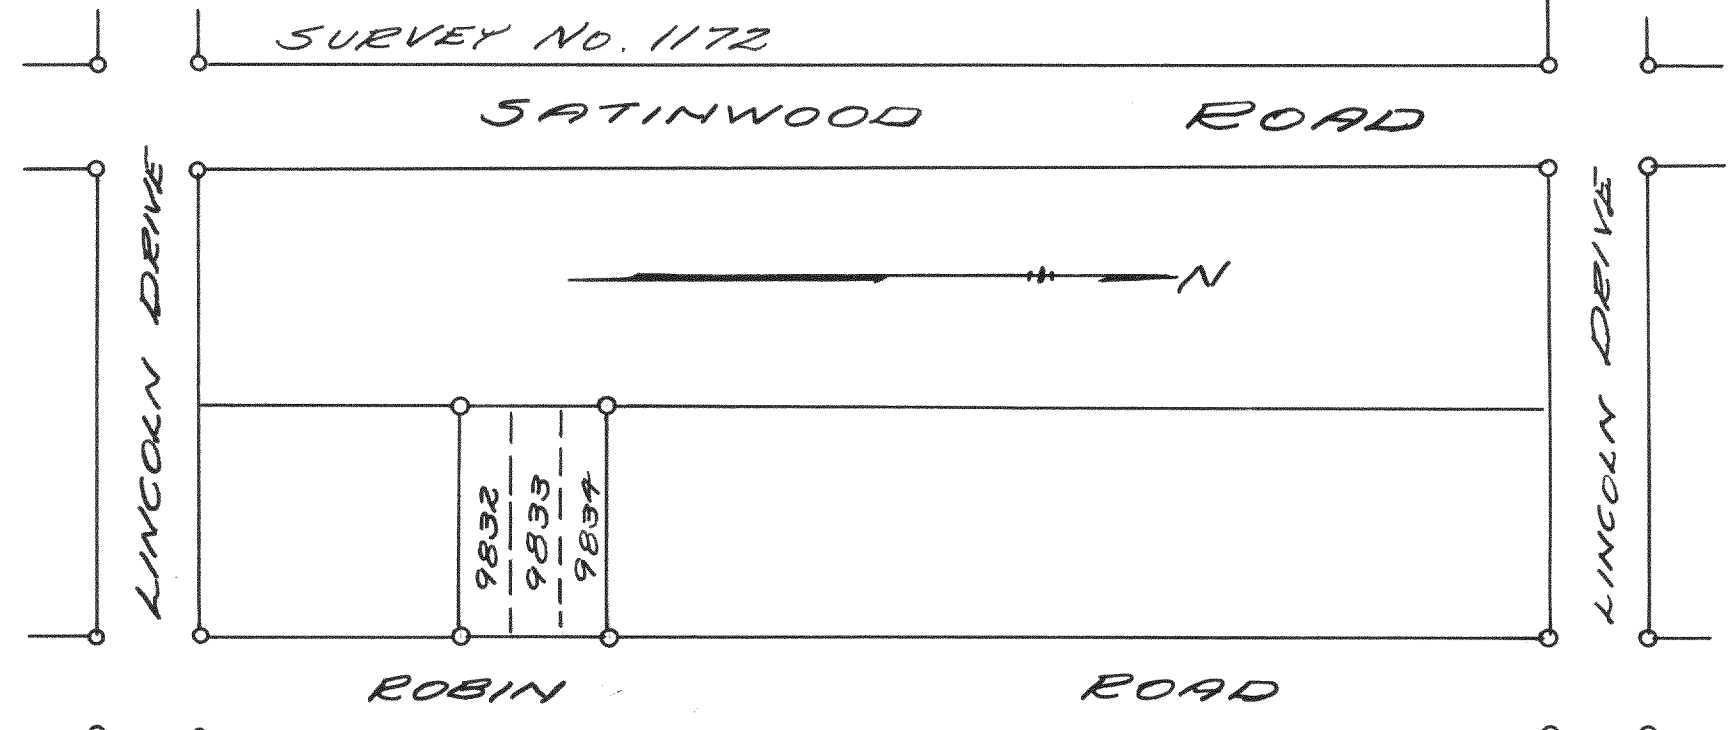

PLAT OF SURVEY OF LOTS 9832 TO 9834
OF LAKE COMO BEACH, WALWORTH CO., WISC.
JULY 31, 1940
Lloyd L. Jensen
H.E.J.