

Record of Survey.


No 281

Township..... DELAYAN North of Range..... of 4 Principal Meridian
as presented by the courses and distances on the following plat, and annexed field-notes of survey:

Established the center of the section at the point of intersection of STRAIGHT quarter lines.

Established all quarter-quarter corners upon the section boundary at proportional distances between known section and quarter section corners, according to the original field-notes of the Government survey.

Established all lost corners at proportionate distances between known corners, according to the original field notes of the Government survey.

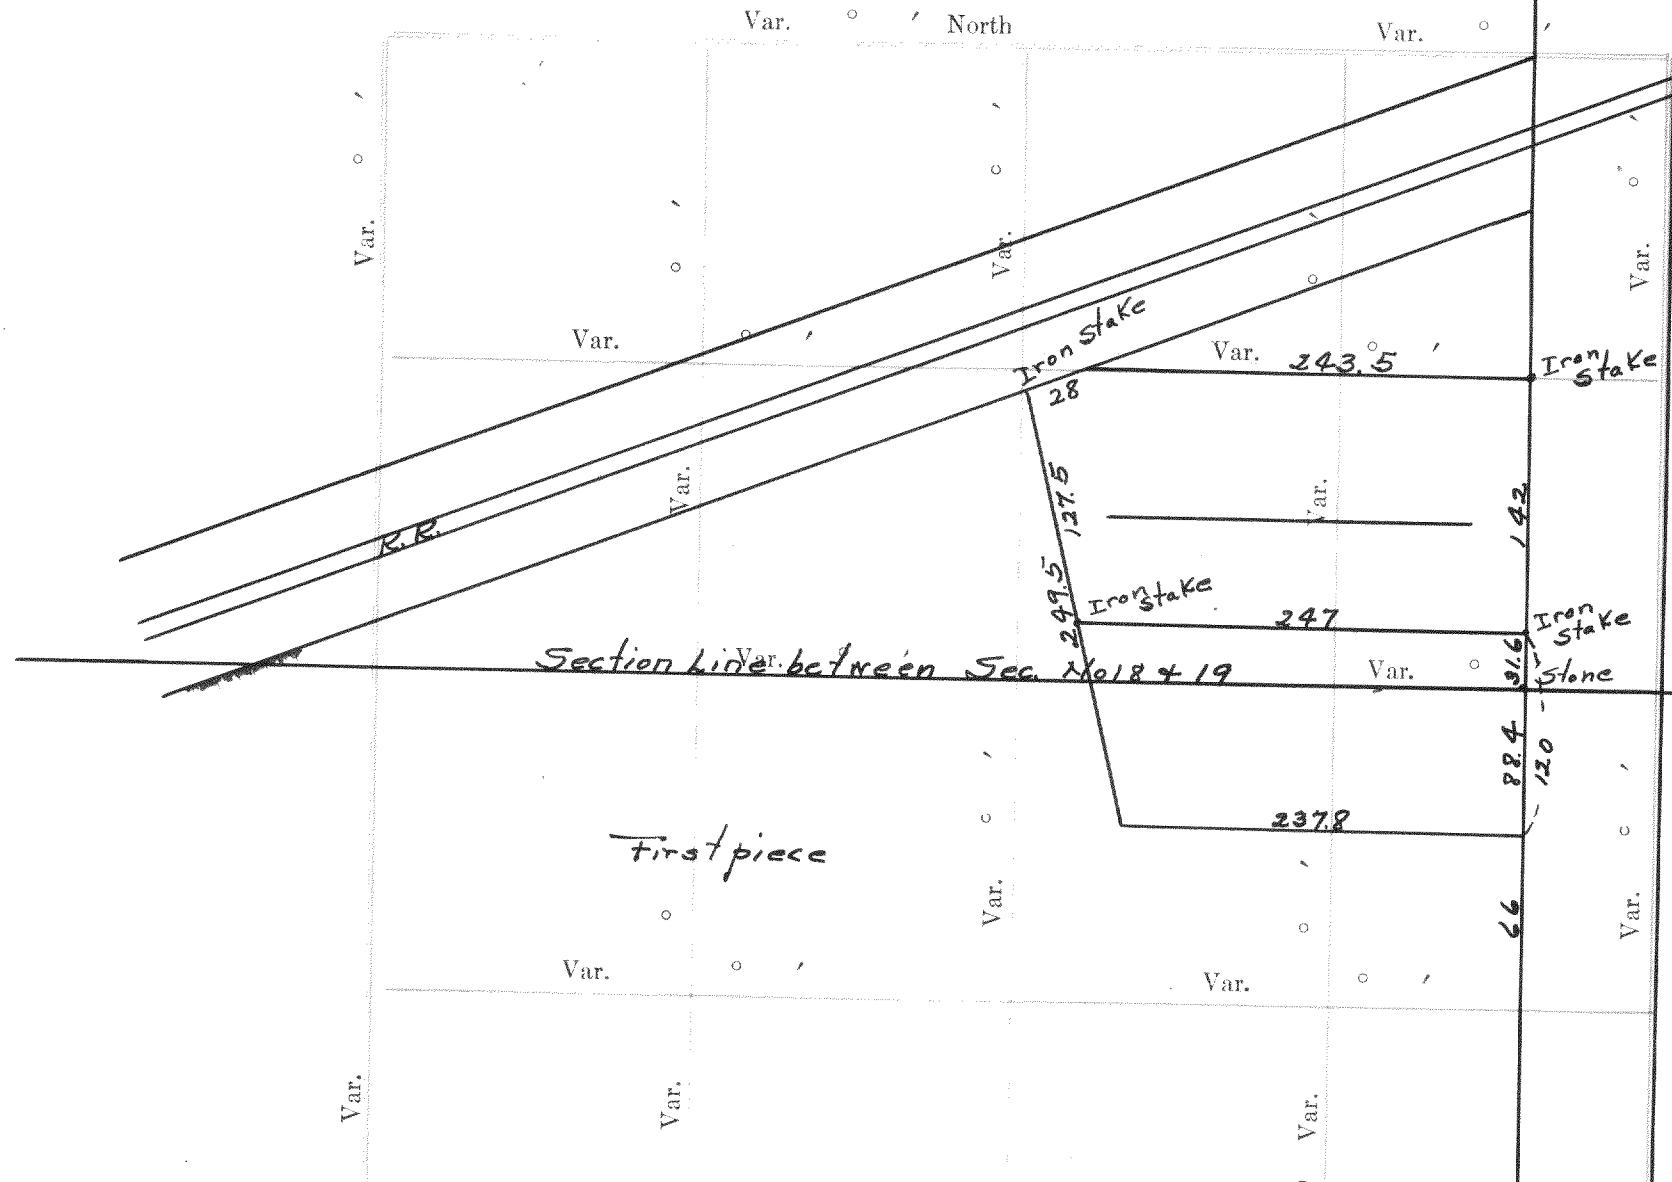

Plat of Section....., Township..... North Range..... of 4 Principal Meridian Scale

80 chains to 6 inches. The figures in red ink are the lengths of the lines as stated in the field notes of the Government survey.

Declination of the Magnetic Meridian from the True Meridian.....

Surveyed and sub-divided..... A. D. 1, in accordance

with the State Laws and Instructions of the Commissioner of the General Land office, and recorded on pages

of Register in the County Clerk's office.

Witness my hand this..... day of..... A. D. 1

SURVEYOR.

DESCRIPTION

OF SECTION, QUARTER SECTION AND QUARTER QUARTER SECTION CORNERS

H. C. MILLER CO. MFG. STATIONERS. MILWAUKEE X15000

GOVERNMENT CORNERS	Bearing Trees	In. Dia.	Courses they bear	Links Distant	Bearing Trees	In. Dia.	Courses they bear	Links Distant	Bearing Trees	In. Dia.	Courses they bear	Links Distant
--------------------	---------------	----------	-------------------	---------------	---------------	----------	-------------------	---------------	---------------	----------	-------------------	---------------

No.

1. N. W. Sec. Cor. identified,
2. N. E. Sec. Cor. identified,
3. S. E. Sec. Cor. identified,
4. S. W. Sec. Cor. identified,
5. N. $\frac{1}{4}$ Sec. Cor. identified,
6. E. $\frac{1}{4}$ Sec. Cor. identified,
7. S. $\frac{1}{4}$ Sec. Cor. identified,
8. W. $\frac{1}{4}$ Sec. Cor. identified,

Subdivision Corners

No.

1. Center $\frac{1}{4}$ Sec. Cor.
2. North $\frac{1}{4}$ - $\frac{1}{4}$ s N. W. qr.,
3. East $\frac{1}{4}$ - $\frac{1}{4}$ s N. W. qr.,
4. South $\frac{1}{4}$ - $\frac{1}{4}$ s N. W. qr.,
5. West $\frac{1}{4}$ - $\frac{1}{4}$ s N. W. qr.,
6. Center $\frac{1}{4}$ - $\frac{1}{4}$ s N. W. qr.,
7. North $\frac{1}{4}$ - $\frac{1}{4}$ s N. E. qr.,
8. East $\frac{1}{4}$ - $\frac{1}{4}$ s N. E. qr.,
9. South $\frac{1}{4}$ - $\frac{1}{4}$ s N. E. qr.,
10. Center $\frac{1}{4}$ - $\frac{1}{4}$ s N. E. qr.,
11. East $\frac{1}{4}$ - $\frac{1}{4}$ s S. E. qr.,
12. South $\frac{1}{4}$ - $\frac{1}{4}$ s S. E. qr.,
13. West $\frac{1}{4}$ - $\frac{1}{4}$ s S. E. qr.,
14. Center $\frac{1}{4}$ - $\frac{1}{4}$ s S. E. qr.,
15. South $\frac{1}{4}$ - $\frac{1}{4}$ s S. W. qr.,
16. West $\frac{1}{4}$ - $\frac{1}{4}$ s S. W. qr.,
17. Center $\frac{1}{4}$ - $\frac{1}{4}$ s S. W. qr.

No 282

DELAYAN

Walworth Street

set	66	66	66	66	66	66	66
Edge of Walk	66	66	66	66	66	66	66
Set	26	25	24	23			
9" on Walk			24				
Street							
set	66	66	66	66	66	66	66
found	33	33	33	33	33	33	33

Surveyed by Wm Child CS.

Recorded by Lloyd S. Jensen CS.
Feb 24, 1934

NAMES OF SWORN ASSISTANTS

FLAGMEN

AXMEN

No 283

Delavan City

Beginning at a point in the center of Beloit Street, in the City of Delavan, Walworth County, Wisconsin, and being also on the Southwest $\frac{1}{4}$ of Section No. 18, T2 N, R16 E, where a line drawn parallel with and 175.5 feet north of the South line of lands deeded to G. H. Barnes and H. S. Winsor March 30, 1866, and which deed is recorded in the Register of Deeds office in and for Walworth Co., in Vol. 39 of deeds, page 352; Thence east from said place of beginning, 1200 feet, to a stake; Thence S. 175.5' to a stake on the S. line of lands deeded to said Barnes and Winsor, as above mentioned; Thence E. to the NW corner of lands deeded by G. H. Barnes and wife to J. J. Fidler July 7, 1880, and which deed is recorded in the Register of Deeds office in and for said county, in Vol. 64 of deeds, on page 241; Thence northeasterly along said Fidler's South line to the N.W. corner of C. L. Flounie's Addition to the Village (now City) of Delavan; Thence West, on a line, being a continuation of the North line of said Addition, 114' more or less, being the South line of lands deeded by G. H. Barnes, deceased, by executor, to Eugene F. Cannon, June 8, 1892, and recorded in Vol. 94 of deeds, page 628 for said Co., to the SW cor. thereof; Thence N., on the W. line of lands so deeded to said Cannon, 264' to the NW corner thereof; Thence E. on the N. line of lands so deeded, being a line parallel with, and 264' N. of, the N. line of the above mentioned Flounie's Add., to the W. line of Terrace Street, in the City of Delavan; Thence northerly, along the W. line of said Terrace St., to a pt. 67' S. of the S. line of Blk 15, in said City, being the SE cor. of lands deeded by G. H. Barnes and wife to M. Burns April 23, 1889, and which deed is recorded in the Register of Deeds Office in and for Walworth Co., in Vol. 80 of deeds, on page 266; Thence West, parallel with the South line of said Addition, to a point 67' South of and in line with the West line of lot 1 of said Blk. 15; Thence North to the SW cor. of said lot 1; Thence W. along the S. line of said Blk 15, and continuing of said S. line (being the S. line of lands owned by one Warren Jenkins, to the southeasterly line of lands owned by John & Mary Cronan; Thence southwesterly along said Cronan's SE line to the S. cor. of said land; Thence northwesterly along the SW side of said land, 117', to a stake at the N. end of the E line of Blk. 5 of F.K. Phoenix Add. to the City of Delavan; Thence South along said East line 232', to a stake at the SE cor. of said Blk. 5, and containing 5. 82 $\frac{1}{2}$ ' more, to a pt. on the S. side of, and being the E. end of, the S. line of Birney Street, in said Add.; Thence W. along the S. line of said street, to the NE cor. of lands deeded by G. H. Barnes and wife to Edward Casey Sept. 30, 1889, and which deed is recorded in the Register of Deeds Office in & for Wal Co., in Vol. 80 of deeds, on page 65; Thence S 66', to the SE cor. of lands so deeded; Thence W., parallel with the S. line of said street, to the center of Beloit Street; Thence southwesterly along said Beloit Street, to the place of beginning, excepting and reserving from the above described piece of land one certain 2 acre parcel deeded by the heirs-at-law of the late G. H. Barnes to the City of Delavan, July 17, 1902, which deed is recorded in the Register of Deeds Office in and for Walworth County, Wisconsin, in Volume 107 of Deeds, on page 385. The above described piece containing (aside from the two acre piece reserved) 24.6 acres.

Surveyed by Wm Childs

Recorded by Lloyd S. Jensen
Feb. 24, 1934