



#1355

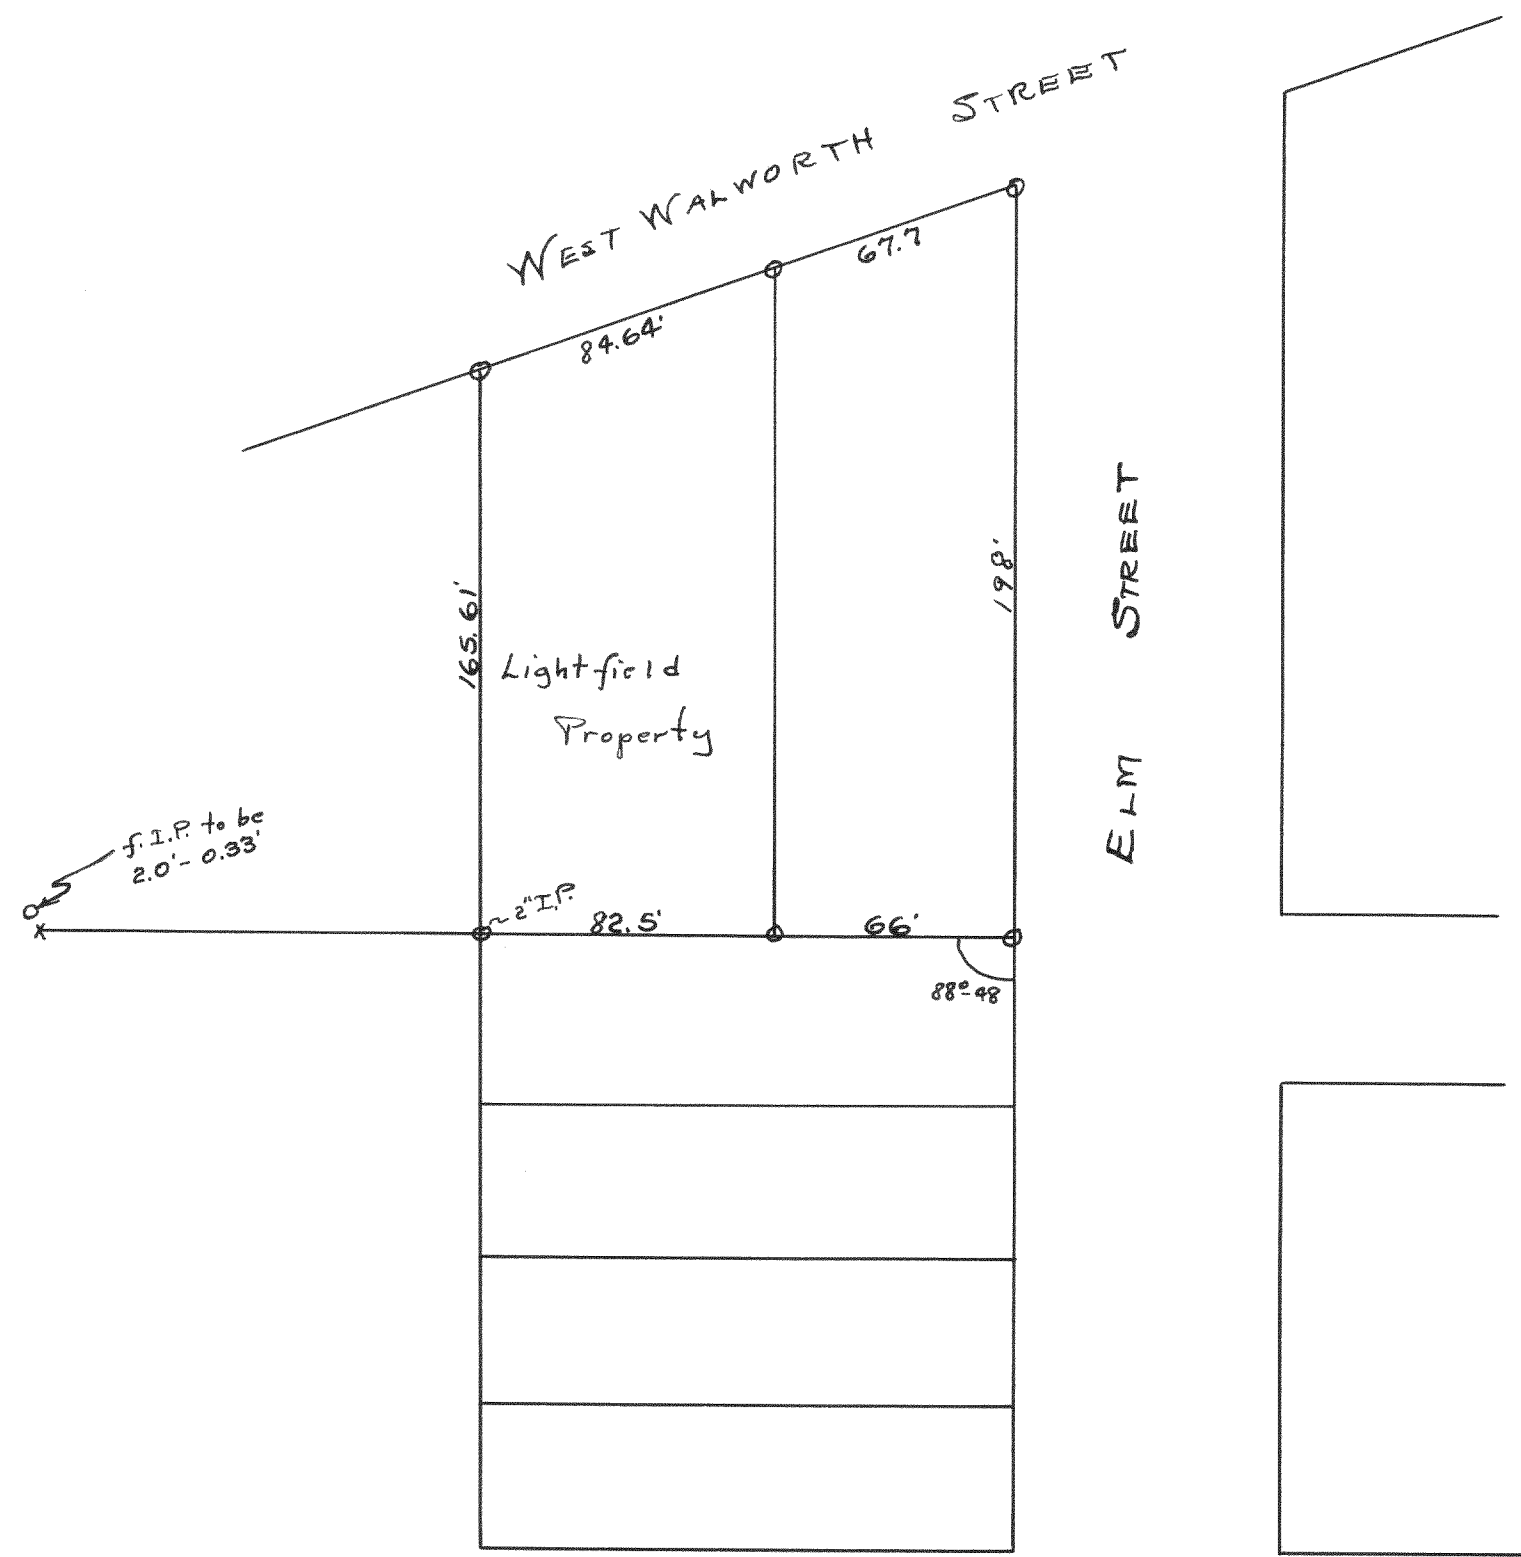

Plot of survey of Lightfield property
in the city of Oakhorn, Wisconsin.

May 1942 Lloyd L. Jensen
County Surveyor

#1356

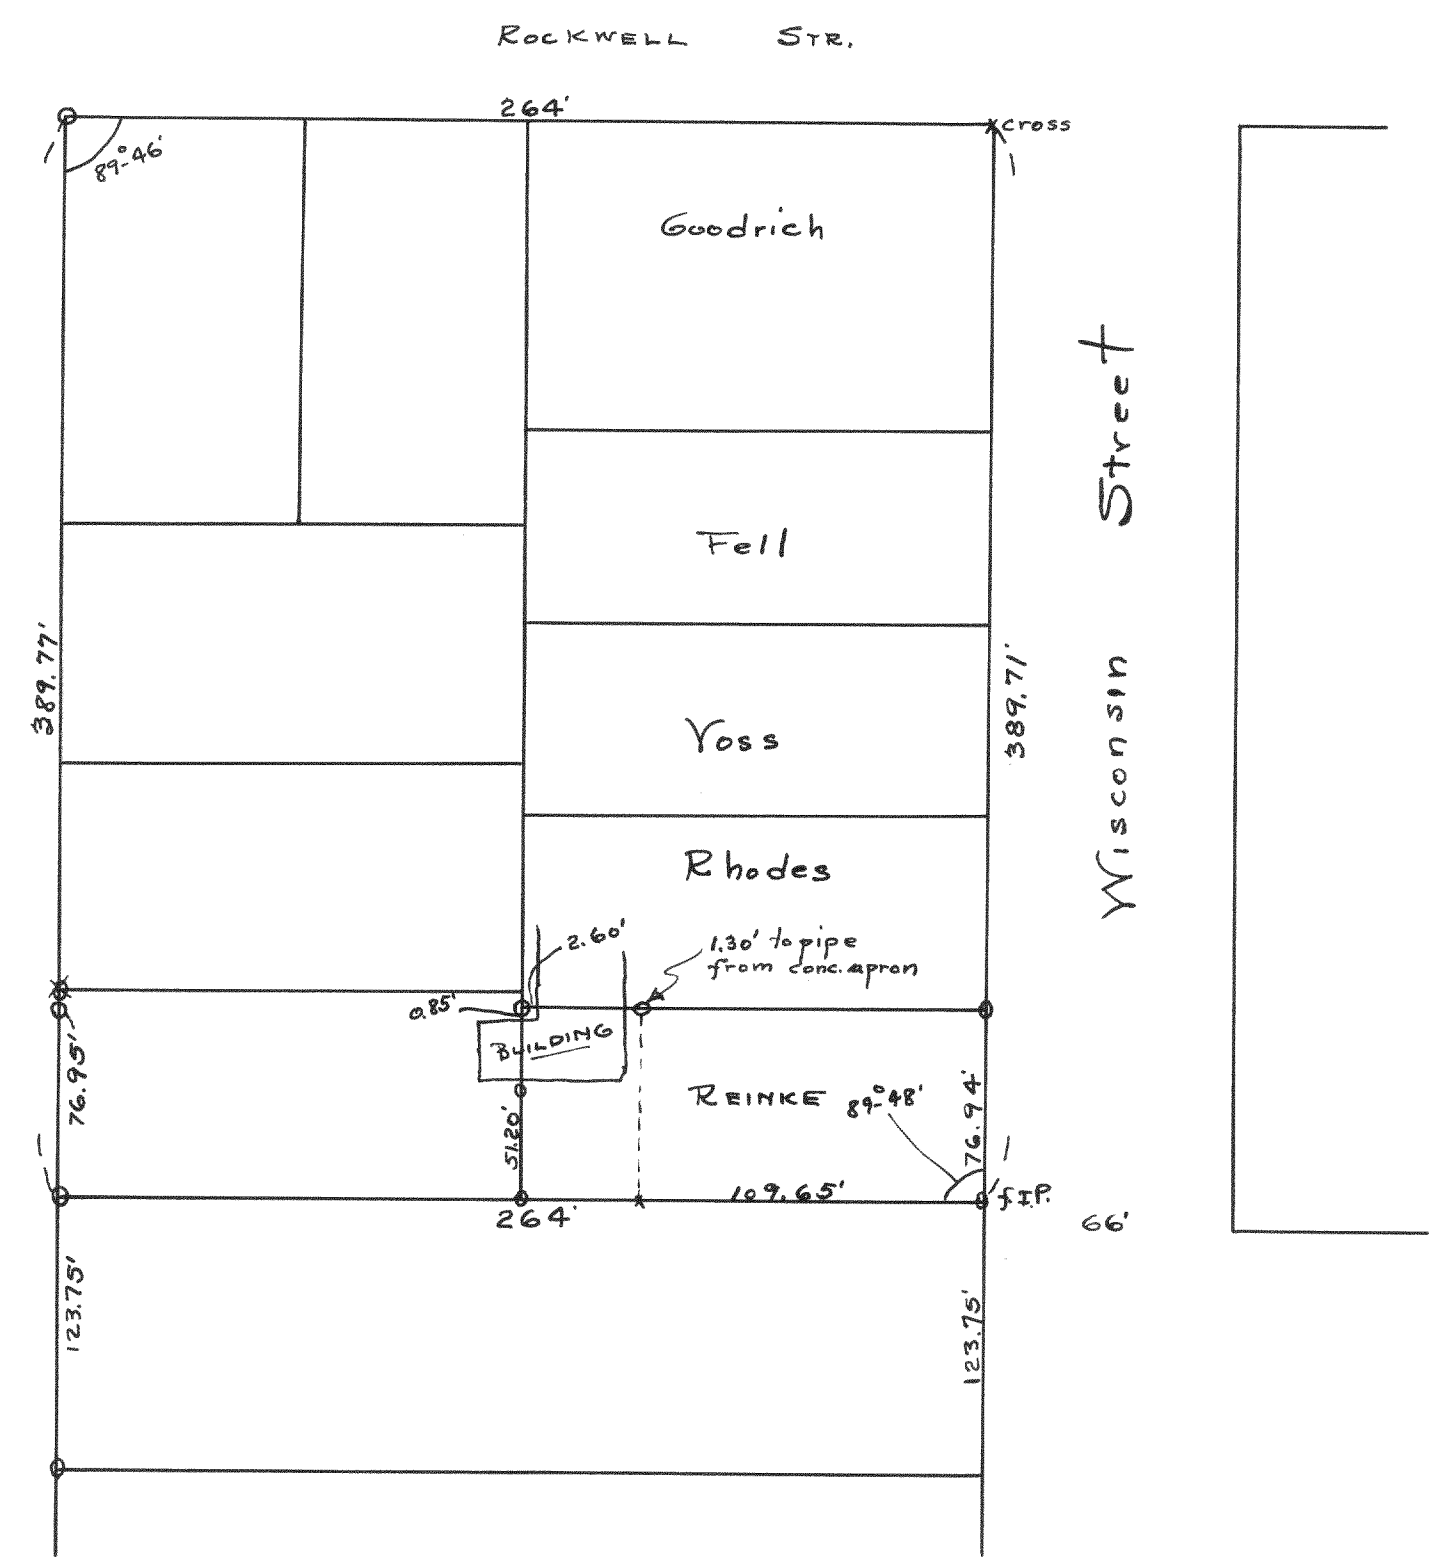

Plot of survey of Reinke property
in the city of Oakhorn, Wisconsin.

April 1942 Lloyd L. Jensen
County Surveyor