


#1363

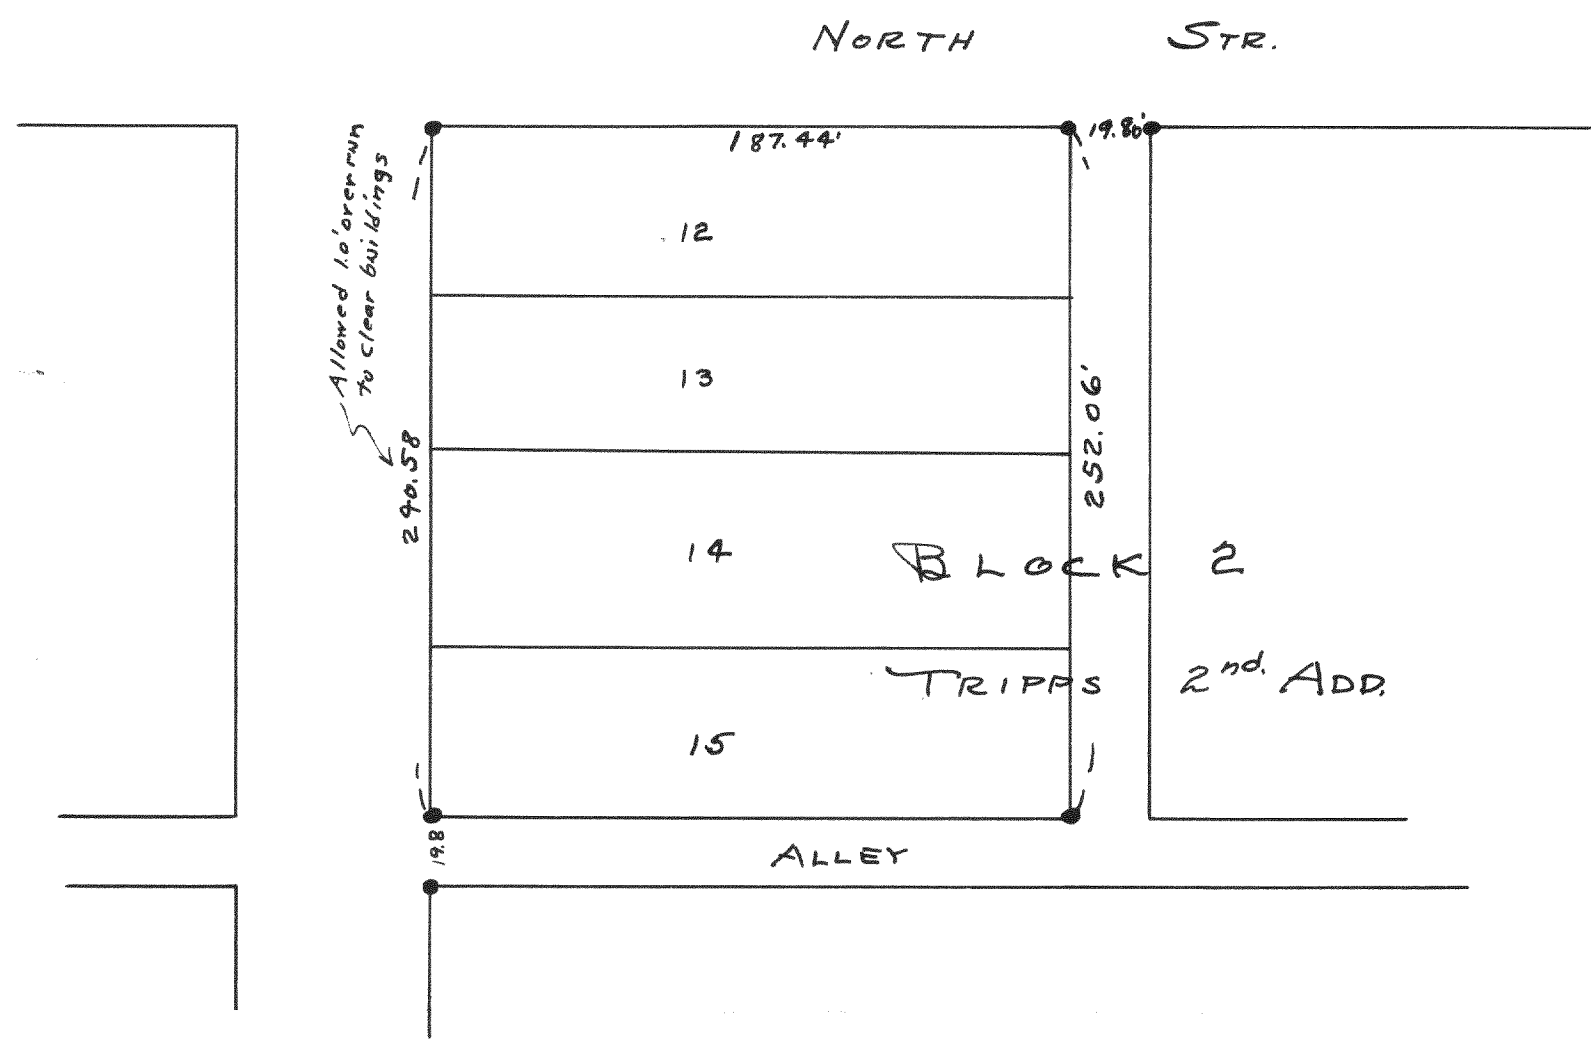


Plot of survey of West $\frac{1}{2}$ of Block 2 of Trippe's 2nd Add. to locate lines of the Alley, City of Whitewater.

Aug. 1942

Lloyd L. Jensen
County Surveyor

#1364

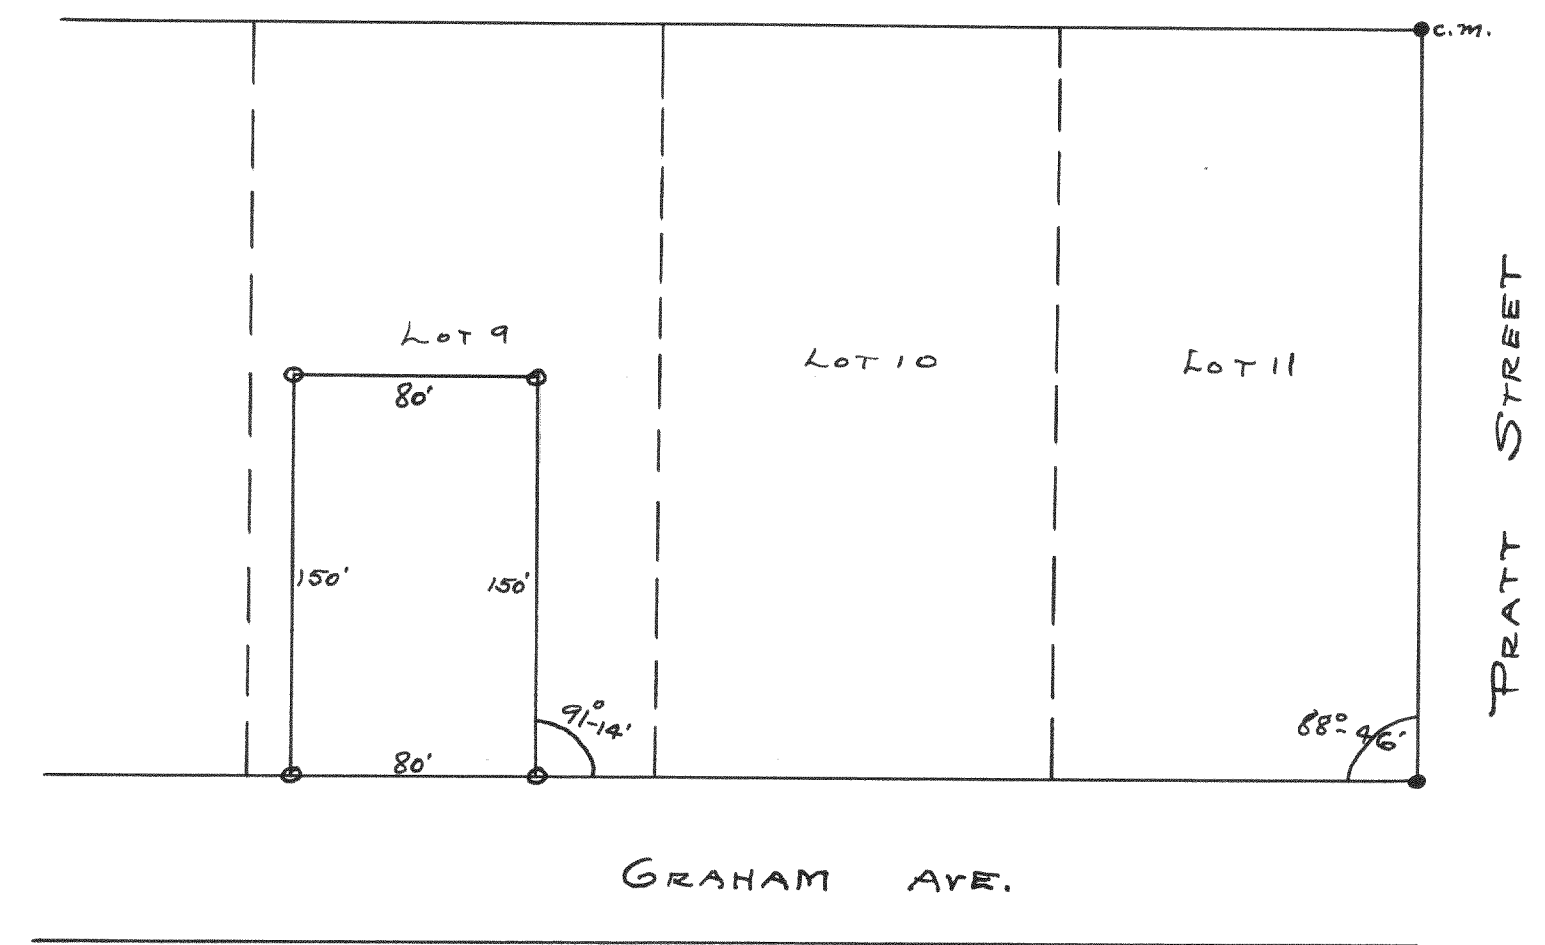

Plot of survey of part of Lot 9 of Block 1 of Graham and Trovill's Addition to The City of Whitewater.

June 1942

Lloyd L. Jensen
County Surveyor