


#1382

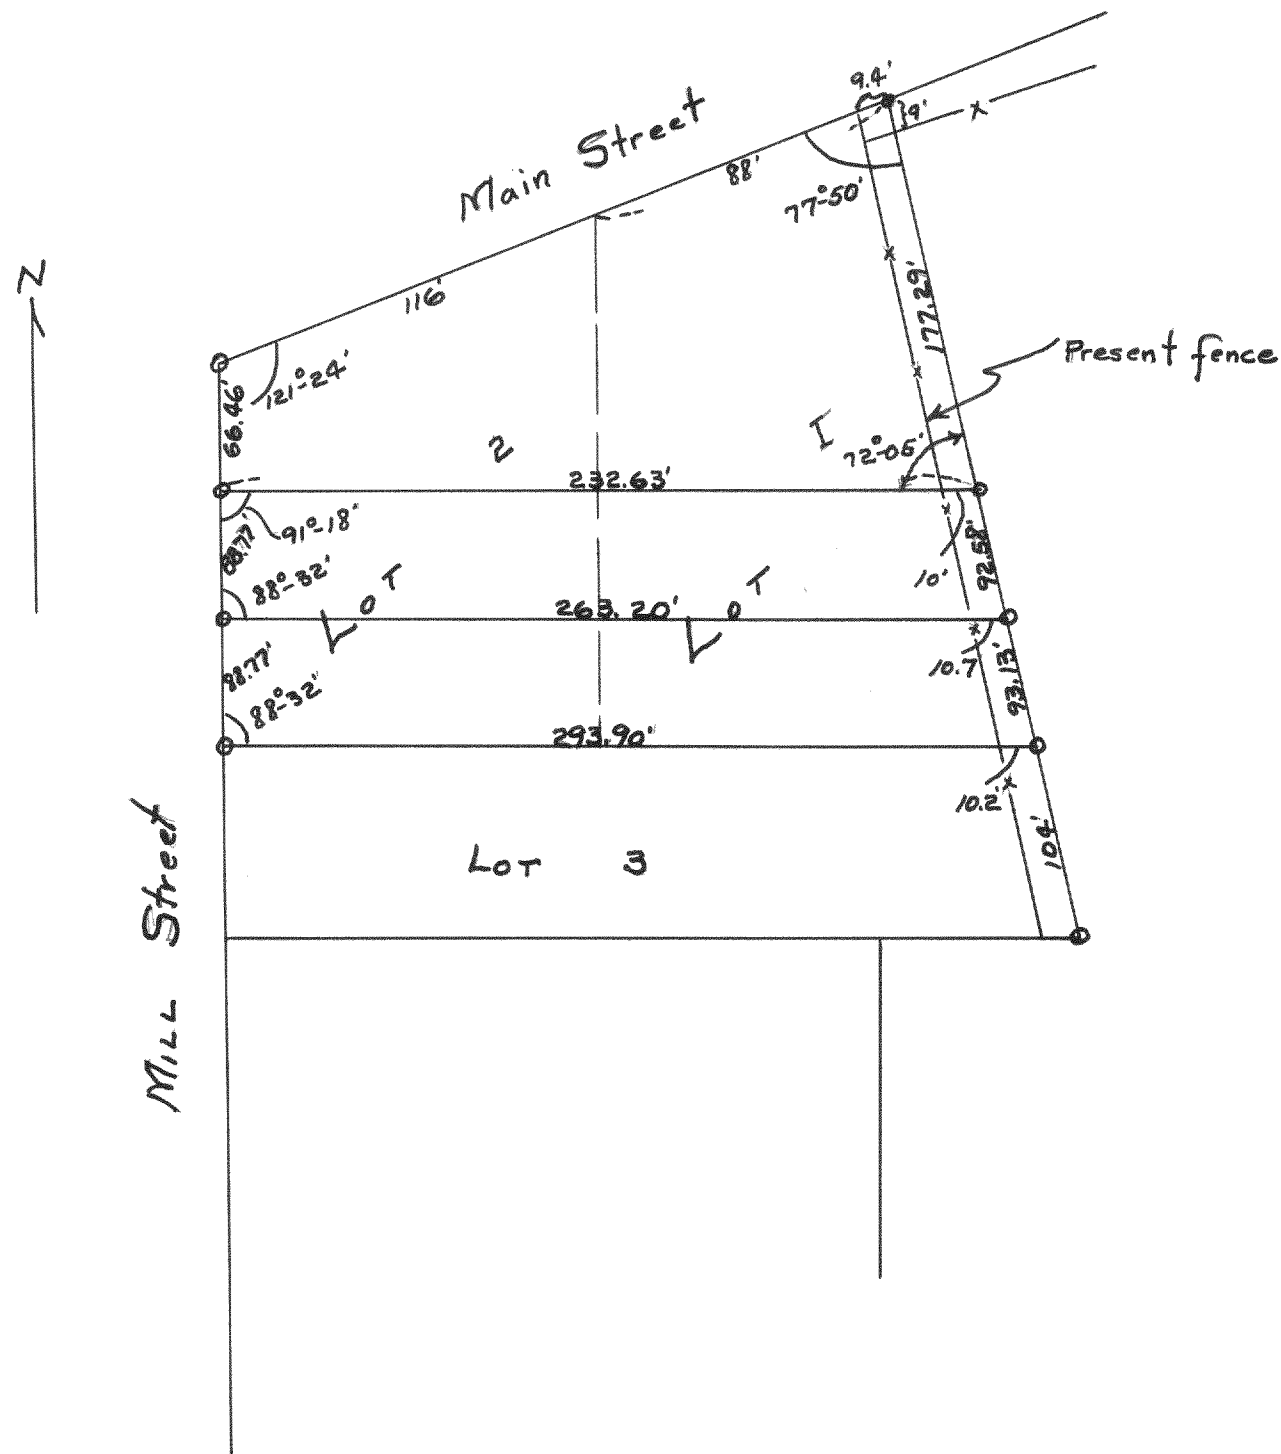


Plat of survey of the Subd. of Lots 1 & 2 of Bk. 13 of the Original Plat of the Village of East Troy Wis.

May 1943

Lloyd L. Jensen
County Surveyor

#1383

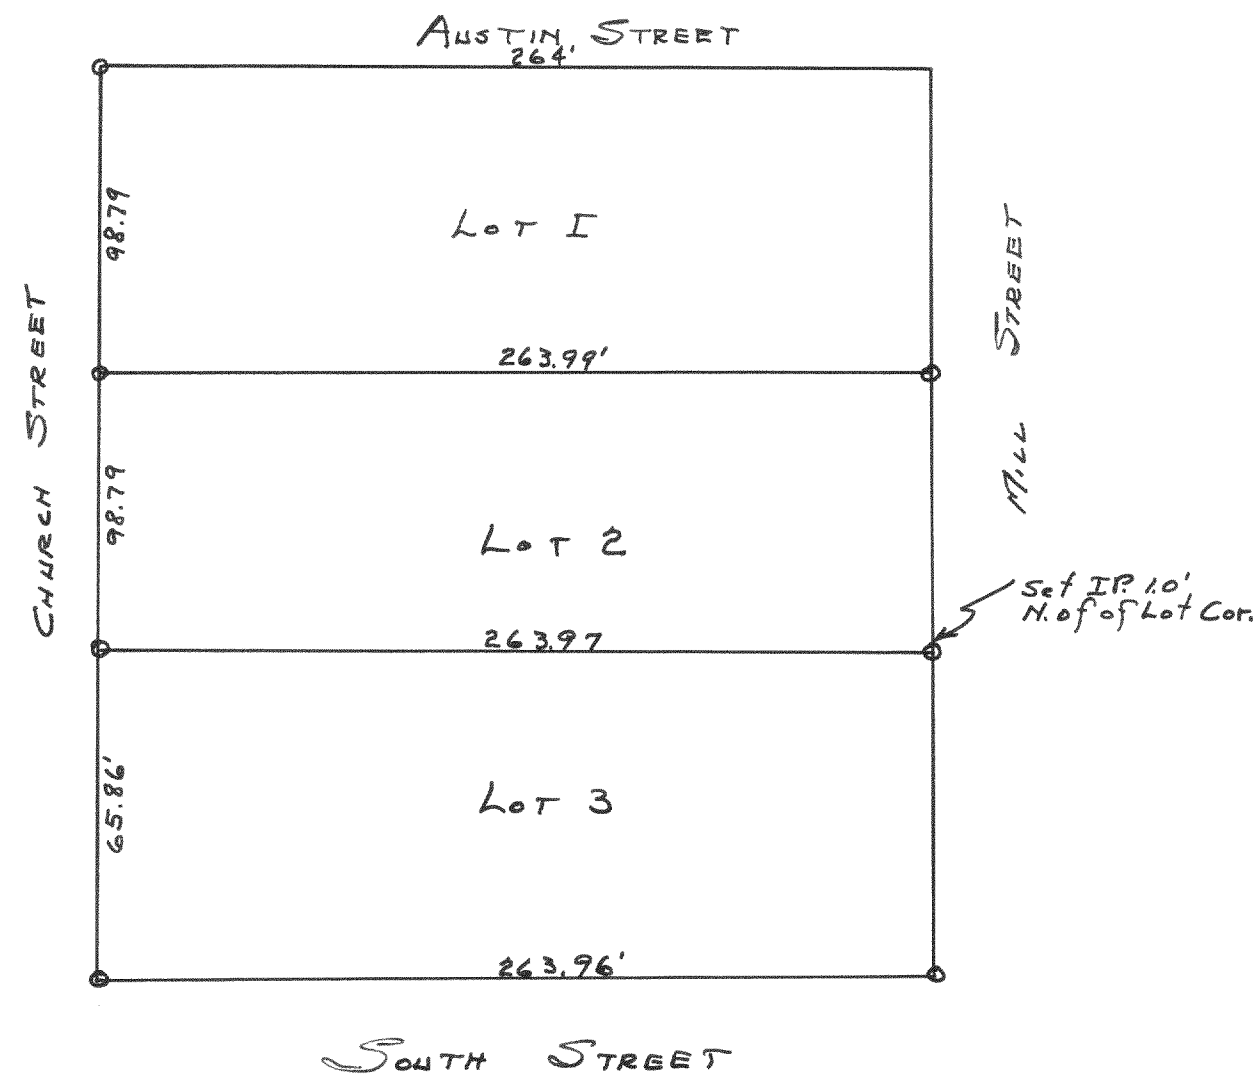

Plat of survey of Lot 2 of Bk. 15 of the Original Plat of the Village of East Troy Wis.

Aug. 1943

Lloyd L. Jensen
County Surveyor