



#1384

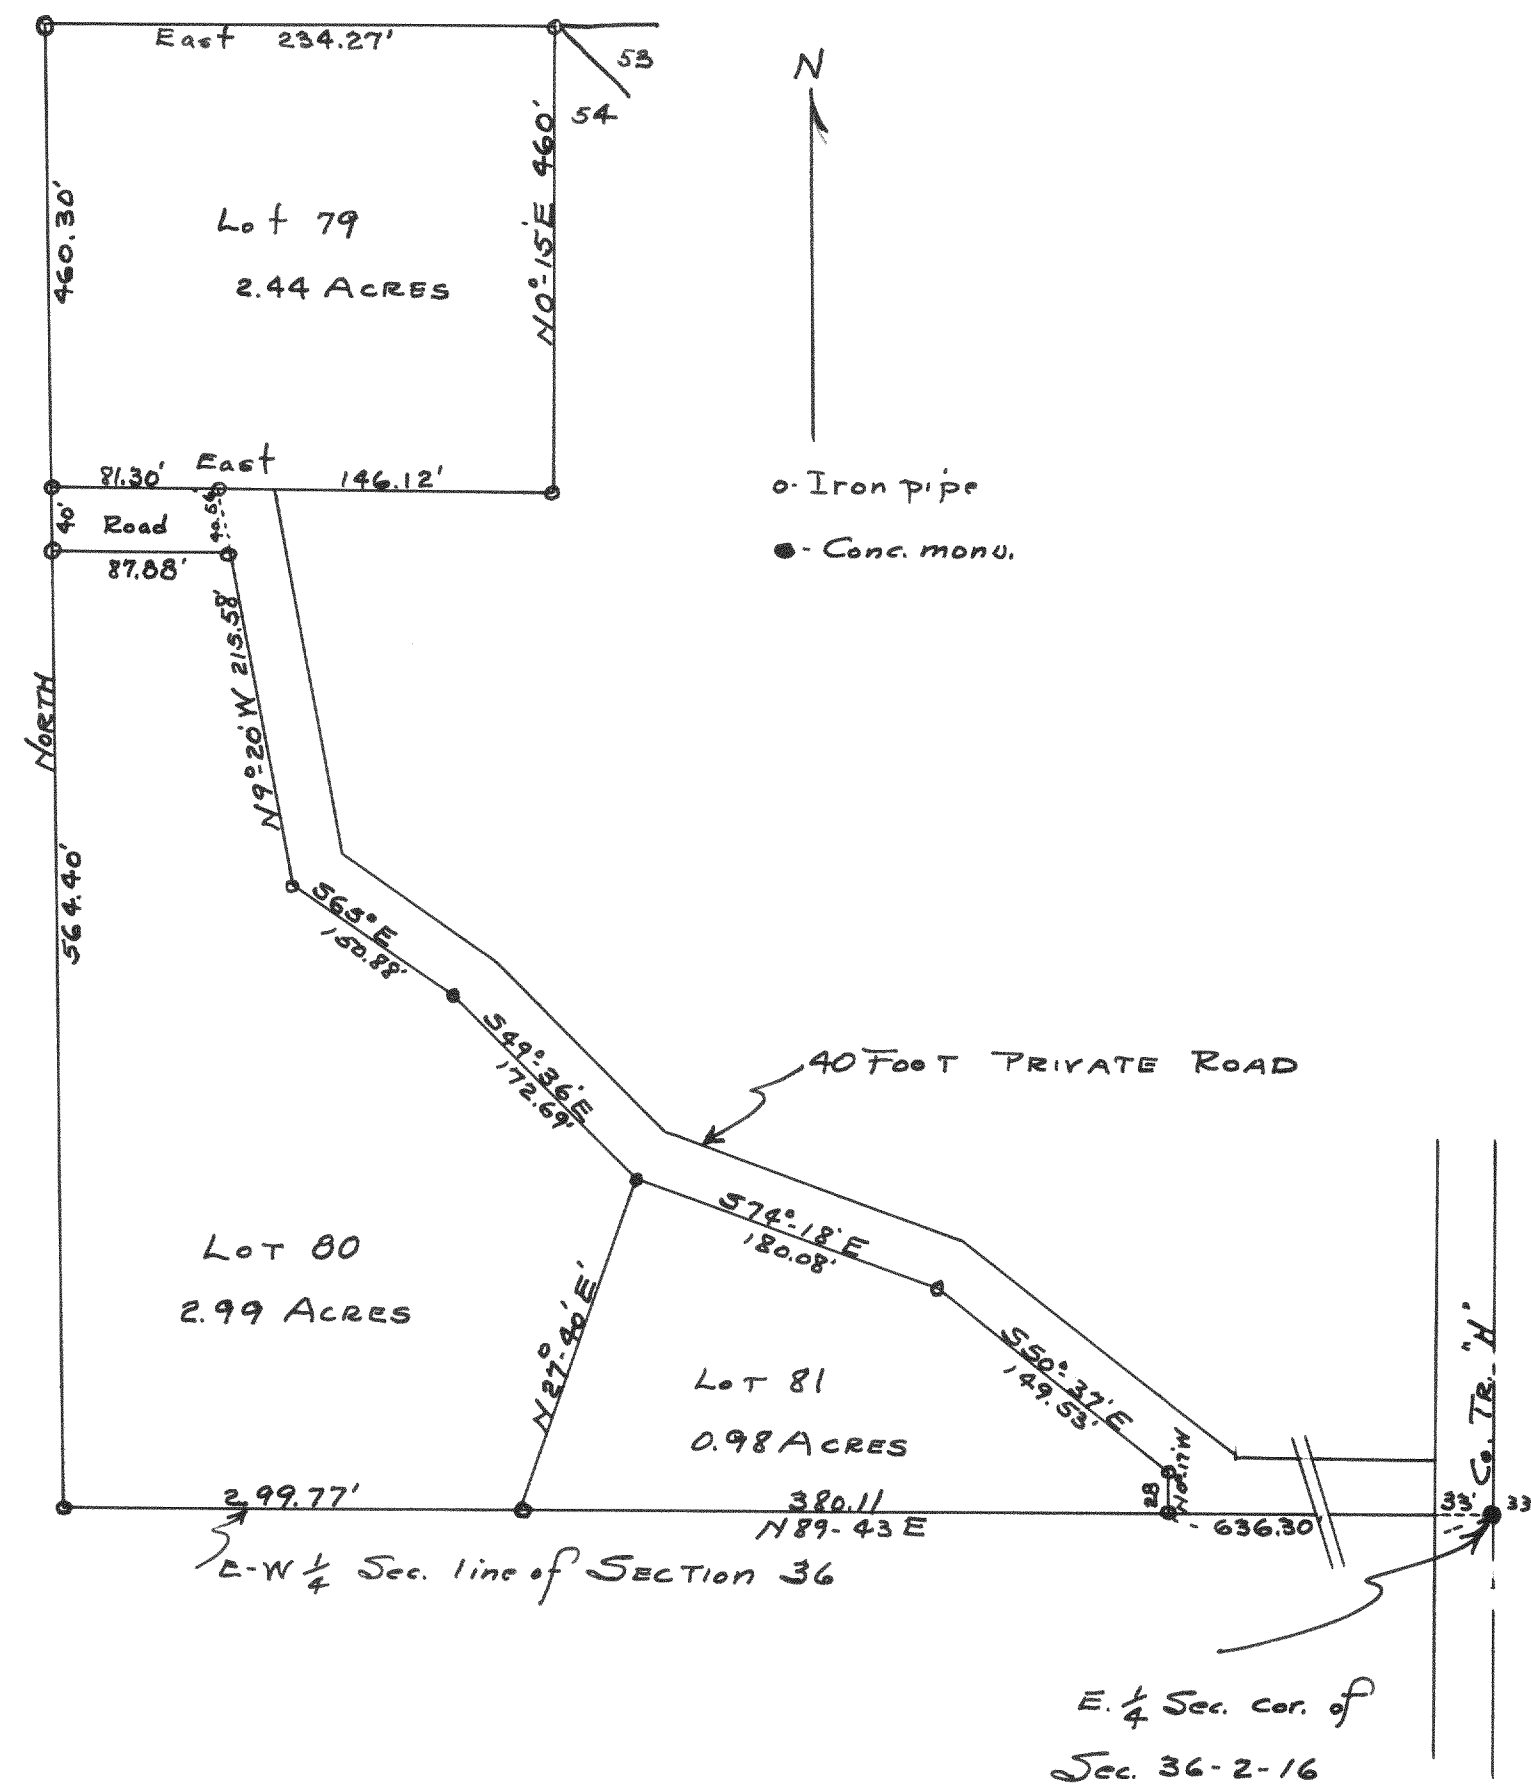

Plot of survey of land located in the
East $\frac{1}{2}$ of the Northeast $\frac{1}{4}$ of Section 36, T27N R16E.
June 1943
Lloyd D. Jensen
County Surveyor

#1385

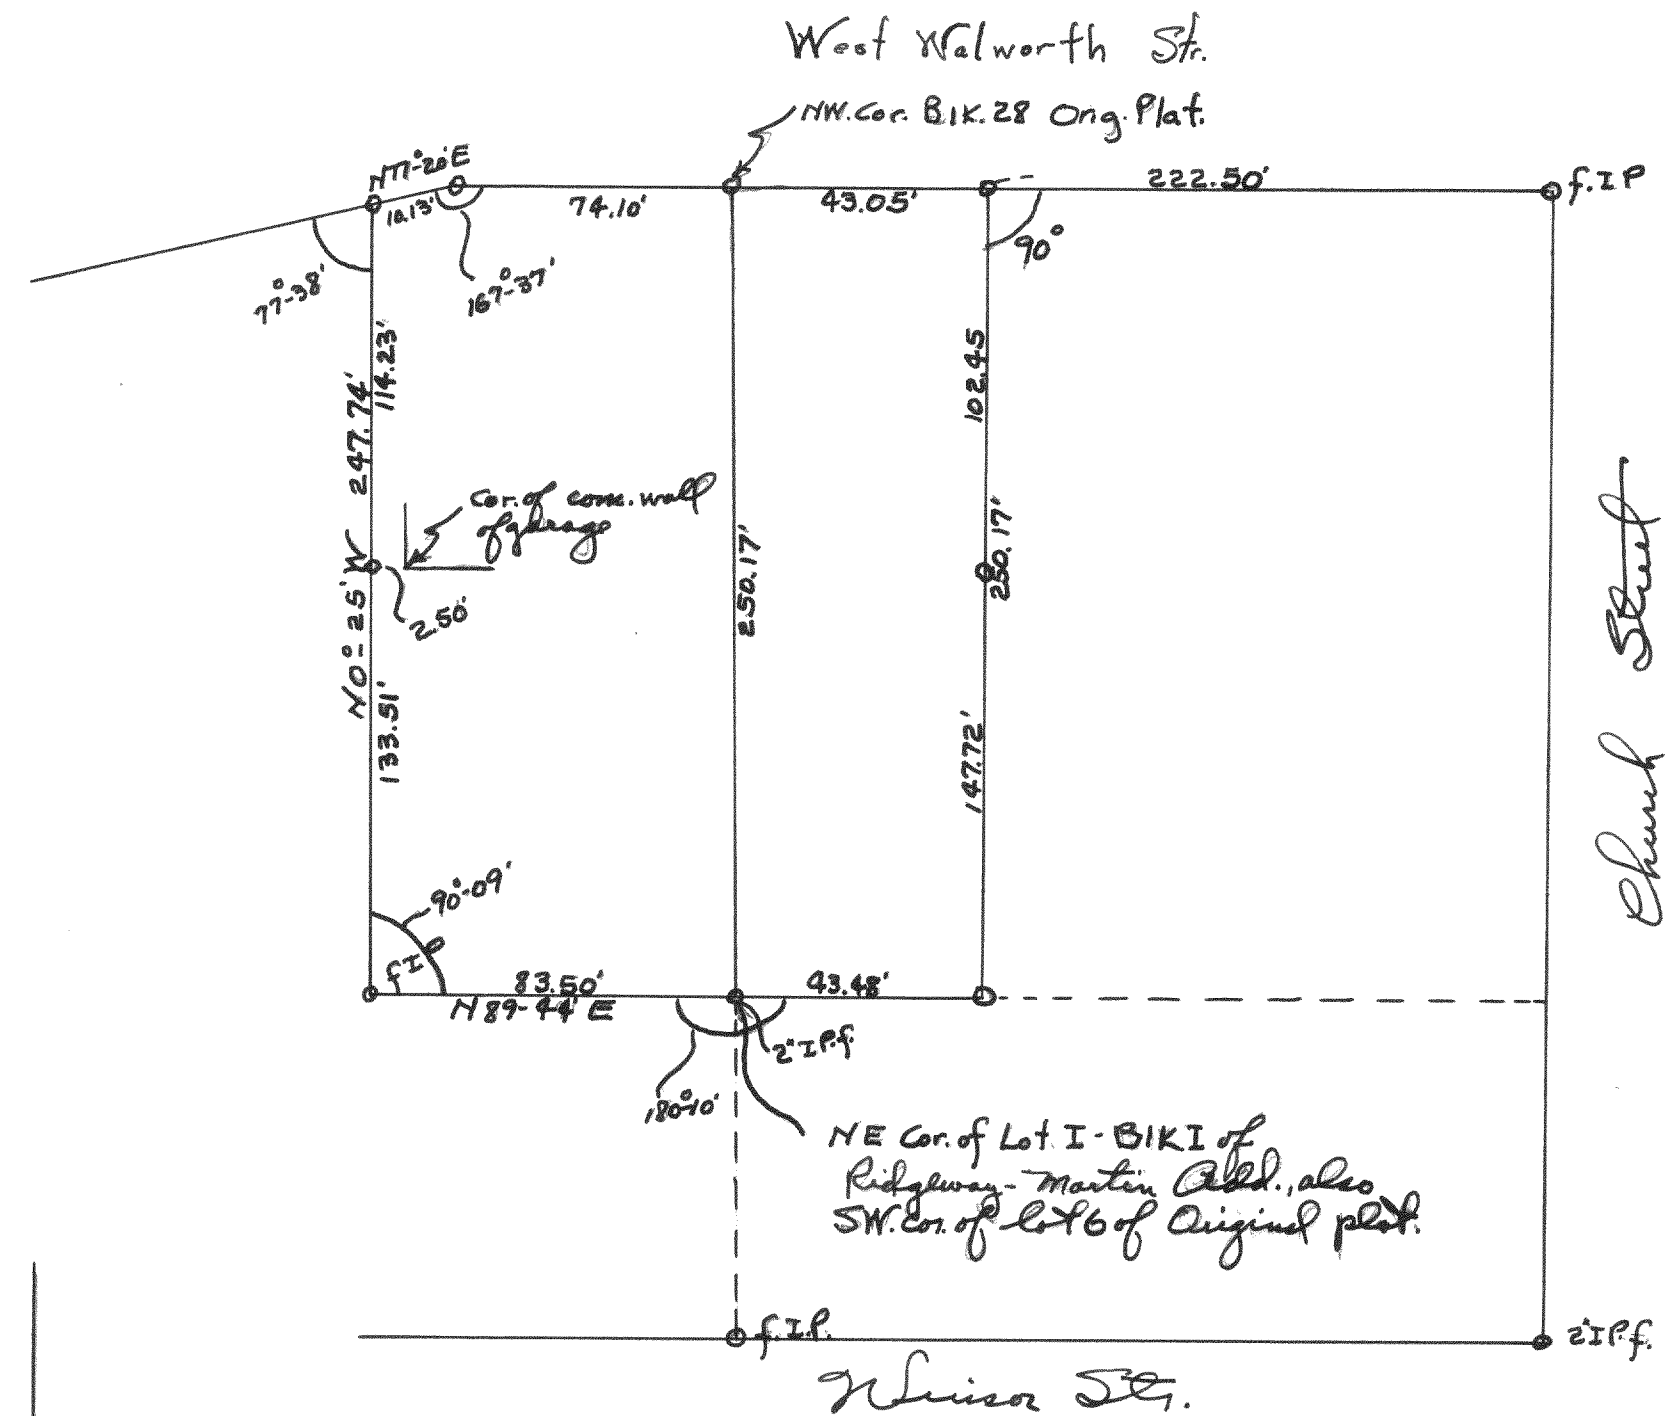

Plot of survey of the Mather property
on West Walworth Street in the City of
Elkhorn,
June 6, 1943
Lloyd D. Jensen
County Surveyor