



#1386

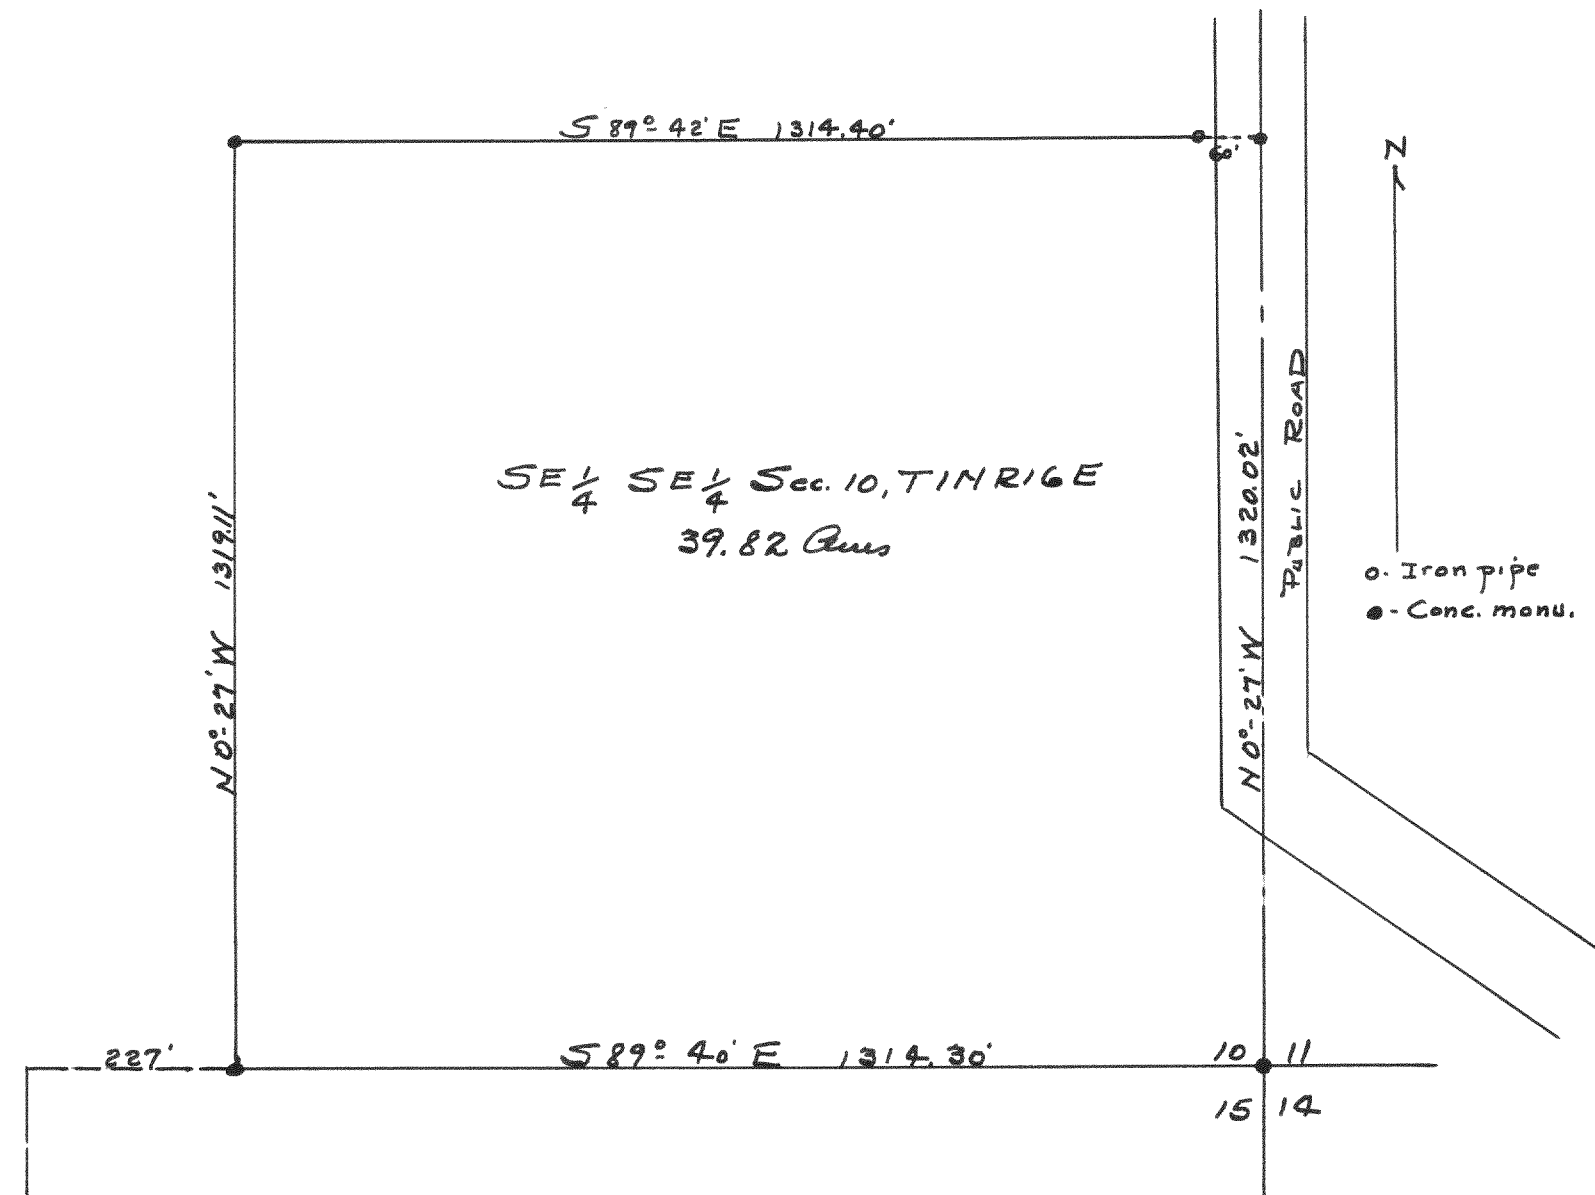

Plot of survey of land to be annexed to the
Village of Fontana, owned by the Village.
Aug. 1943
Floyd L. Jensen
County Surveyor

#1387

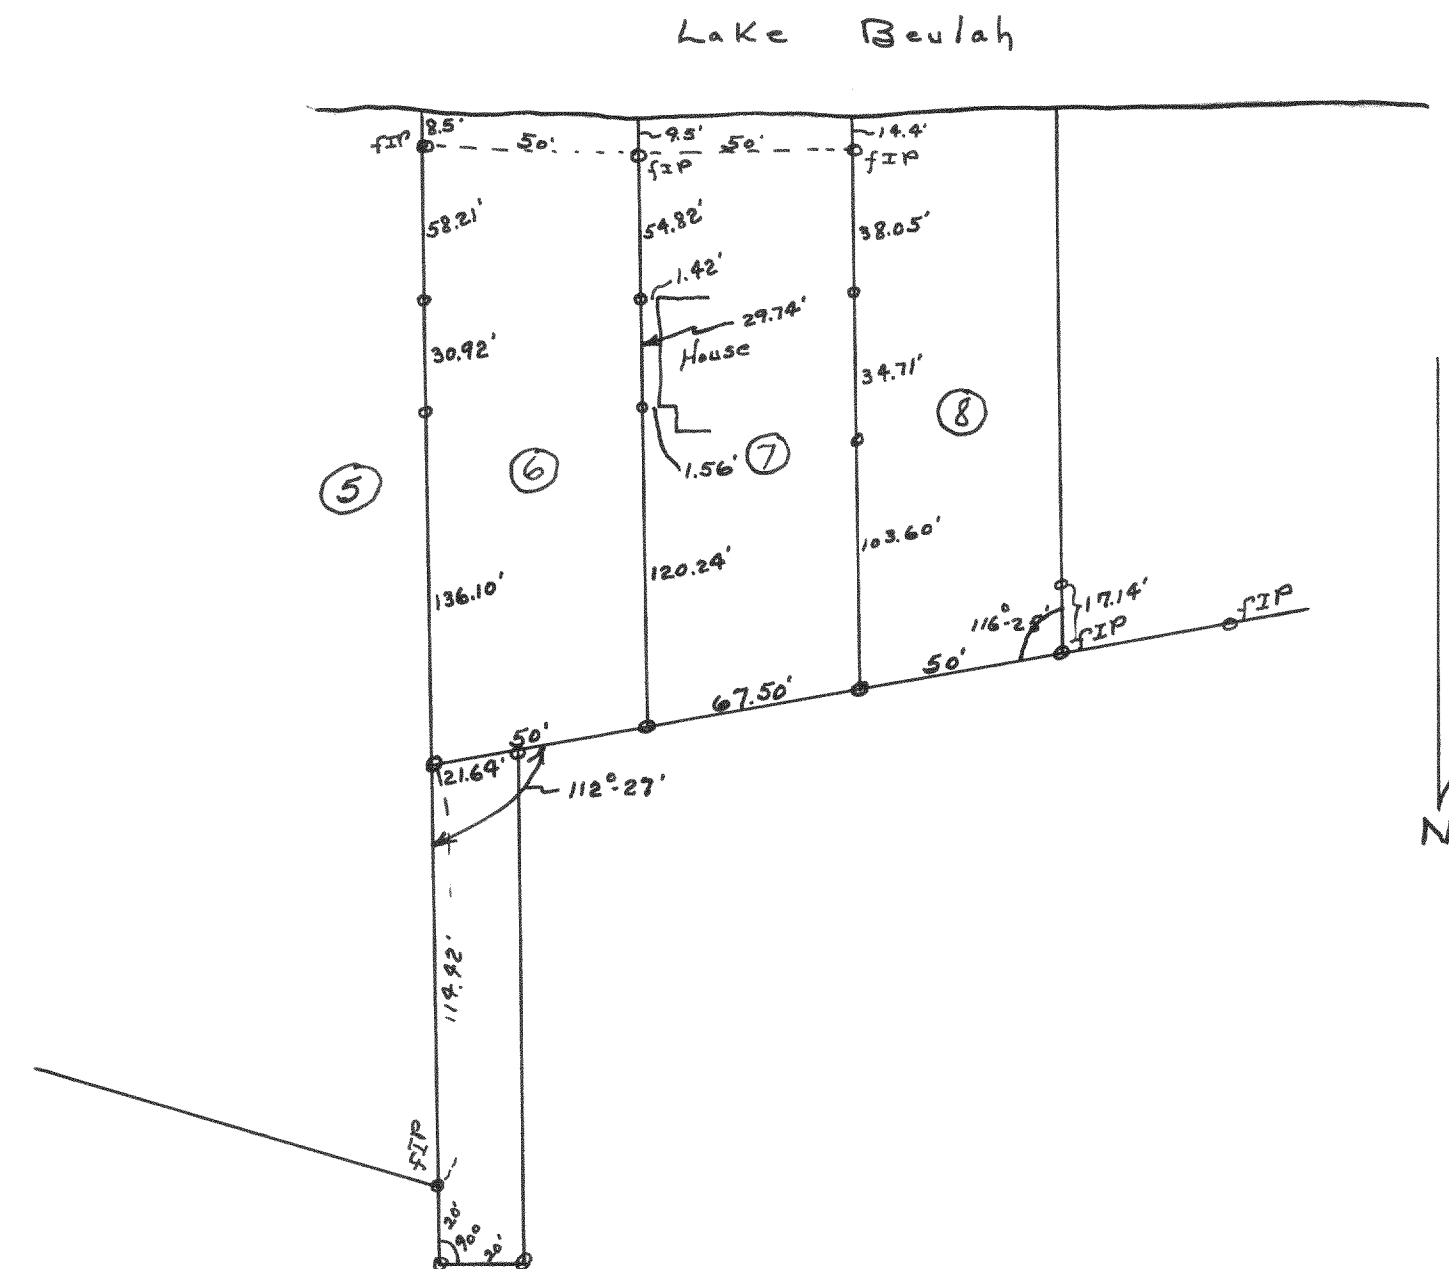

Plot of a survey of property in
Williams Park Subd. - Sec. 9, T4N R18E
to locate the lines of a private
road & the lines of unrecorded
Lots 6 and 7 of Sherman's Subd.

Aug. 1943
Floyd L. Jensen
County Surveyor