

#1430




Plat of survey of a parcel of land
located in the Northwest $\frac{1}{4}$ of Section 26,
T19N R17E.

Sept. 1943

Lloyd L. Jensen
County Surveyor.

#1431

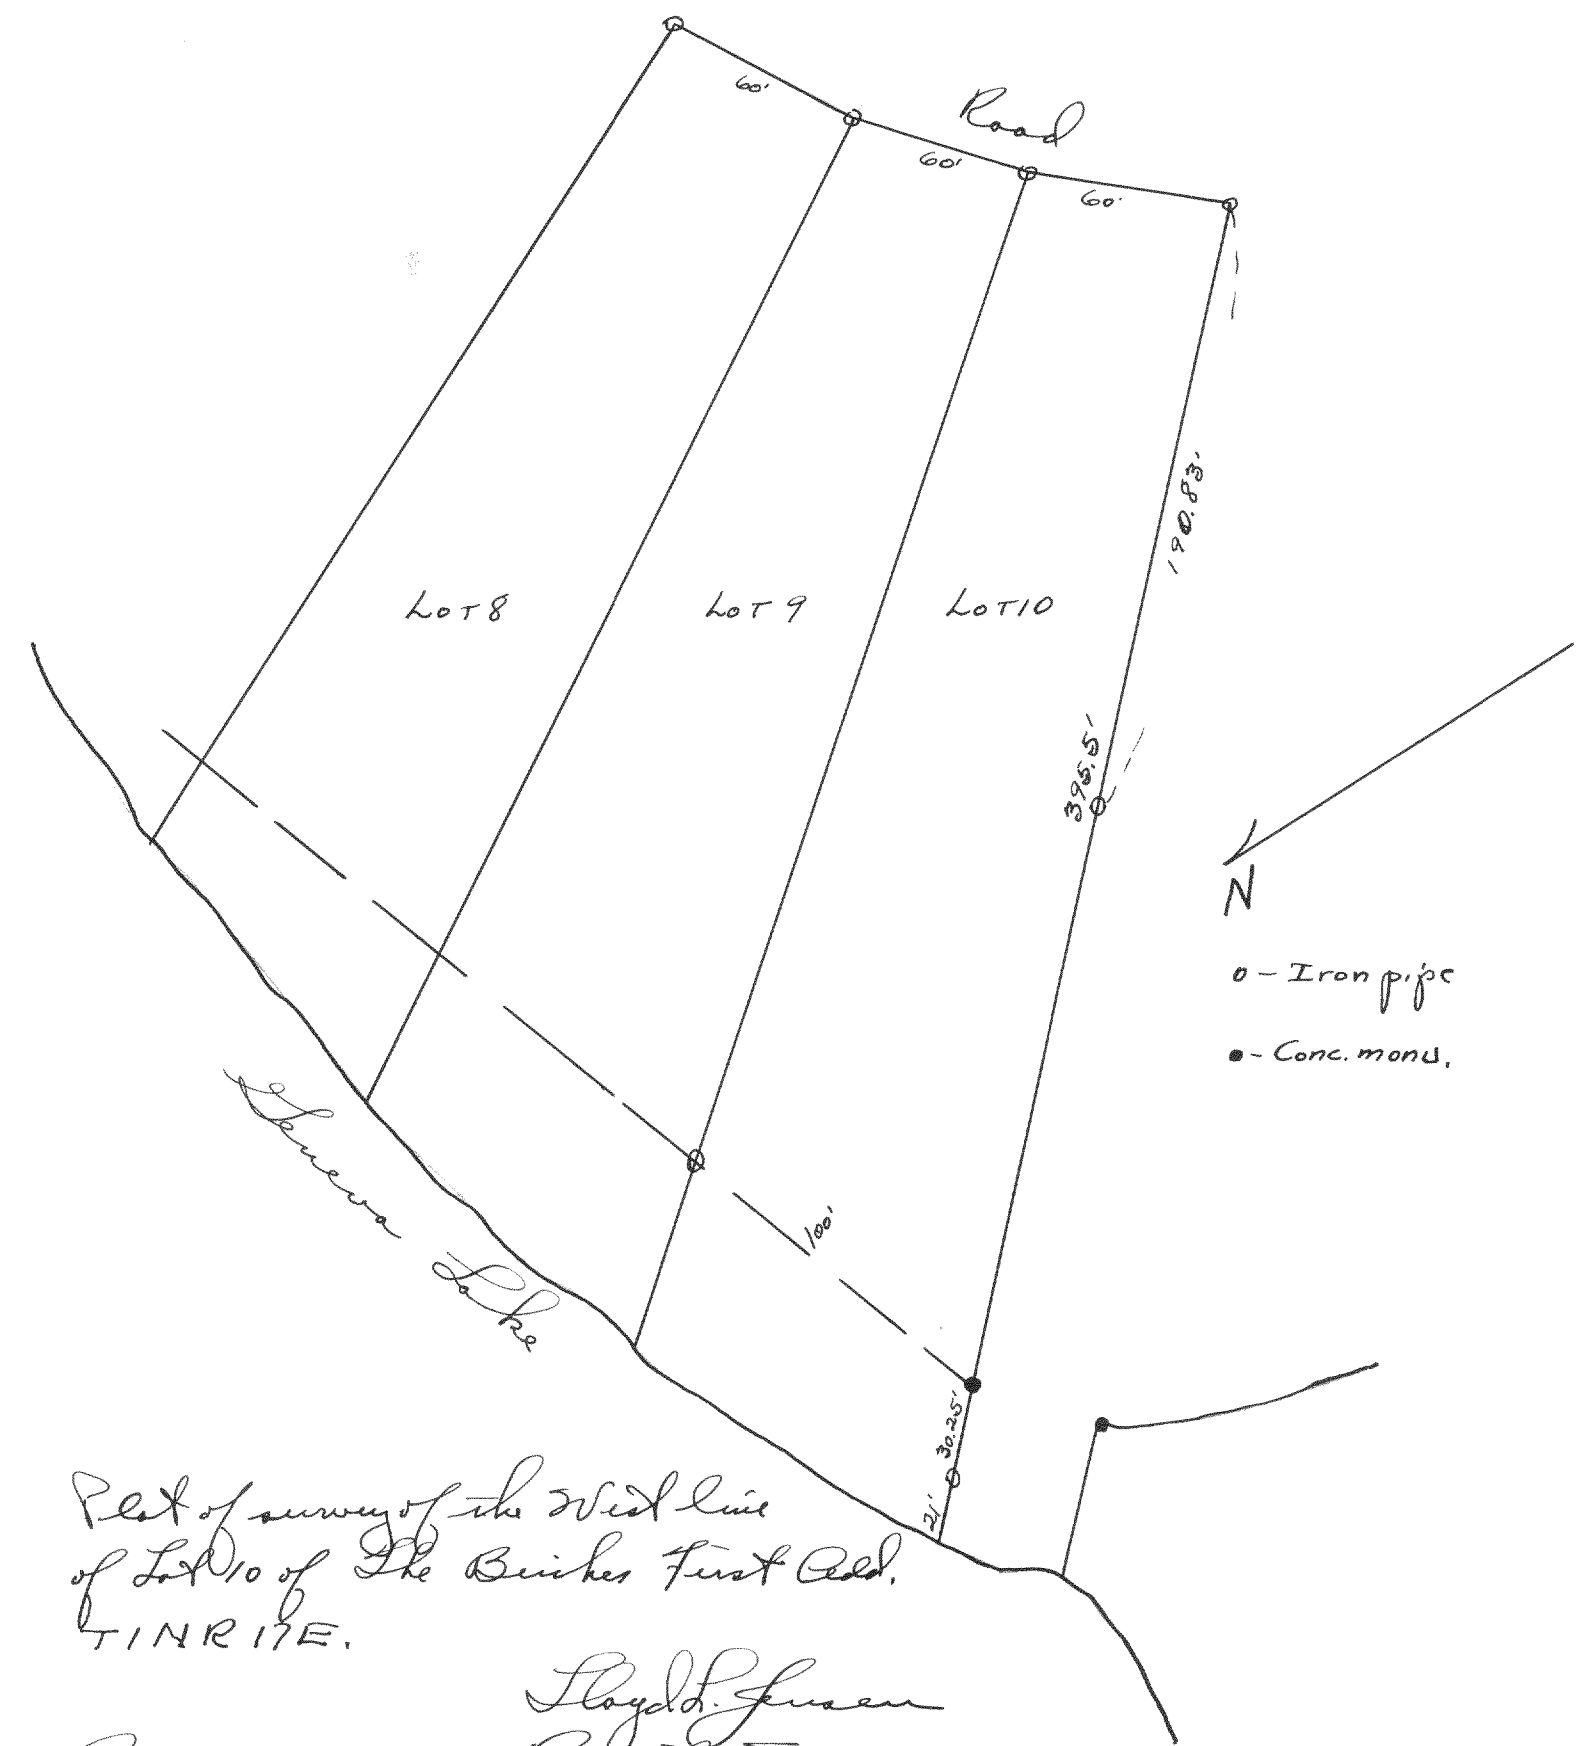

Plat of survey of the West line
of Lot 10 of The Buickers First Add.,
T19N R17E.

Aug. 1943

Lloyd L. Jensen
County Surveyor.