


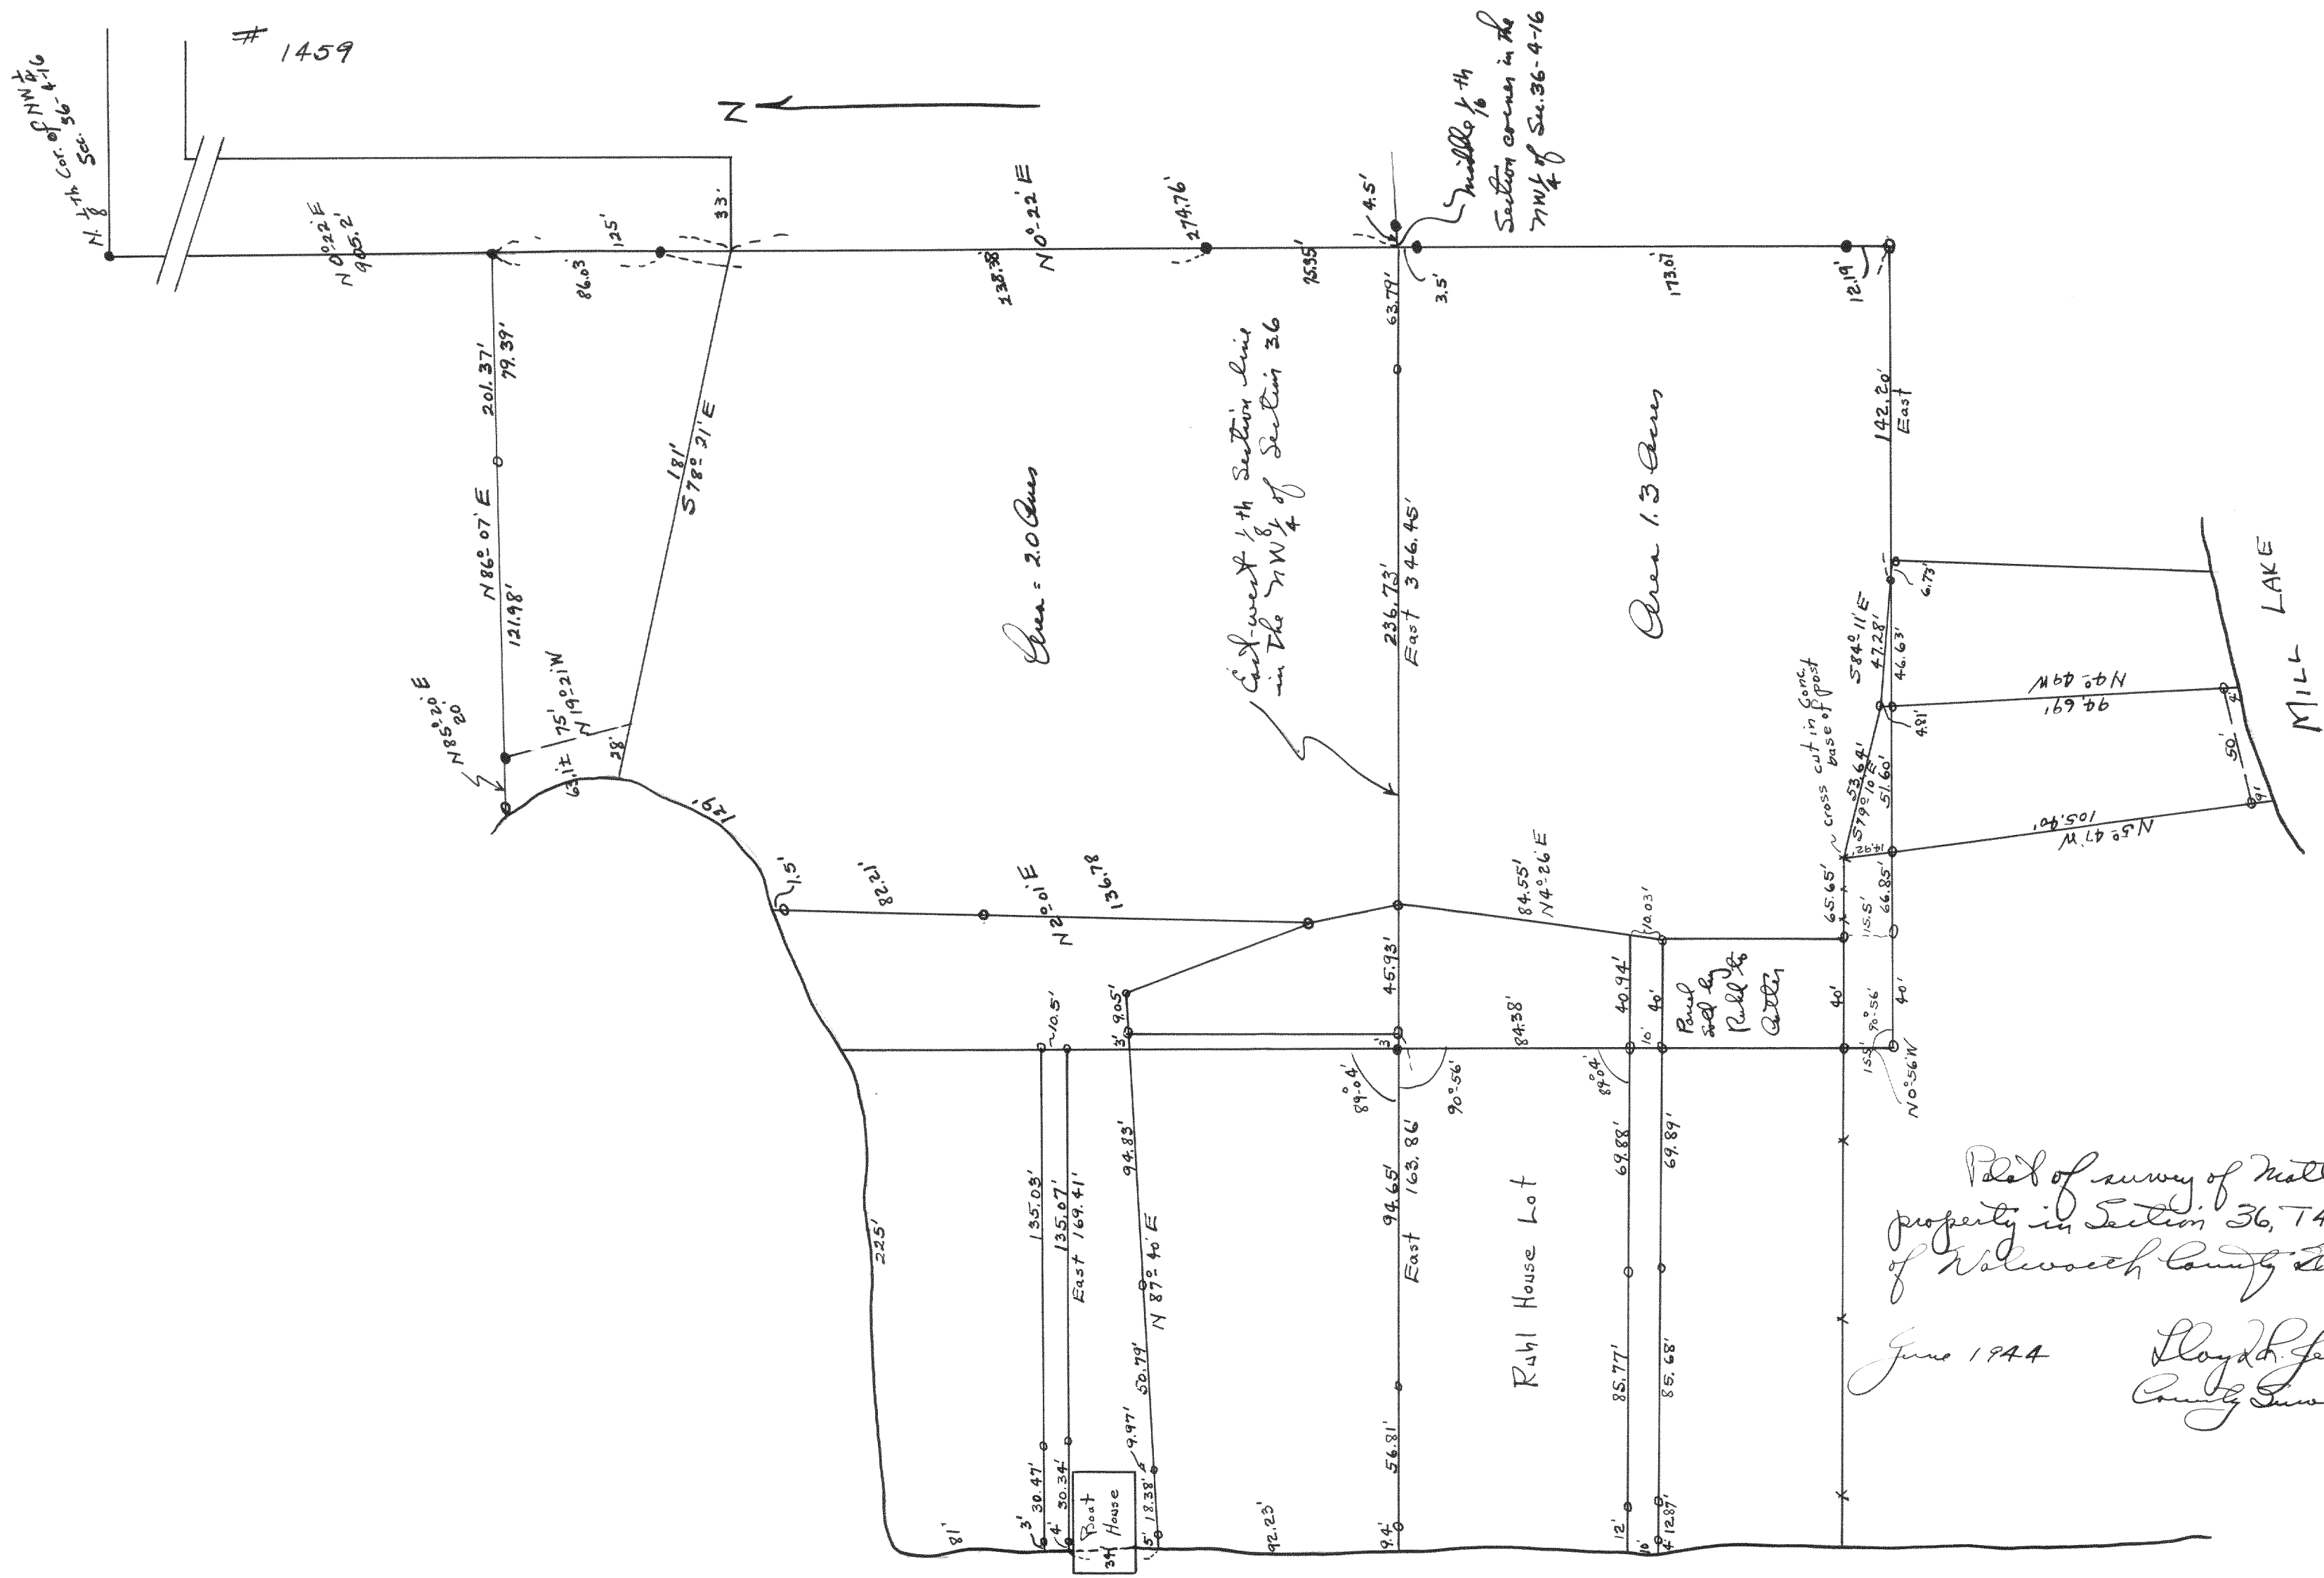

Plot of survey of Mallets
property in Section 36, T47N R16E
of Walworth County, Wisconsin

June 1944

Lloyd Jensen
County Surveyor