


#1477

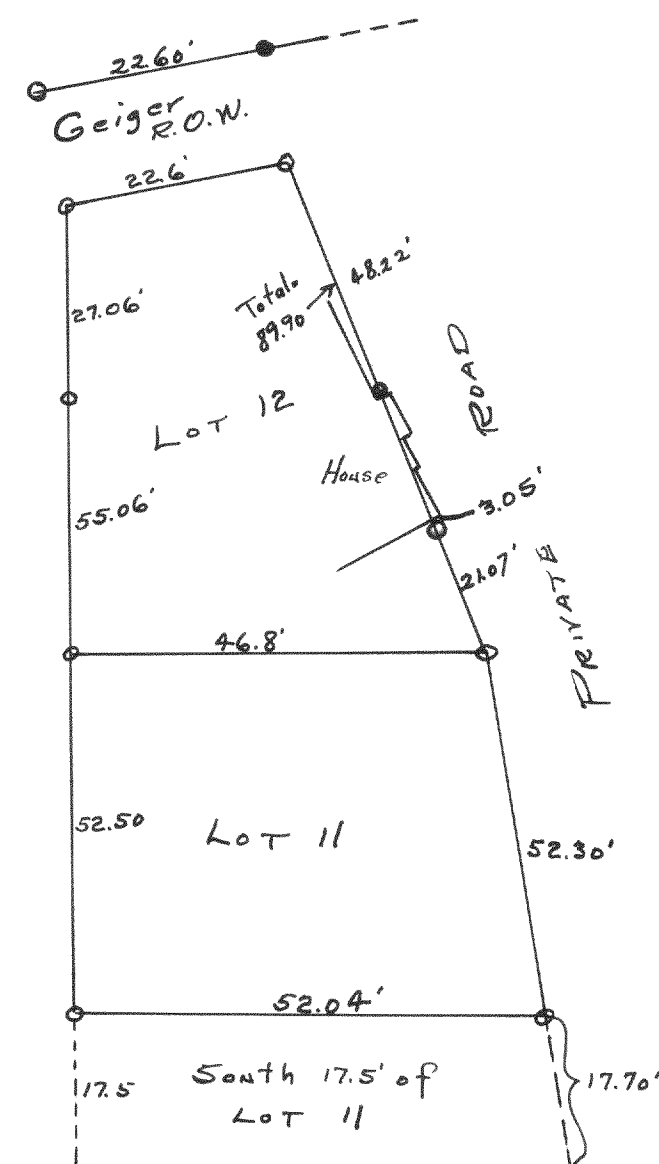


Plot of survey of Lot 12 and part of Lot 11 of the Addition to Willow Point Park, a Subdivision located in Section 29, T27 R16 E of Walworth County Wisconsin.

Aug. 1944

Lloyd L. Jensen
County Surveyor

#1478

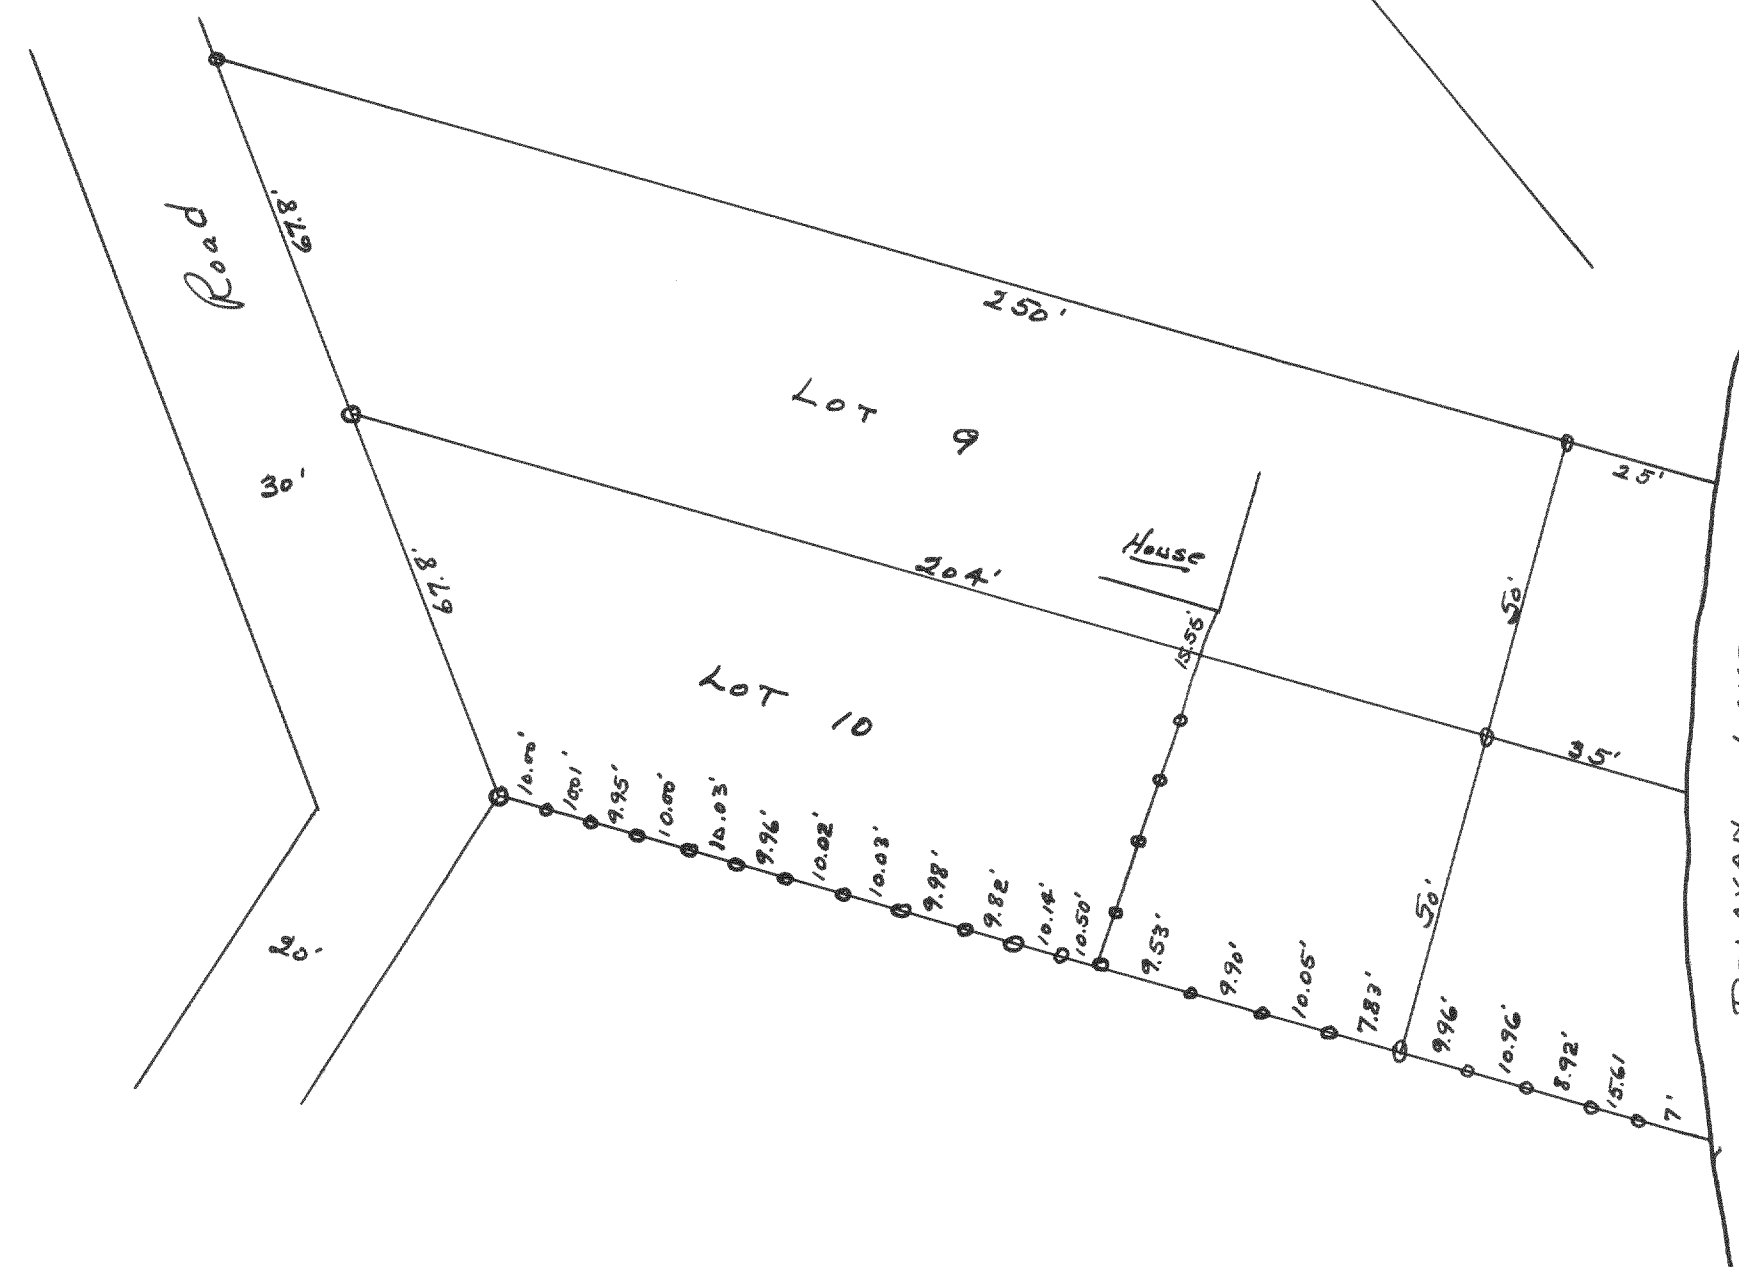

Plot of survey of Lot 10 of Willow Point Park Subdivision, located in Fractional Section 29, T27 R16 E of Walworth County Wisconsin.

Aug. 1944

Lloyd L. Jensen
County Surveyor