


#1483

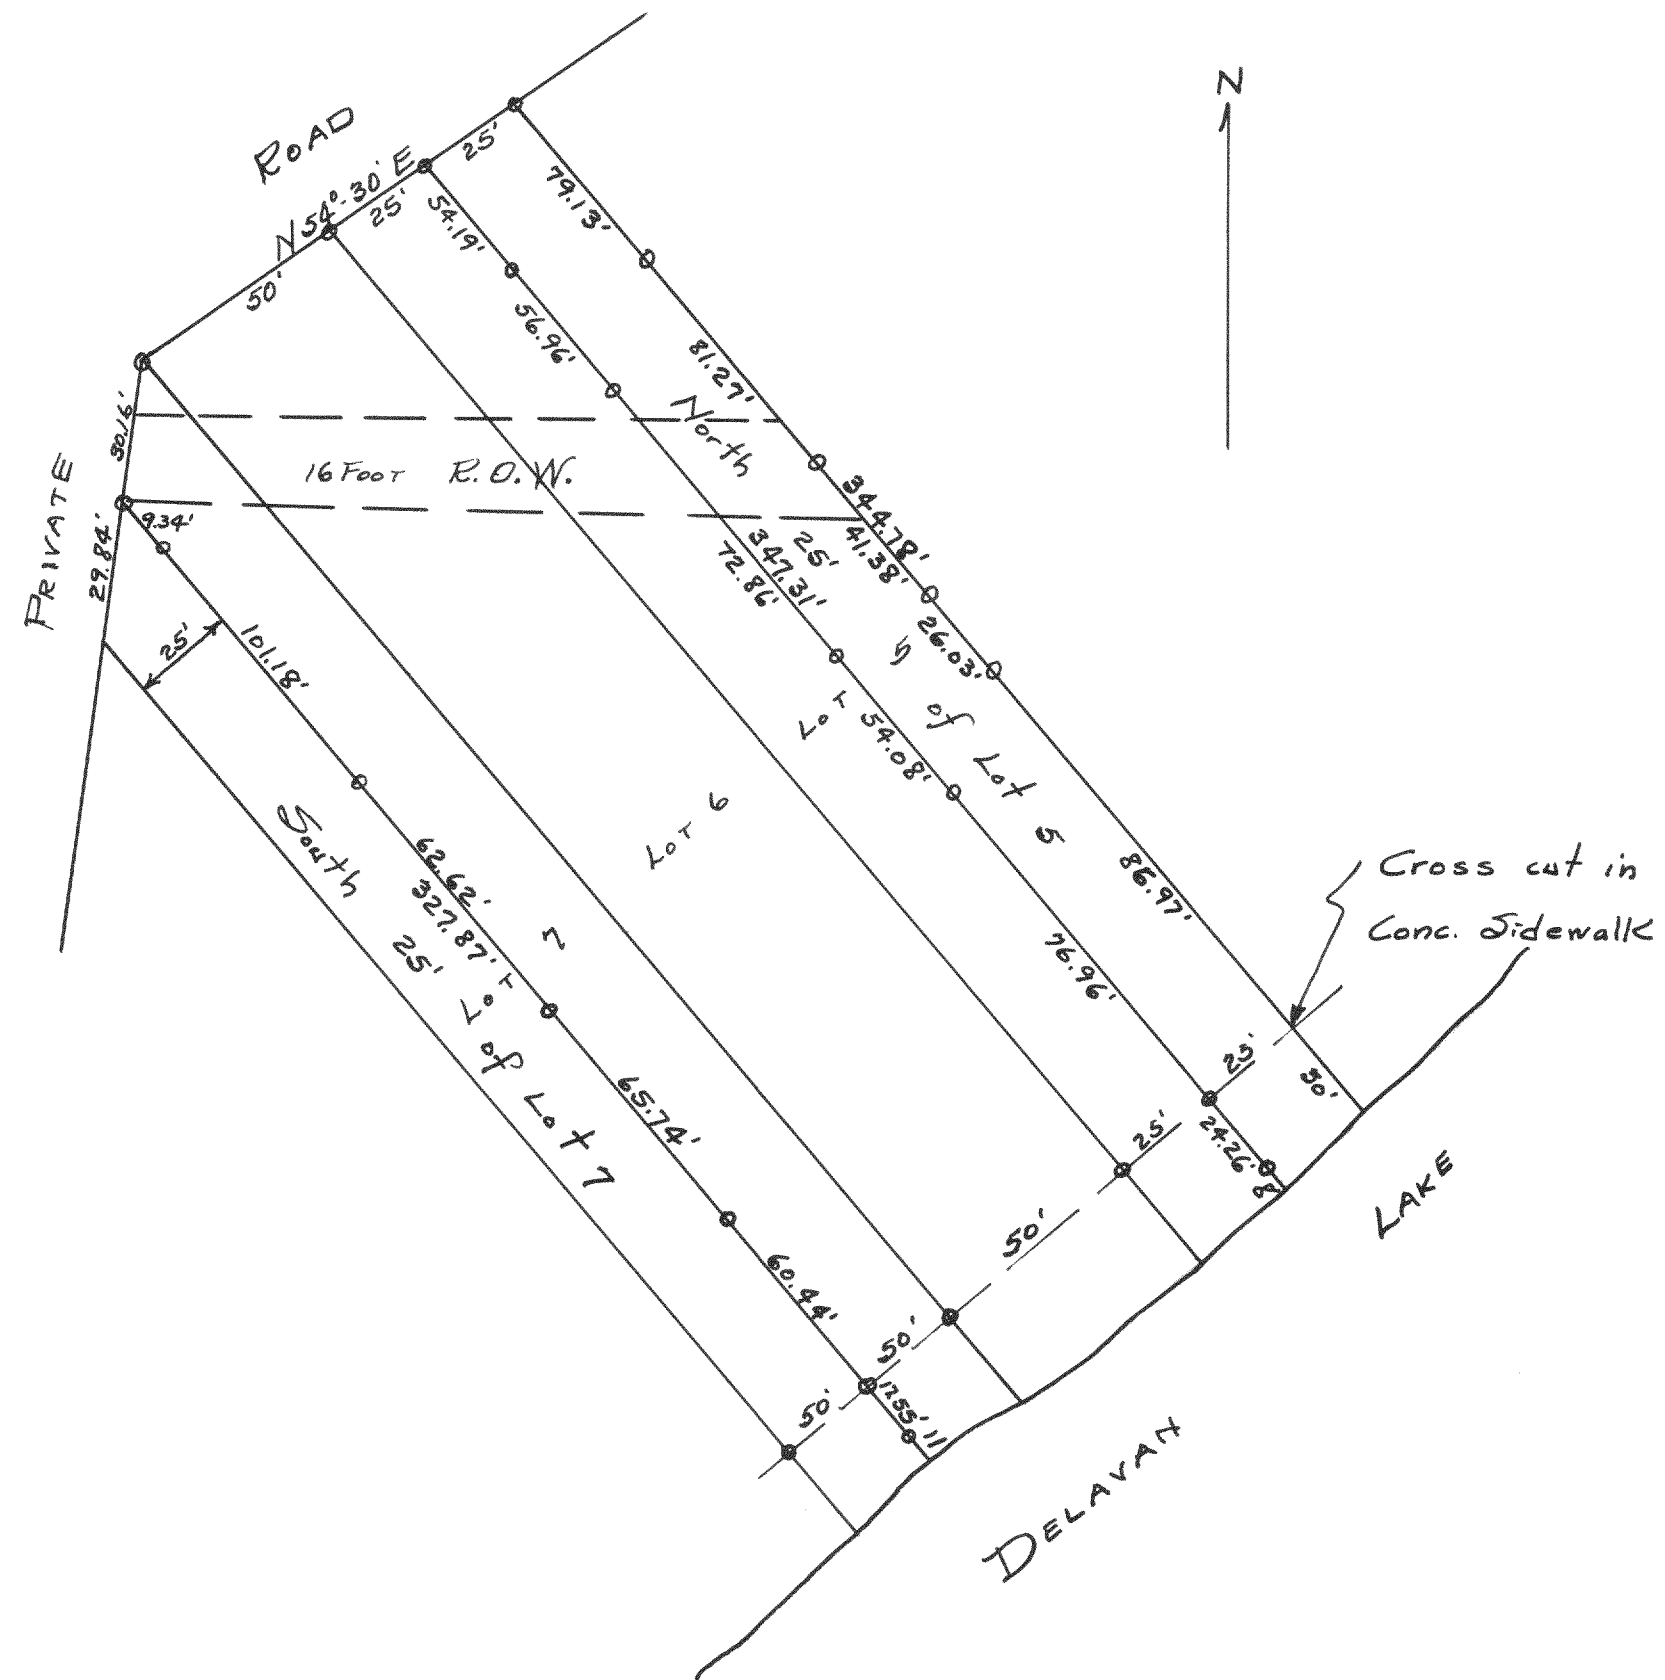


Plot of survey of lot lines in Willow Point Park Subdivision, located in Section 29, T2N R16E of Walworth County Wisconsin.

June 1944

Lloyd L. Jensen
County Surveyor

#1484

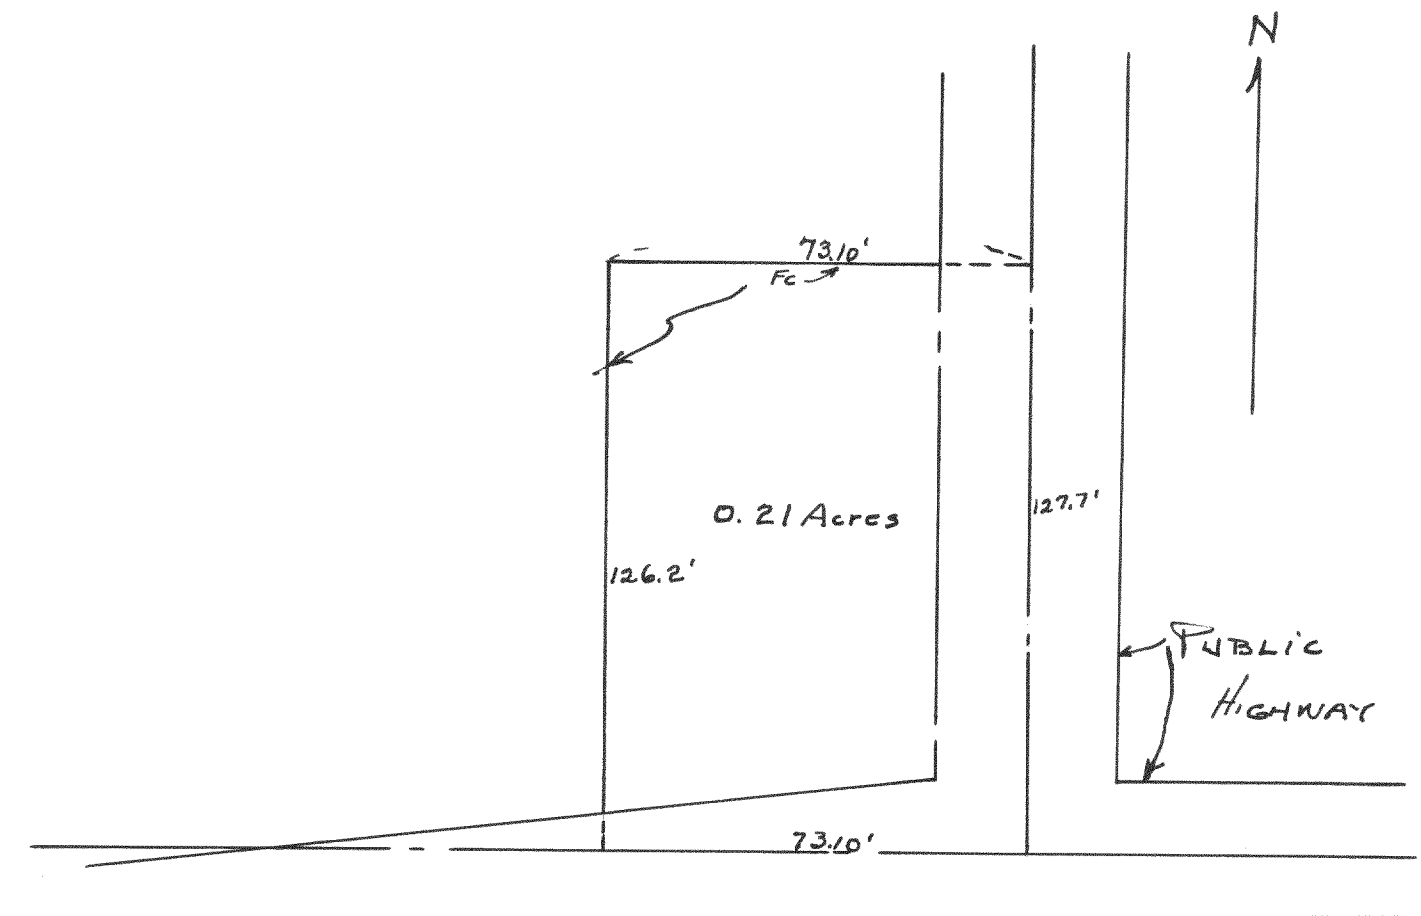

Plot of survey of a house lot located in the NW 1/4 of the NE 1/4 of Section 34, T3N R16E, used fences for line & E of highway fences.
July 1944

Lloyd L. Jensen
County Surveyor