



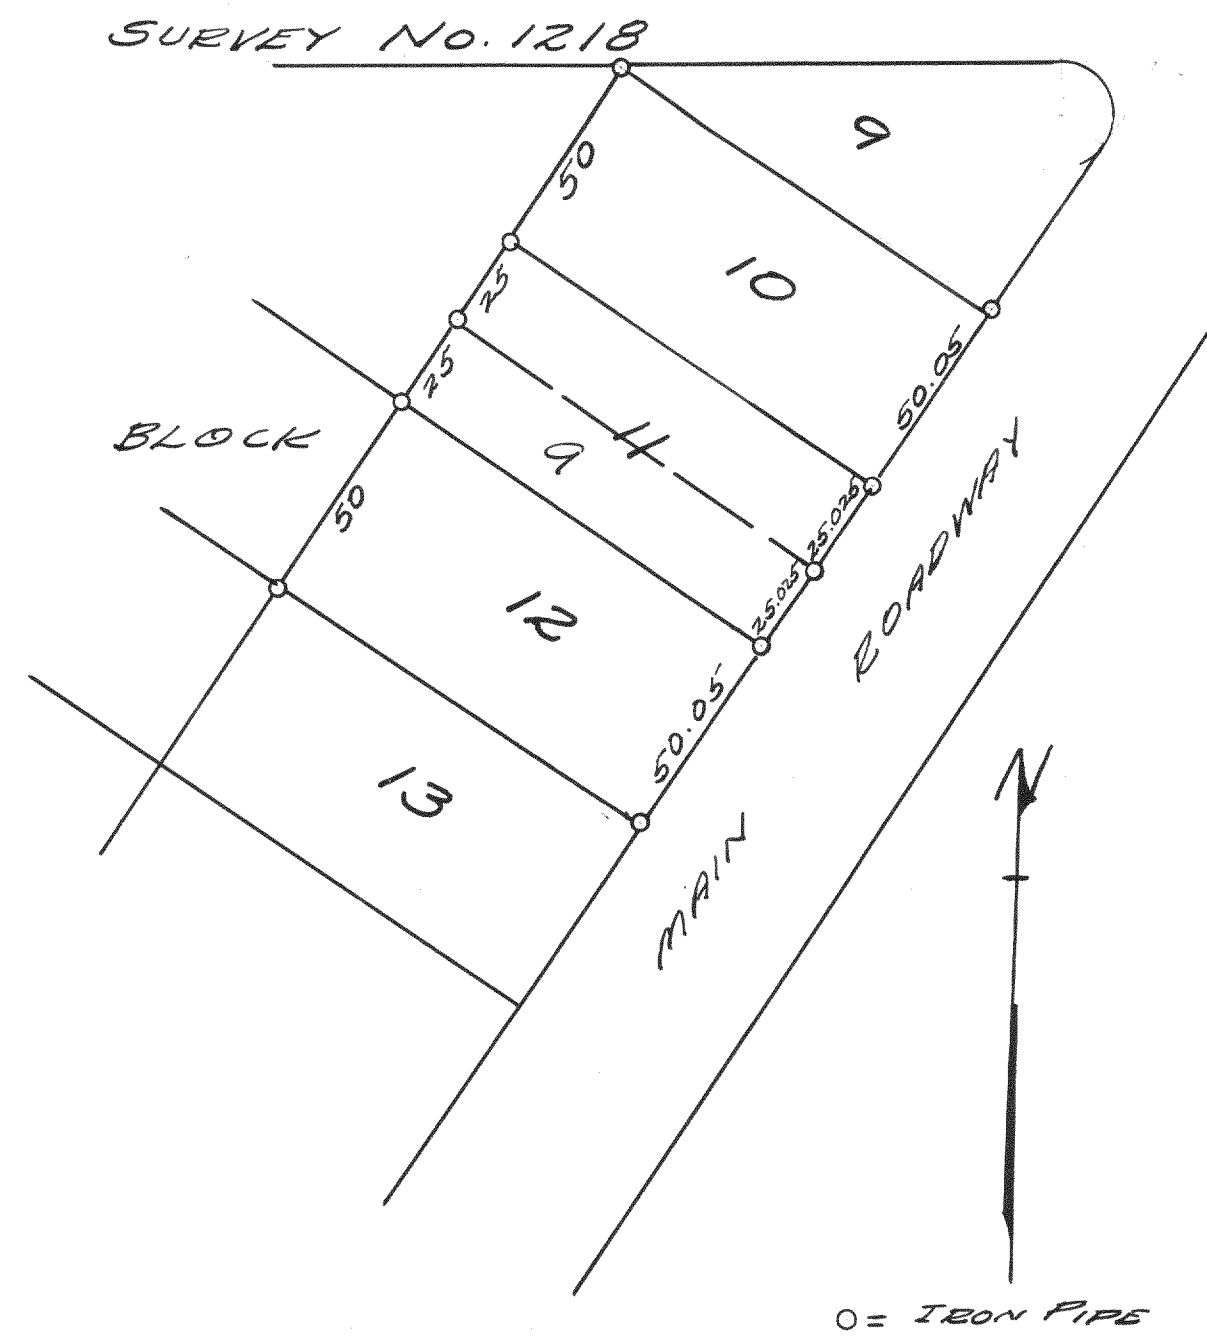

PLAT OF SURVEY OF LOTS 10, 11 & 12, OF
BLOCK 9 OF SUNSET HILLS SUBDIVISION,
LOT 11 WAS DIVIDED.

JUL 22, 1941

Lloyd F. Jensen
D.E.J.

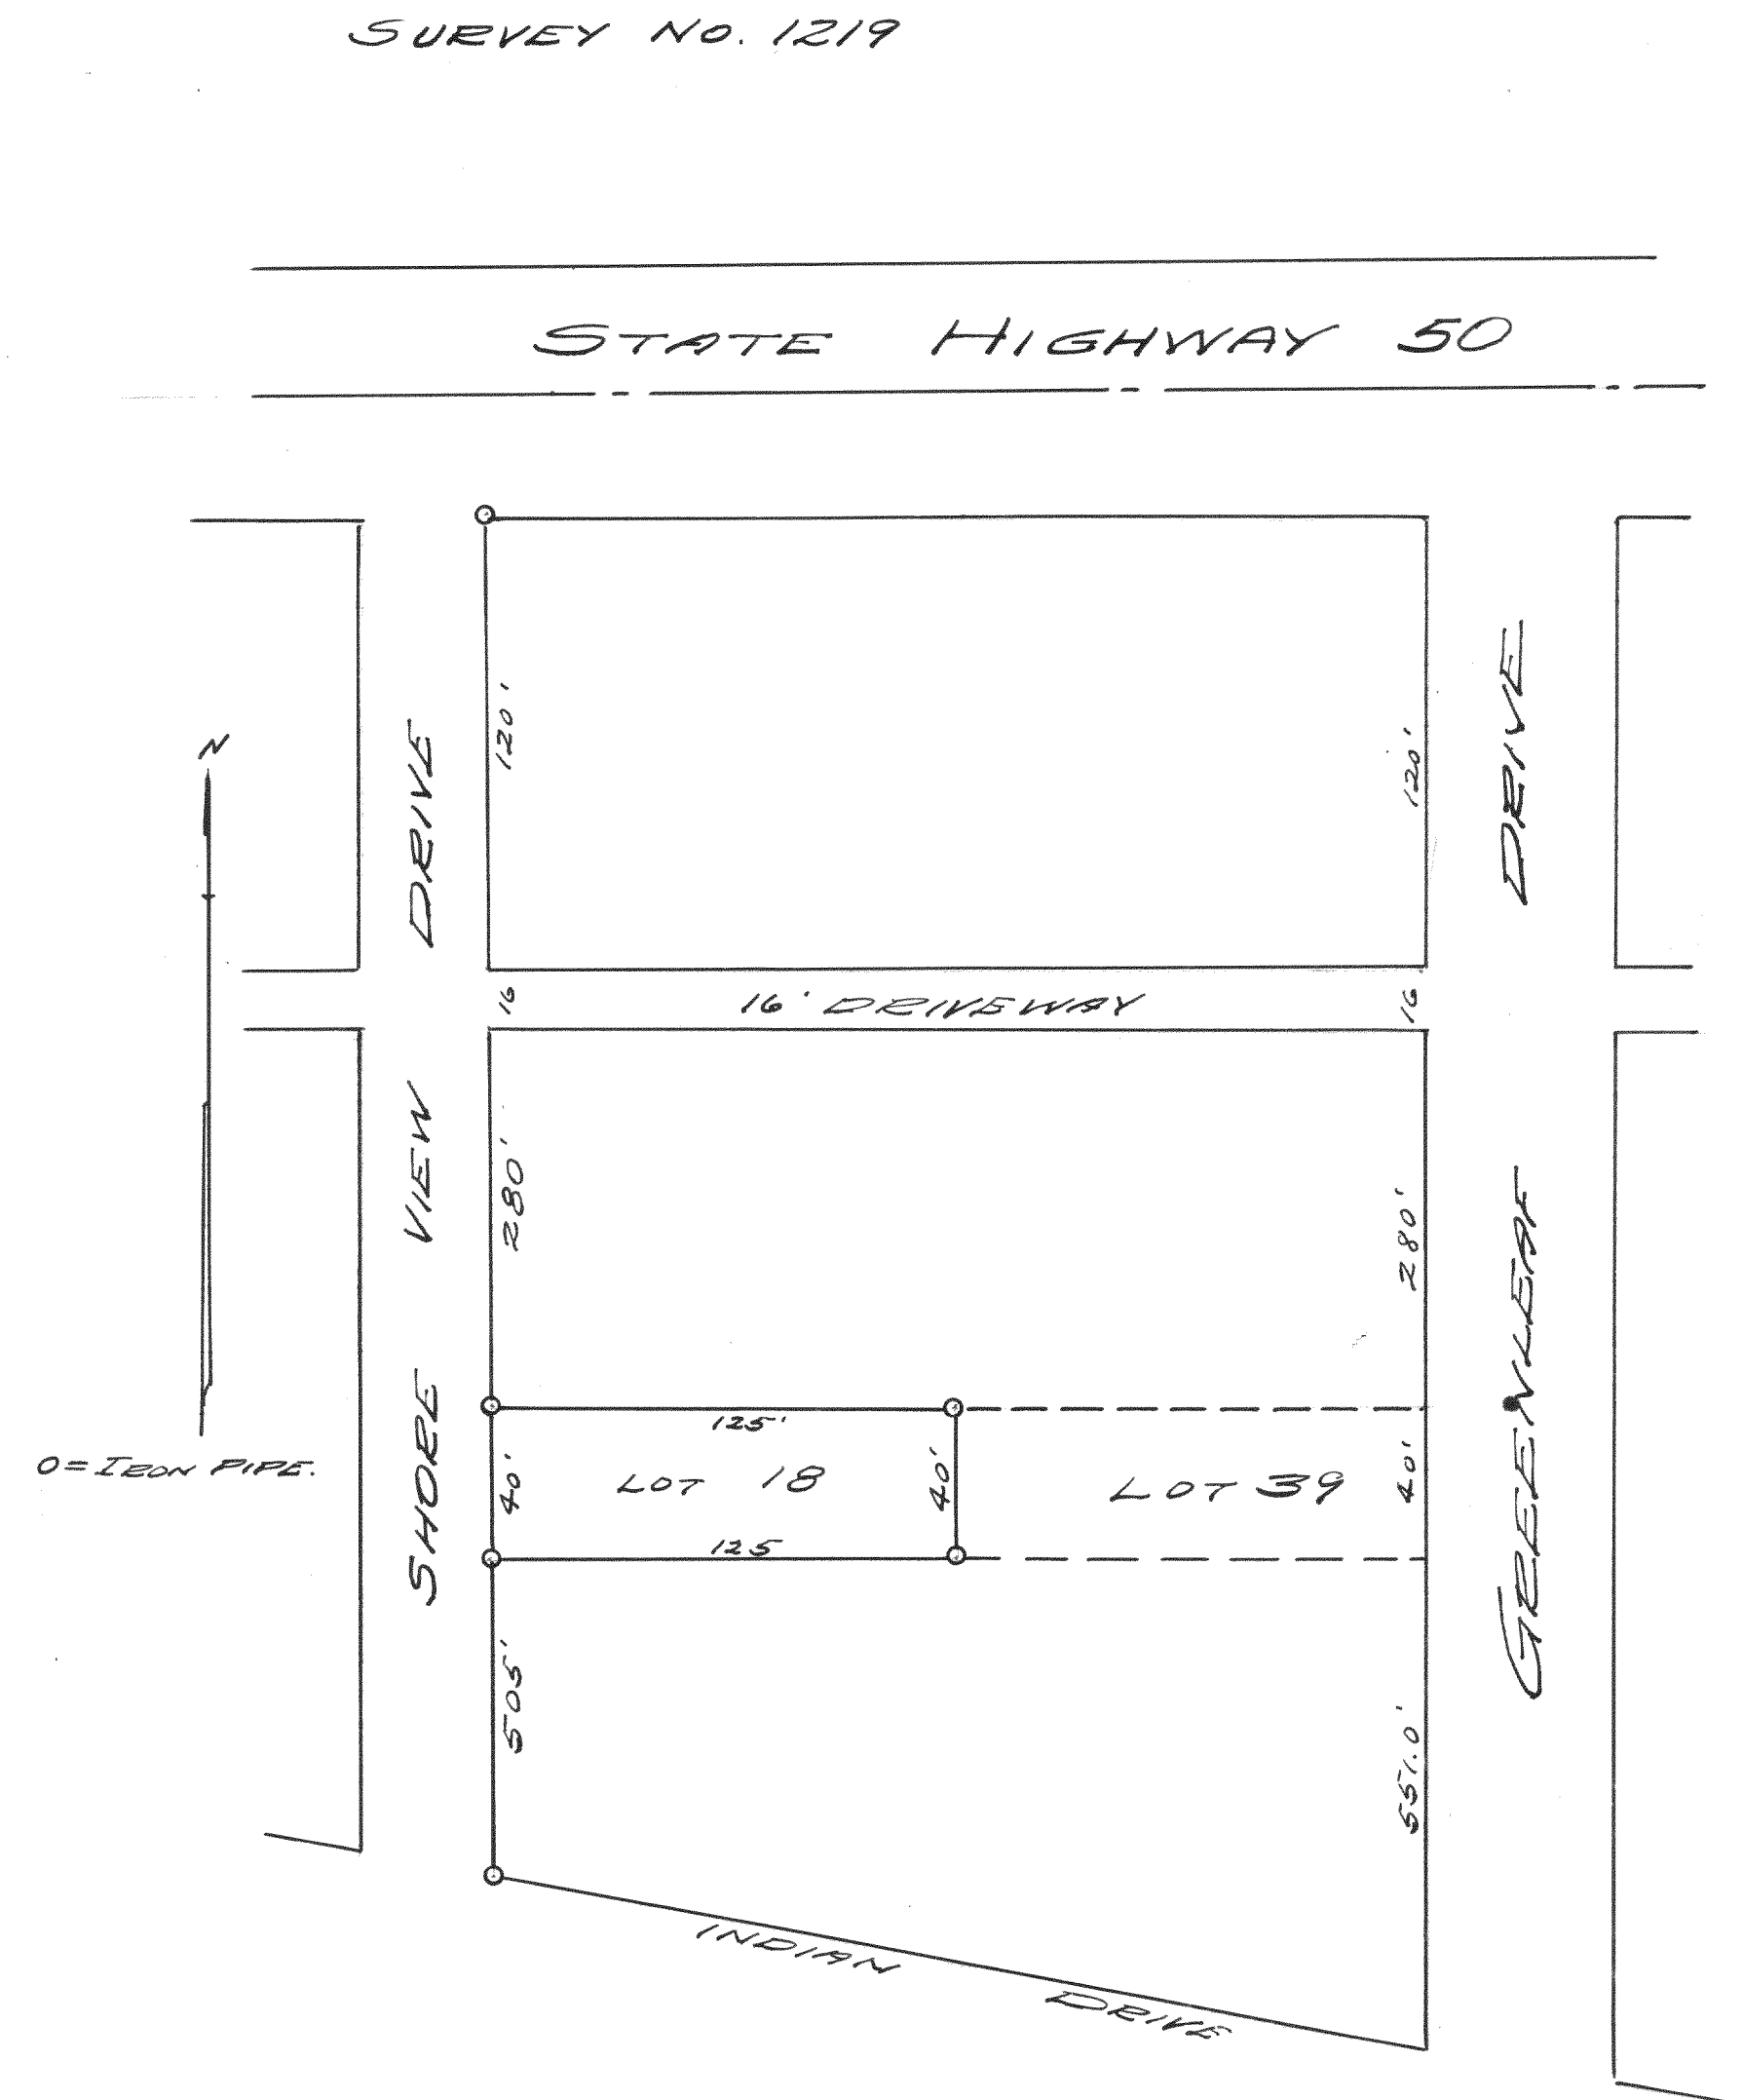

PLAT OF SURVEY OF LOT 18 BLOCK "I"
CISCO BEACH SUBD., WAUKESHA CO., WISC.

MARCH 8, 1941

Lloyd L. Jensen
H. E. B.