


#1528

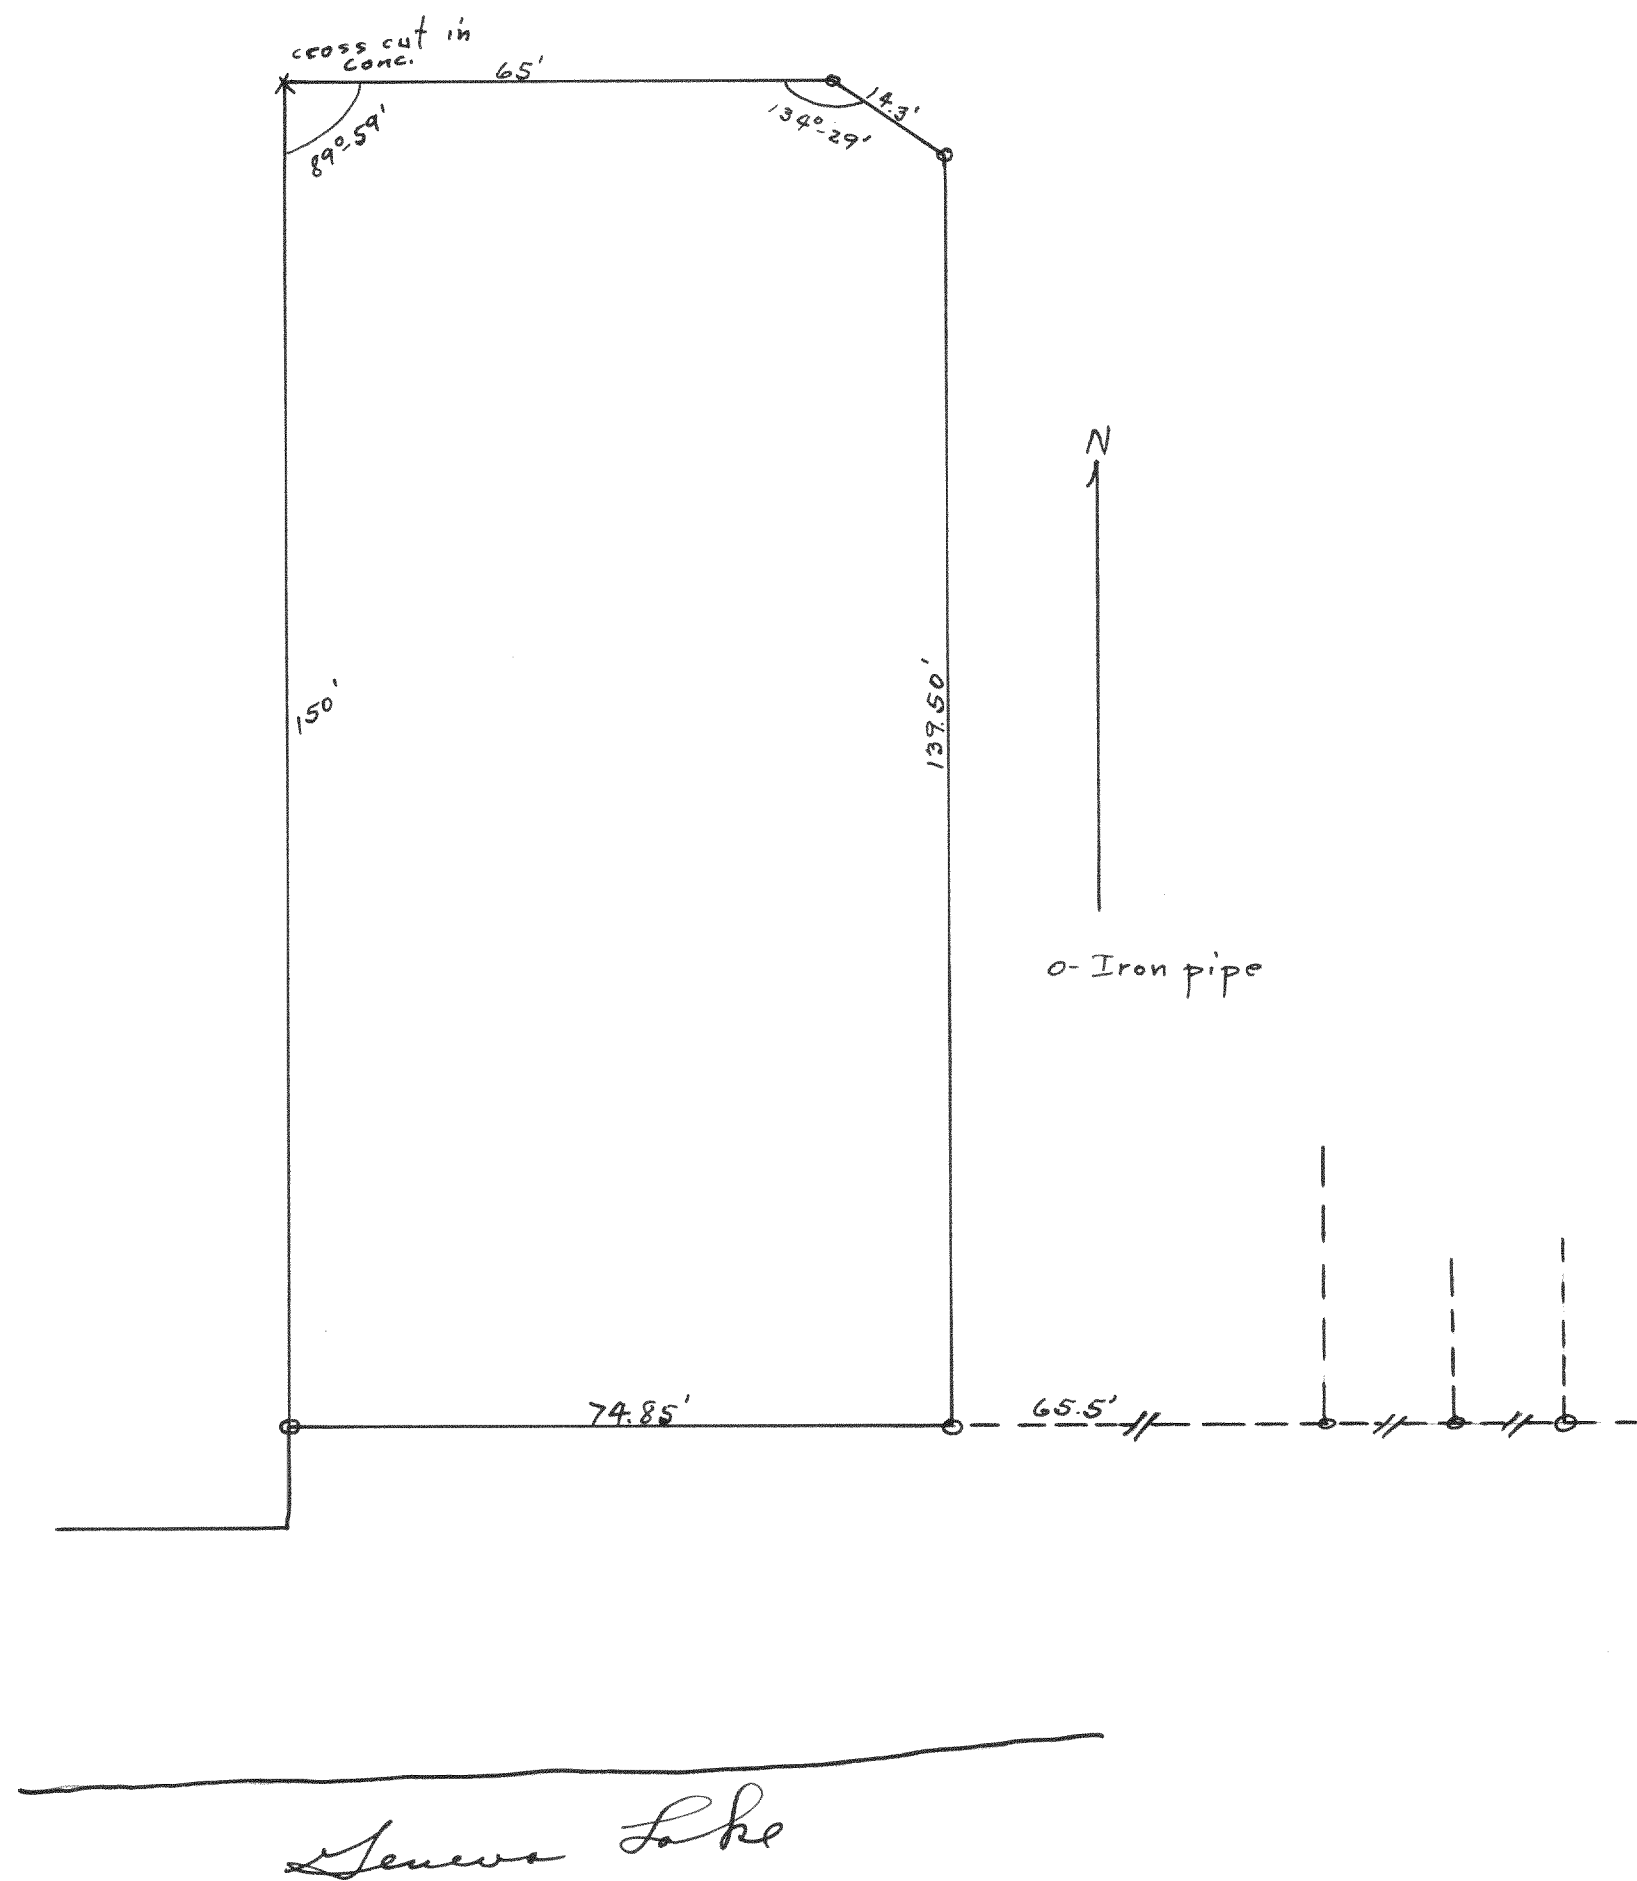


Plot of survey of lot 63 of Cedar Point Park Subdivision, Williams Bay Wis.

Dec. 1945

Lloyd L. Jensen
County Surveyor

#1529

N ←

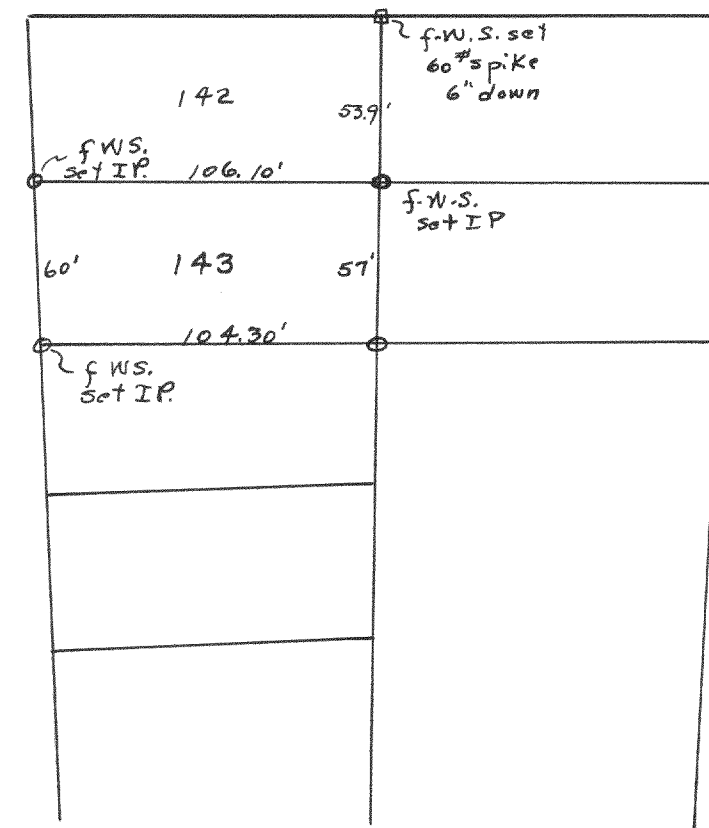


Plot of survey of lot 143 of 2nd Add. to Cedar Point Park Subd.

Lloyd L. Jensen
Co. Surveyor

Oct. 1945.

#1530

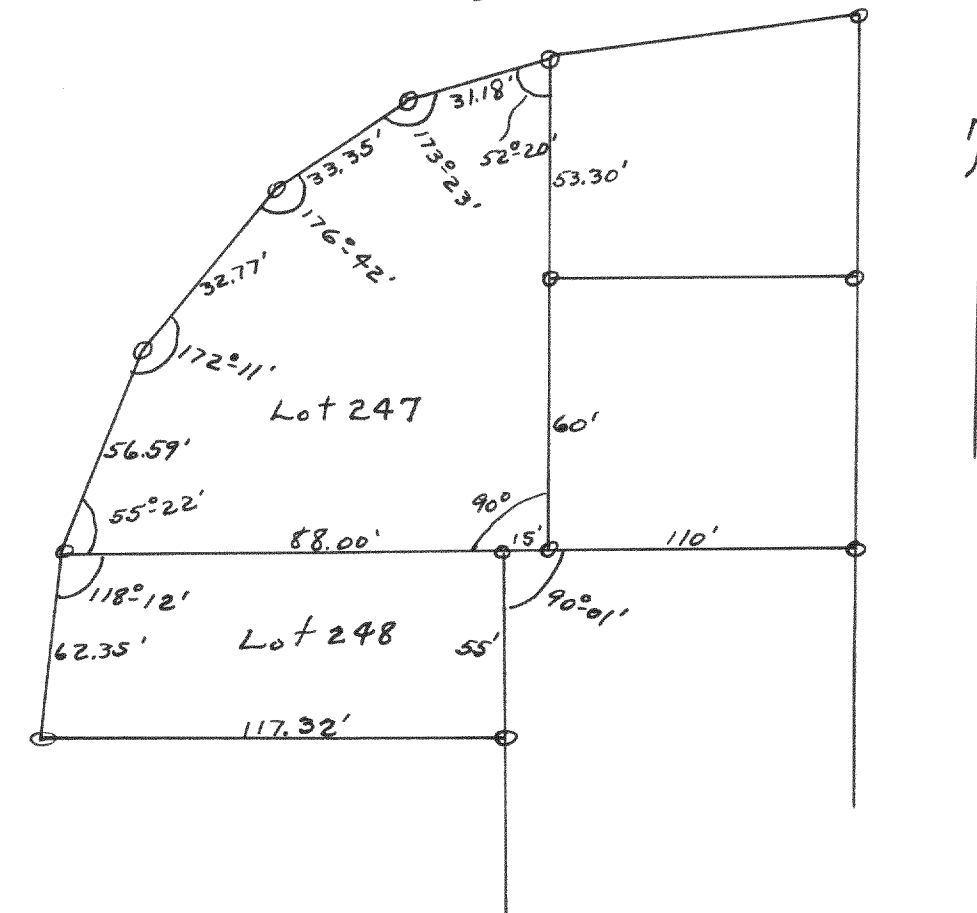

Plot of survey of lots 247 and 248 of the 3rd Addition to Cedar Point Park Subd.

Oct. 1945

Lloyd L. Jensen
County Surveyor