


#1577

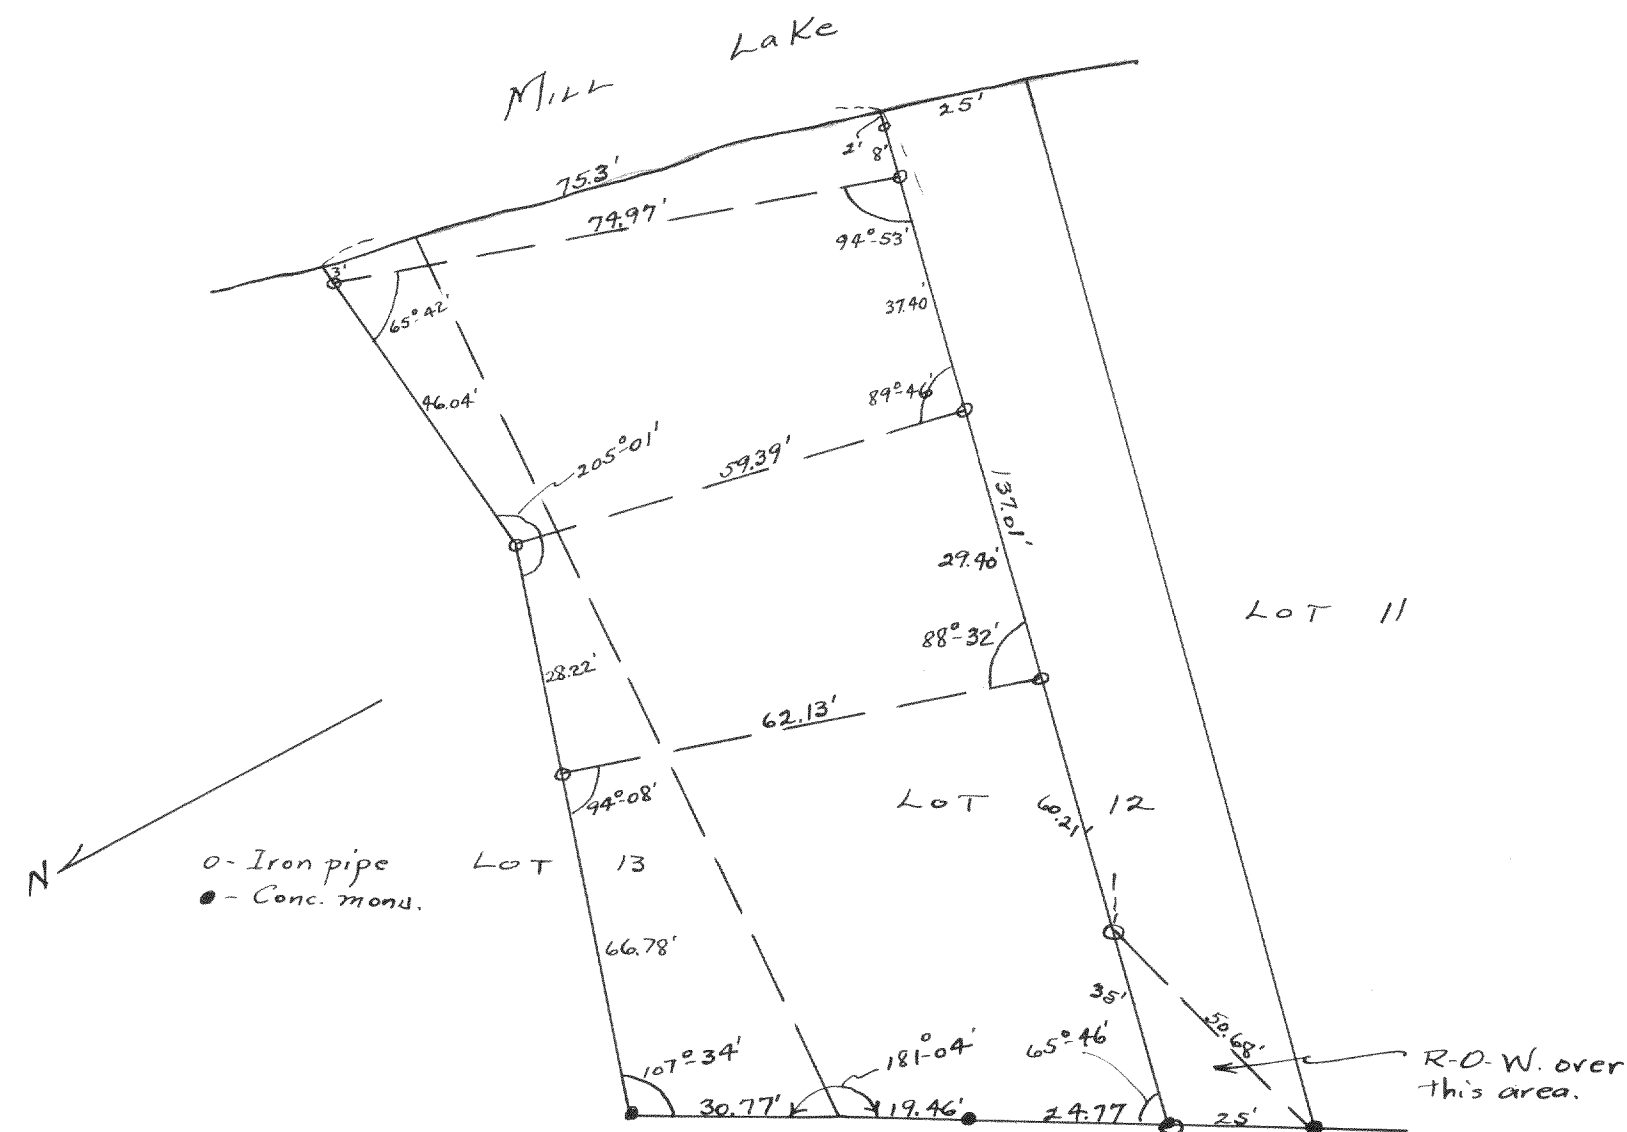


Plot of survey of part of lots 12 and 13 of
Millsite Subdivision, located in Section 4,
T47N R18E.

Oct. 1945

Lloyd L. Jensen
County Surveyor

#1578

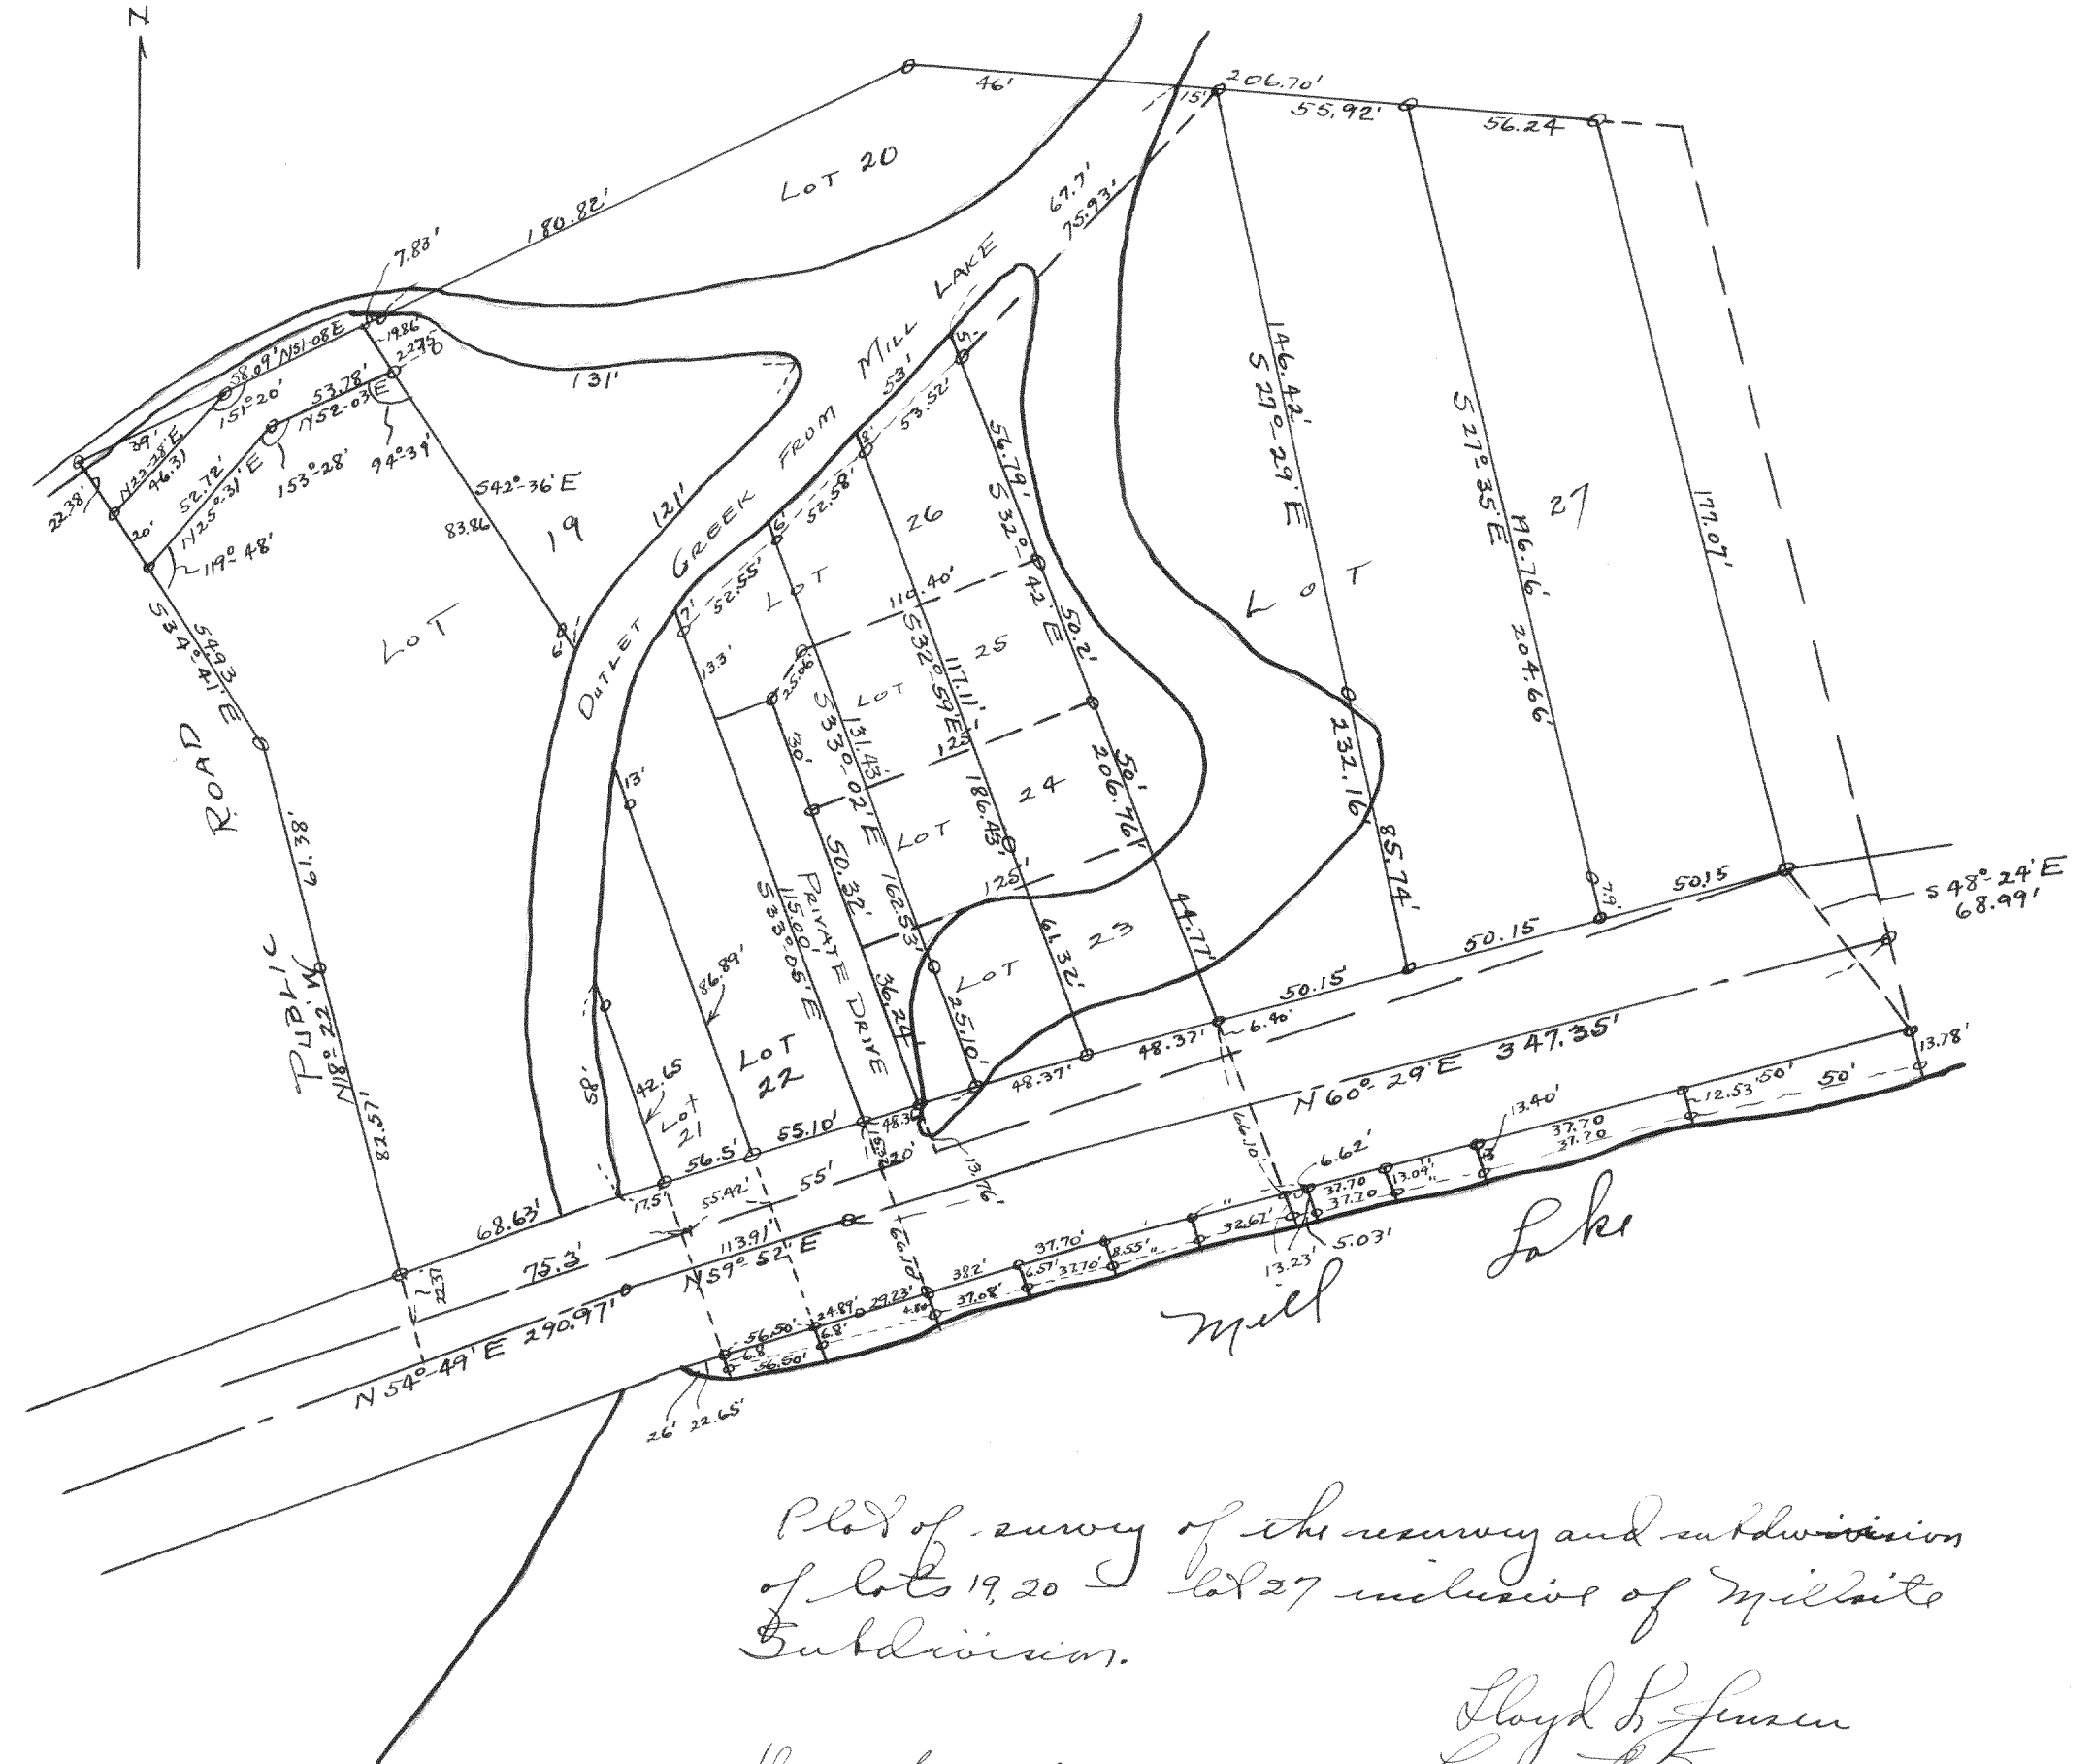

Plot of survey of the survey and subdivision
of lots 19, 20 & lot 27 inclusive of Millsite
Subdivision.

December 1945

Lloyd L. Jensen
County Surveyor